

branda.focht@claytonhomes.com

**Franklin County Health Department
Division of Environmental Health
107 Industrial Drive-Suite C
Louisburg, North Carolina 27549**

PAGE 1 OF 2

Phone: 919-496-8100

SEPTIC PERMIT

Fax: 919-496-8136

Permit Number: 11105 Type: I PIN: 2856-01-1250 Date: 5/15/2019

Applicant: CLAYTON HOMES
1582 US 1 HWY
YOUNGSVILLE, NC 27596

Owner: WILLIE & EMILY BARTHOLOMEW
1802 WHITE LEVEL RD
LOUISBURG, NC 27549

Telephone: (919) 570-3366

Telephone:

Subdivision:

Lot Number:

Size: 2.880

Physical Address/ Location /Directions 525 EARLIE COLLINS RD

Description: LifeTime _____ 5 Year ☒

TYPE FACIL SFD # EMPLOY _____ # BEDRMS 4 GPD 480 LTAR 13

TYPE WAT Private TYPE SYS C/A TYPE REP C/A BSMT No BST FX N/A

SIZE TANK 1000 SIZE CHB N/A SIZE NITR 3'x535' MTD 30"

COMMENTS: Maintain setbacks. Install on contour. Many use 3'x400' accepted
drainage.

Septic Contractors are responsible for notifying the health department for final inspections, between 8:00-9:00 AM on the day of completion, Monday - Friday. Any request for final inspections received afterwards will be scheduled the same day, if possible, or the next workday. Have permit number and owner/applicant's name ready when making the call.

Actions of representatives of state or local agencies engaged in the evaluation and determination of measures required to effect the compliance with the provisions of this permit shall in no way be taken as a guarantee that wastewater disposal systems permitted and approved will function in a satisfactory manner for any given period of time, or that such employees assume any liability for damages, consequential or direct which are caused, or may be caused, by a malfunction of this wastewater treatment and disposal system.

Proper precautions must be taken to assure the proper functioning of the system after it has been covered. Do not run any heavy equipment over the system, as soft earth will allow damage to the tank and lines. Pipe all roof drains away from the septic system site to prevent flooding of the lines from surface water. Terrace the ground to prevent excessive drainage from higher areas adjacent to the system. Do not construct driveways over any part of the septic system unless proper provisions were made when the septic system was constructed. Only grass, not trees or shrubbery, should be cultivated over the lines. All plumbing fixtures should be carefully inspected periodically and any problems repaired immediately. All septic tanks should be pumped off by a permitted pump operator on a regular schedule, not to exceed every five years.

The improvement permit and construction authorization is a site approval, for the future installation of a wastewater treatment and disposal system. Changes in ownership of the site do not affect the validity of this permit. However, any alteration of the site or soil conditions, changes in the location of the proposed facility, changes to the wastewater flow and/or characteristics, or submittal of false information with the application or misrepresentation of the property lines may subject this permit to suspension or revocation.

FOR THIS TO BE A VALID CONSTRUCTION AUTHORIZATION, A LAYOUT SHEET MUST BE ATTACHED

IMPROVEMENT PERMIT

DATE 5/30/19 EHS *Shad Jensen*

CONSTRUCTION AUTHORIZATION

DATE 5/30/19 EHS *Shad Jensen*

Visit www.franklincountyenvironmentalhealth.com for permit information and tracking.

Franklin County Health Department


Name: CLAYTON HOMES

Permit Number

11105

CONTRACTOR _____ TANK MANU _____ MANU DATE _____

WELL INSTALLED YES _____ NO _____ SYSTEM CODE _____

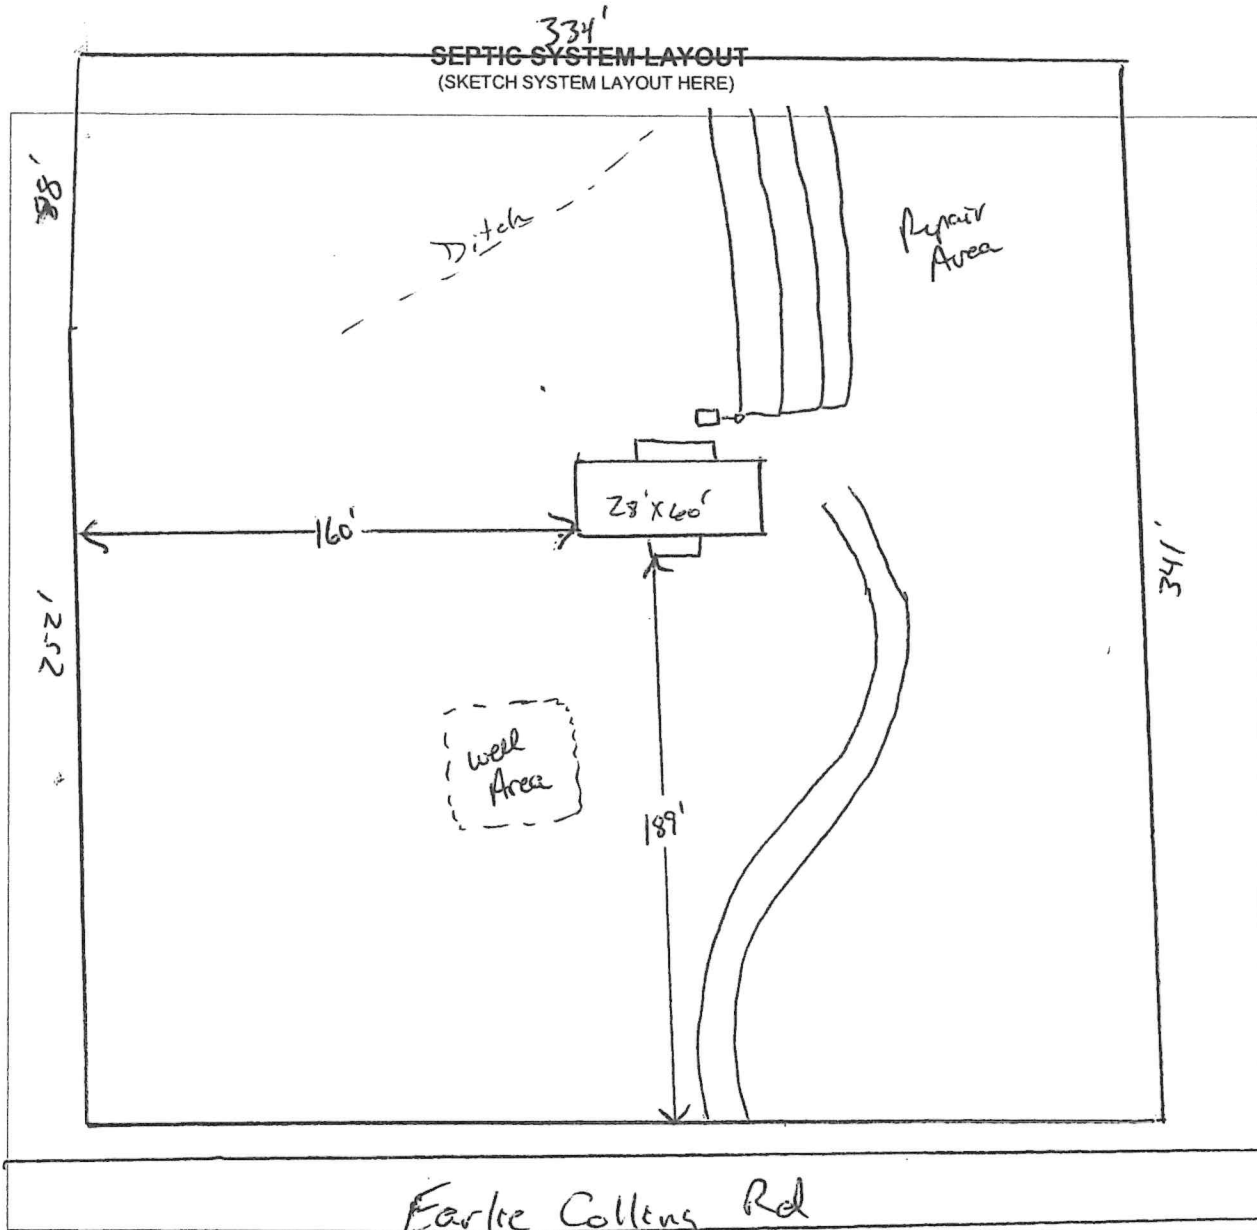

SEPTIC SYSTEM AS-BUILT
(IF DIFFERENT FROM INITIAL LAYOUT)
ON REVERSE

OPERATIONS PERMIT

DATE _____ EHS _____

OWNER: Clayton Homes APPLICATION DATE: 5/15/19
ADDRESS: _____ DATE EVALUATED: 5/30/19
PROPOSED FACILITY: SFD PROPOSED DESIGN FLOW (.1949): _____ PROPERTY SIZE: _____
LOCATION OF SITE: Easton Commons PROPERTY RECORDED: _____
WATER SUPPLY: ☒ Private ☐ Public ☒ Well ☐ Spring ☐ Other _____
EVALUATION METHOD: ☒ Auger Boring ☐ Pit ☐ Cut TYPE OF WASTEWATER: ☐ Sewage ☐ Industrial Process ☐ Mixed

P R O F I L E #	.1940 LANDSCAPE POSITION/ SLOPE %	HORIZON DEPTH (IN.)	SOIL MORPHOLOGY (.1941)		OTHER PROFILE FACTORS				PROFILE CLASS & LTAR
			.1941 STRUCTURE/ TEXTURE	.1941 CONSISTENCE/ MINERALOGY	.1942 SOIL WETNESS/ COLOR	.1943 SOIL DEPTH	.1956 SAPRO CLASS	.1944 RESTR HORIZ	
1	LS 3-6%	0-3	Gr / SL	Fr / SERP			44"		B 13
		3-48	SBK / SL	Fi / SERP					
2	LS 3-6%	0-3	Gr / SL	Fr / SERP			42"		PS .3
		3-48	SBK / C	Fi / SERP					
3									
4									

DESCRIPTION	INITIAL SYSTEM	REPAIR SYSTEM	OTHER FACTORS (.1946):
Available Space (.1945)	S	S	SITE CLASSIFICATION (.1948): <u>125</u>
System Type(s)	C/125	C/A	EVALUATED BY: <u>S. Leonard</u>
Site LTAR	13	13	OTHER(S) PRESENT: _____