

-2004 THU 03:38 PM

20 Wood IBIS

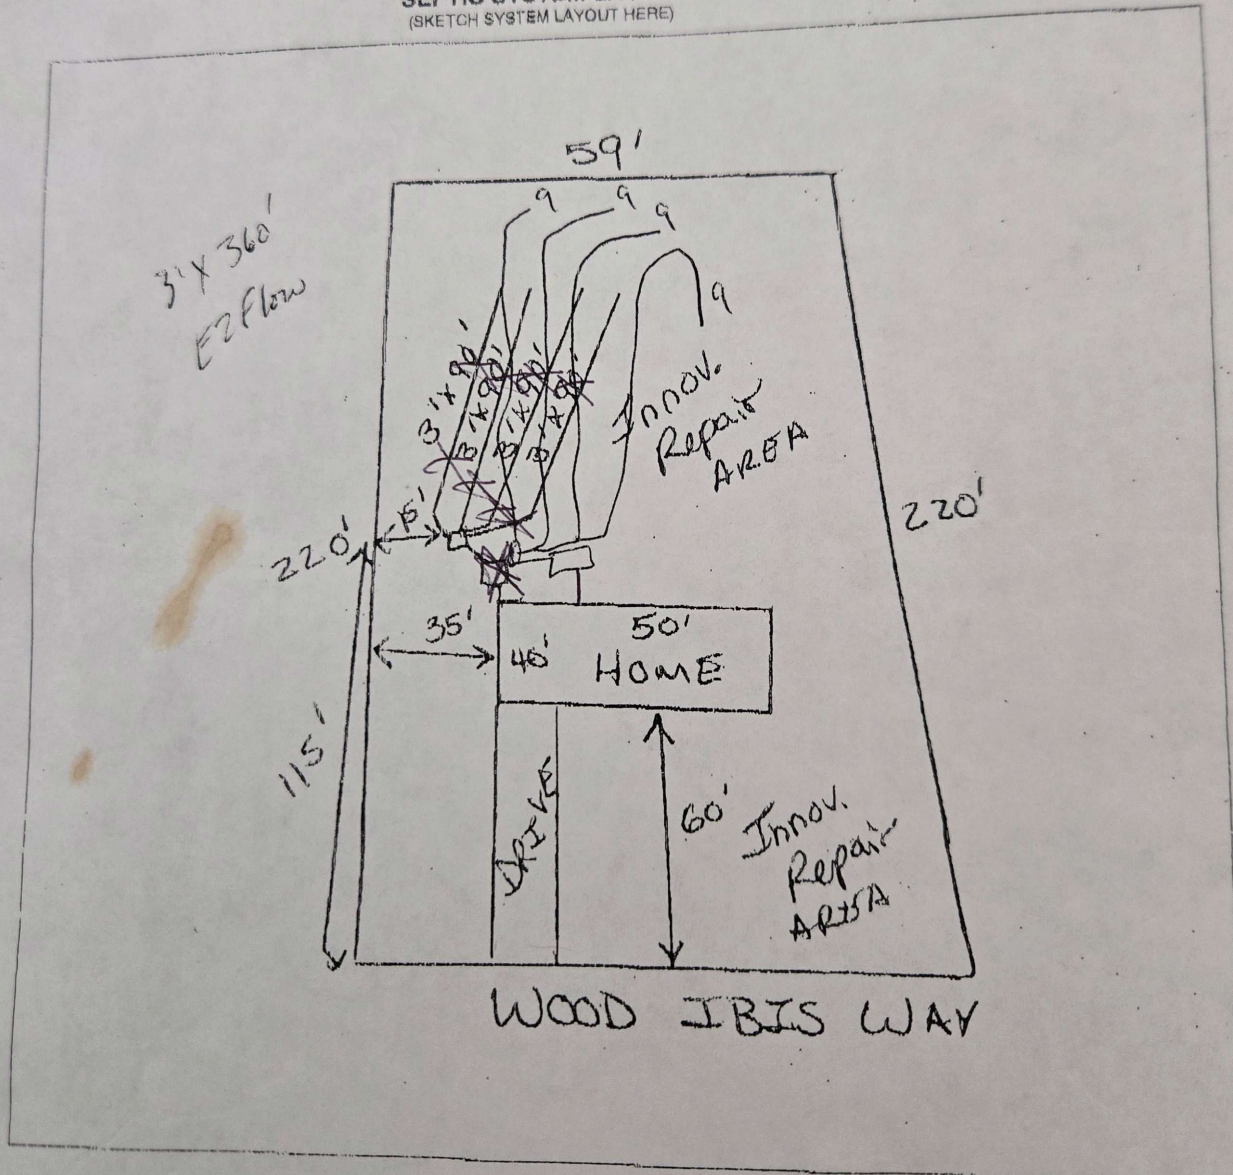
PAGE 2 OF 2

Franklin County Health Department

Permit Number

1089

Name: WIGGINS LANDING

CONTRACTOR James BaileyTANK MANU M. 11/5/00MANU DATE 9-13-05WELL INSTALLED AT TIME OF INSPECTION YES ☐ NO ☐SEPTIC SYSTEM LAYOUT
(SKETCH SYSTEM LAYOUT HERE)SEPTIC SYSTEM AS-BUILT
(IF DIFFERENT FROM INITIAL LAYOUT)
ON REVERSE

OPERATIONS PERMIT

DATE 11-10-05 EHSShad Leonard