

Fax 562-2127

919-861-8913

**Franklin County Health Department
Environmental Health Section
107 Industrial Drive-Suite C
Louisburg, North Carolina 27549**

PAGE 1 OF 2

Phone: 919-496-8100

Fax: 919-496-8136

Permit Number: 1702 Type: I PIN: 1871-10-9256 Date: 7/13/2005
Applicant: SUMNER CONSTRUCTION Owner: EDGAR/MARGARET/DEBRA STALLIN
 PO BOX 1011 1378 MOORES POND RD
 YOUNGSVILLE, NC 27596 YOUNGSVILLE, NC 27596
Telephone: (919) 422-5713 Telephone:
Subdivision: RIVER WALK Lot Number: 2 Size: .940

Physical Address/ Location /Directions 20 LITTLE RIVER CT

Description: LifeTime _____ 5 Year ☒TYPE FACIL RES # EMPLOY _____ # BEDRMS 3 GPD 360 LTAR 13TYPE WAT Priv TYPE SYS Inn TYPE REP Inn BSMT No BST FX N/ASIZE TANK 900 SIZE CHB N/A SIZE NTR 3'X30' MTD 24"COMMENTS Maintain proper setbacks. Install drainlines
on contour. Install system in dry conditions

Septic Contractors are responsible for notifying the health department for final inspections, between 8:00-9:00 AM on the day of completion, Monday - Friday. Any request for final inspections received afterwards will be scheduled the same day, if possible, or the next workday. Have permit number and owner/applicant's name ready when making the call.

Actions of representatives of state or local agencies engaged in the evaluation and determination of measures required to effect the compliance with the provisions of this permit shall in no way be taken as a guarantee that wastewater disposal systems permitted and approved will function in a satisfactory manner for any given period of time, or that such employees assume any liability for damages, consequential or direct which are caused, or may be caused, by a malfunction of this wastewater treatment and disposal system.

Proper precautions must be taken to assure the proper functioning of the system after it has been covered. Do not run any heavy equipment over the system, as soft earth will allow damage to the tank and lines. Pipe all roof drains away from the septic system site to prevent flooding of the lines from surface water. Terrace the ground to prevent excessive drainage from higher areas adjacent to the system. Do not construct driveways over any part of the septic system unless proper provisions were made when the septic system was constructed. Only grass, not trees or shrubbery, should be cultivated over the lines. All plumbing fixtures should be carefully inspected periodically and any problems repaired immediately. All septic tanks should be pumped off by a permitted pump operator on a regular schedule, not to exceed every five years.


The improvement permit and construction authorization is a site approval, for the future installation of a wastewater treatment and disposal system. Changes in ownership of the site do not affect the validity of this permit. However, any alteration of the site or soil conditions, changes in the location of the proposed facility, changes to the wastewater flow and/or characteristics, or submittal of false information with the application or misrepresentation of the property lines may subject this permit to suspension or revocation.

FOR THIS TO BE A VALID CONSTRUCTION AUTHORIZATION, A LAYOUT SHEET MUST BE ATTACHED

IMPROVEMENT PERMIT

DATE 8-16-05 EHS

CONSTRUCTION AUTHORIZATION

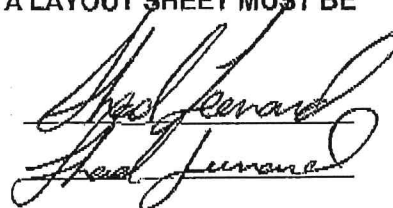DATE 8-16-05 EHS

Franklin County Health Department


Name: SUMNER CONSTRU

Permit Number

1702

CONTRACTOR Mike Brown TANK MANU 2115 1000 MANU DATE 8/14/05WELL INSTALLED AT TIME OF INSPECTION YES ☒ NO ☐SEPTIC SYSTEM LAYOUT
(SKETCH SYSTEM LAYOUT HERE)

J&J

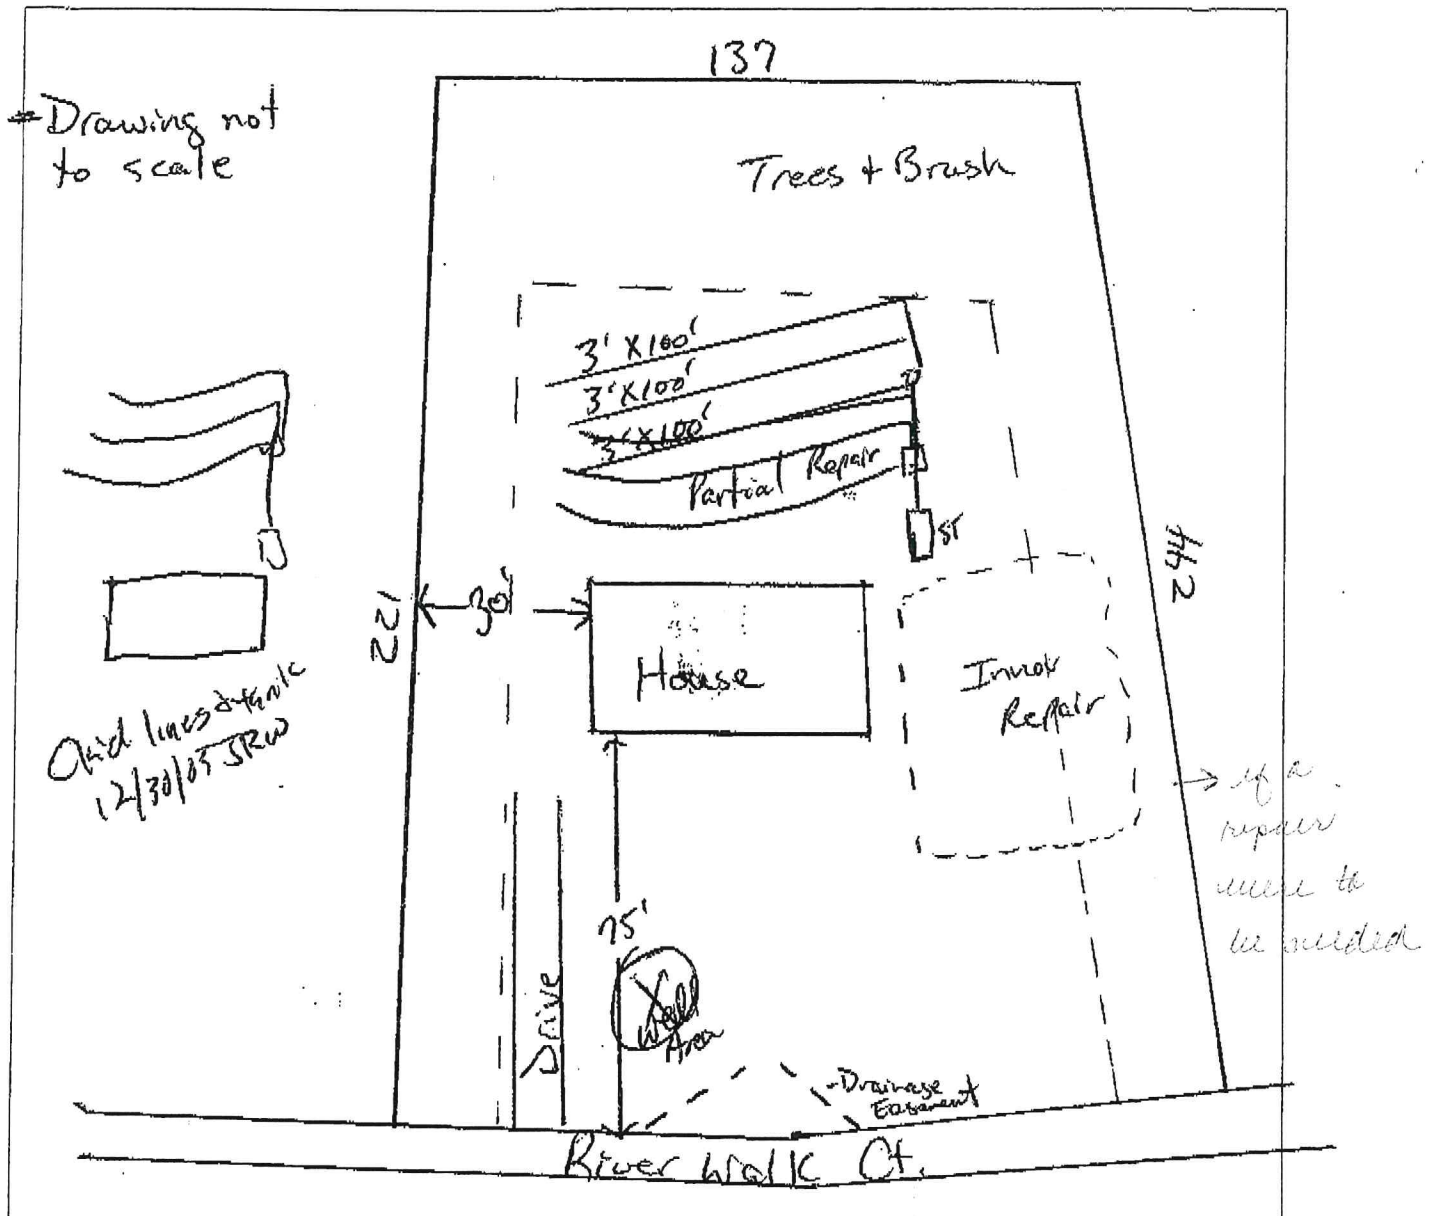

SEPTIC SYSTEM AS-BUILT

(IF DIFFERENT FROM INITIAL LAYOUT)

ON REVERSE

OPERATIONS PERMIT

DATE

1-10-06

EHS.

[Signature]