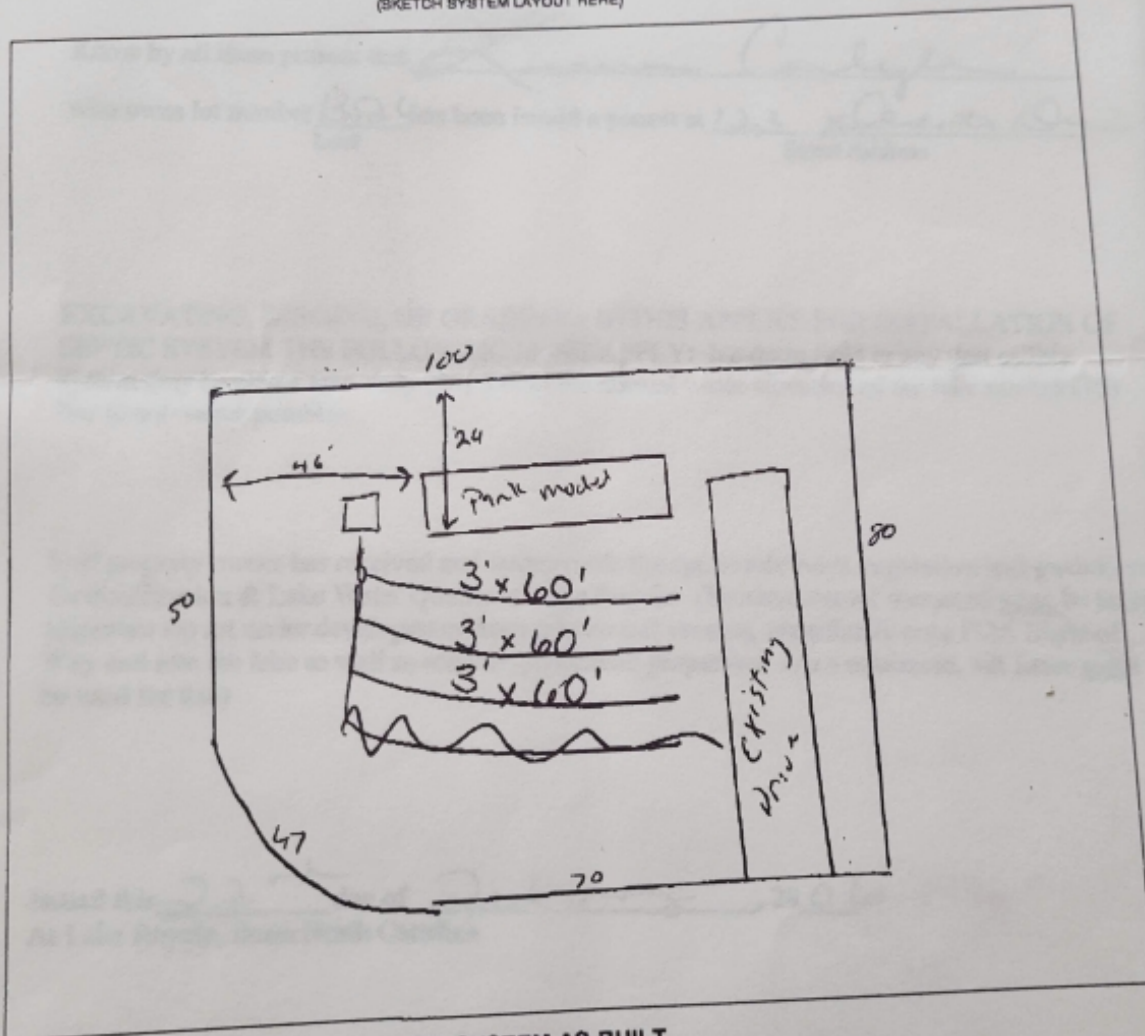


## Franklin County Health Department

Name: CARLYLE

Permit Number

2470

CONTRACTOR Garfield TANK MANU Mills 1000 MANU DATE 2-15-07  
WELL INSTALLED YES        NO ✓ SYSTEM CODE EZ1203T-N-GSEPTIC SYSTEM LAYOUT  
(SKETCH SYSTEM LAYOUT HERE)SEPTIC SYSTEM AS-BUILT  
(IF DIFFERENT FROM INITIAL LAYOUT)  
ON REVERSE

OPERATIONS PERMIT

DATE 4-18-07 EHSRenee Shear

like paperwork