

919-833-3042


FRANKLIN COUNTY HEALTH DEPARTMENT

PERMIT NUMBER: CR/ST IMPROVEMENTS PERMIT	DATE: 07.05.90	12113	SIZE: 1.010A
APPLICANT: JERRY W G 609 SHADYWOOD LANE MILLER NC 27643 TELEPHONE: 779-1147		OWNER: JERRY W GATHIS & A BUNN	
COMMENTS: MOVING HOUSE			
LOCATION / DIRECTIONS: SHADYWOOD DOWNS 400 Hwy 401 S. T/R Hwy 984 T/R Hwy 96 T/R Dogwood Downs			
FEE: 50.00		SIGNATURE OF OWNER OR AUTHORIZED AGENT:	
CONFIRMED BY PLANNER:	PLANNER: D. Hunt	DATE: 7-7-90	

THE ABOVE SIGNATURE INDICATES THAT I HAVE READ, UNDERSTAND, AND AGREE WITH ALL PROVISIONS AND INFORMATION AS OUTLINED ON THE BACK SIDE OF THIS FORM.

ABSORBS 3 DISPOSAL No OTHER TYPE SYS C
P2 TANK 900 gal S2 CHARGE NITRIFI 300X7 OPER. REQ T
SITE USE

REMARKS: Keep system shallow. Stay 10' from property line & 10' from well.
Mills STB-870
7-25-90 ~ 349 P. line

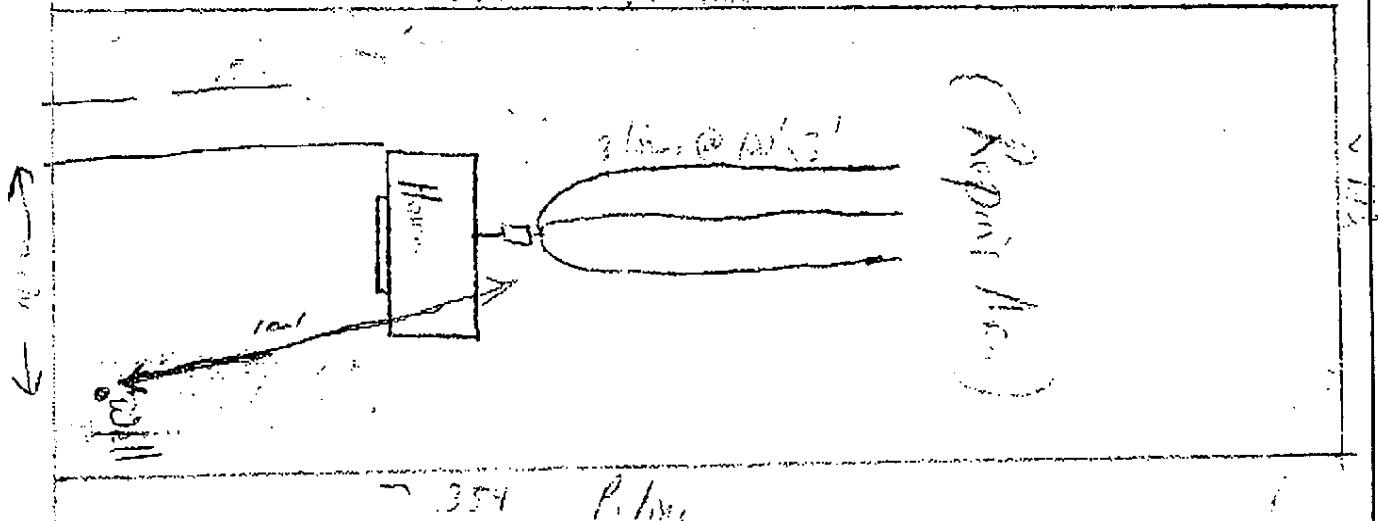

Contractor C. Bailey
DATE ISSUED 7-12-90
DATE APPROVED 10-22-90

Dr. H. H. Hunt
E.H. Specialist
E. H. Specialist
E. H. Specialist