

Franklin County Health Department
Division of Environmental Health
107 Industrial Drive-Suite C
Louisburg, North Carolina 27549

PAGE 1 OF 2

For Debra Brown SM

Phone: 919-496-8100

SEPTIC PERMIT

Fax: 919-496-8136

Permit Number: 4992 Type: I PIN : 22869-44-349 Date: 6/11/2009

Applicant: MARILYN GARDNER
2741 US HWY 1/HWY 158
HENDERSON, NC 27536

Owner: MARILYN GARDNER
2741 US HWY 1/HWY 158
HENDERSON, NC 27536

Telephone: (252) 492-5017

Telephone: (252) 492-5017

Subdivision:

Lot Number:

Size: 2.000

Physical Address/ Location /Directions VAIDEN RD

Description: LifeTime _____ 5 Year _____

TYPE FACIL SF-7 # EMPLOY ✓ # BEDRMS 4 GPD 450 LTAR .35%
TYPE WAT ACI TYPE SYS I TYPE REP Plat BSMT N BST FX N/A
SIZE TANK 11000 SIZE CHB ✓ SIZE NTR 3x350 MTD 30"

COMMENTS 350' Improvement / Accepted

Septic Contractors are responsible for notifying the health department for final inspections, between 8:00-9:00 AM on the day of completion, Monday - Friday. Any request for final inspections received afterwards will be scheduled the same day, if possible, or the next workday. Have permit number and owner/applicant's name ready when making the call.

Actions of representatives of state or local agencies engaged in the evaluation and determination of measures required to effect the compliance with the provisions of this permit shall in no way be taken as a guarantee that wastewater disposal systems permitted and approved will function in a satisfactory manner for any given period of time, or that such employees assume any liability for damages, consequential or direct which are caused, or may be caused, by a malfunction of this wastewater treatment and disposal system.

Proper precautions must be taken to assure the proper functioning of the system after it has been covered. Do not run any heavy equipment over the system, as soft earth will allow damage to the tank and lines. Pipe all roof drains away from the septic system site to prevent flooding of the lines from surface water. Terrace the ground to prevent excessive drainage from higher areas adjacent to the system. Do not construct driveways over any part of the septic system unless proper provisions were made when the septic system was constructed. Only grass, not trees or shrubbery, should be cultivated over the lines. All plumbing fixtures should be carefully inspected periodically and any problems repaired immediately. All septic tanks should be pumped off by a permitted pump operator on a regular schedule, not to exceed every five years.

The improvement permit and construction authorization is a site approval, for the future installation of a wastewater treatment and disposal system. Changes in ownership of the site do not affect the validity of this permit. However, any alteration of the site or soil conditions, changes in the location of the proposed facility, changes to the wastewater flow and/or characteristics, or submittal of false information with the application or misrepresentation of the property lines may subject this permit to suspension or revocation.

FOR THIS TO BE A VALID CONSTRUCTION AUTHORIZATION, A LAYOUT SHEET MUST BE ATTACHED

IMPROVEMENT PERMIT

DATE 6/12/09 EHS [Signature]

CONSTRUCTION AUTHORIZATION

DATE 6/12/09 EHS [Signature]

Visit www.franklincountyenvironmentalhealth.com for permit information and tracking.

Franklin County Health Department

Name: GARDNER

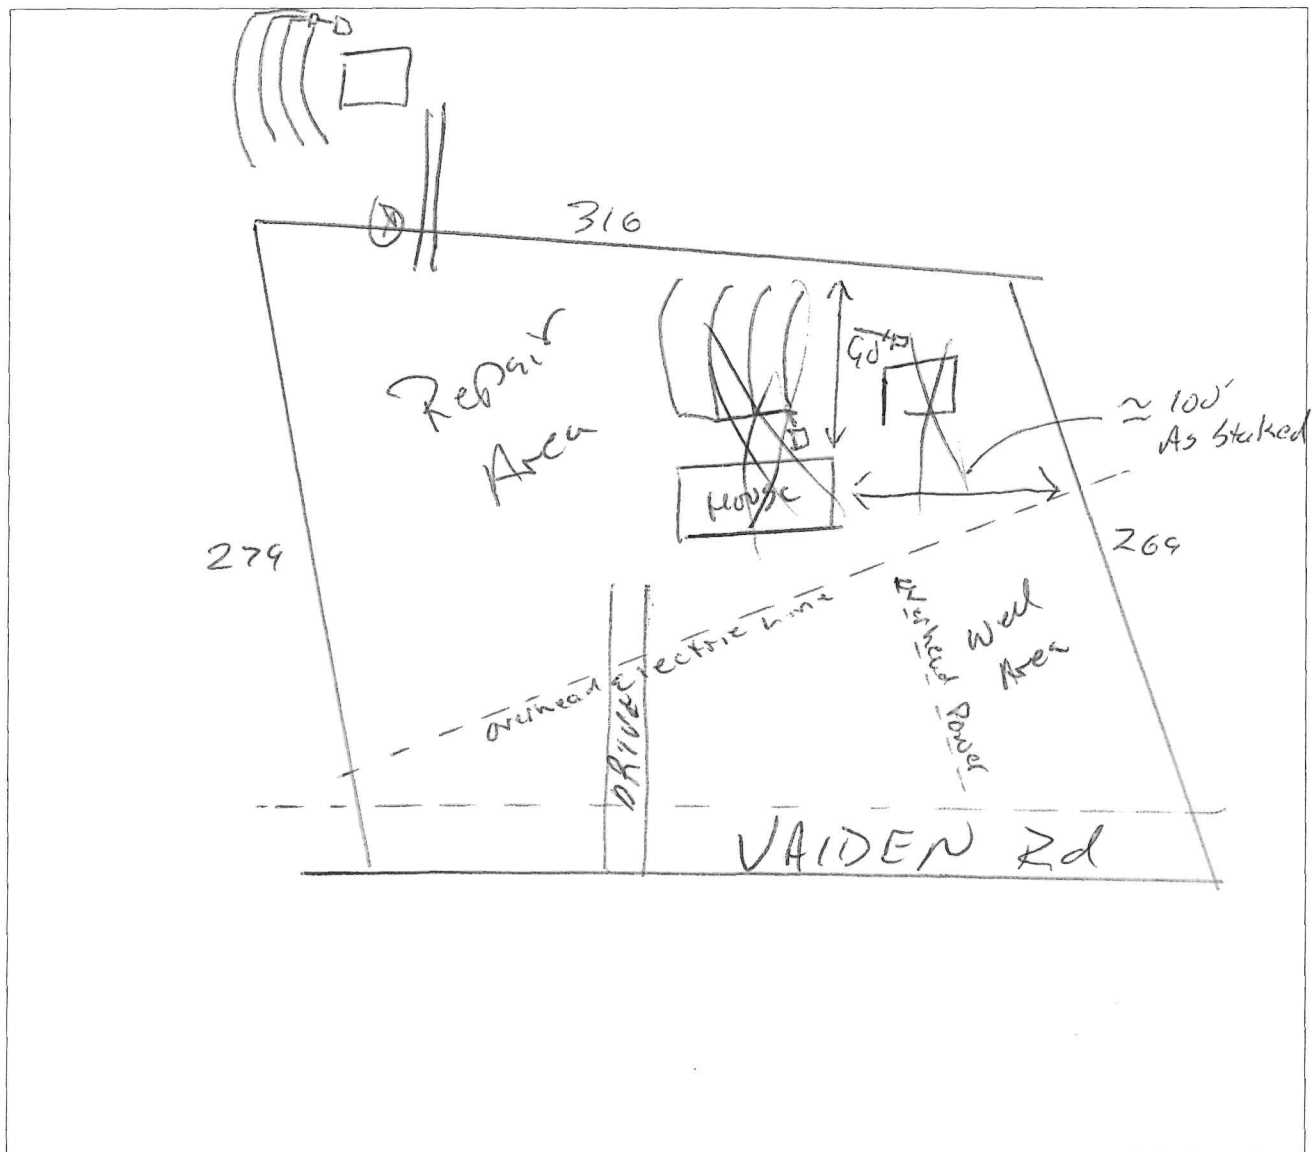
Permit Number

4992

CONTRACTOR Lin Cole TANK MANU EN13 1700 MANU DATE 7/16/9WELL INSTALLED YES X NO SYSTEM CODE GTR

SEPTIC SYSTEM LAYOUT

(SKETCH SYSTEM LAYOUT HERE)



SEPTIC SYSTEM AS-BUILT

(IF DIFFERENT FROM INITIAL LAYOUT)

ON REVERSE

OPERATIONS PERMIT

DATE

3/24/10

EHS

Franklin County Health Department
Division of Environmental Health
107 Industrial Drive-Suite C
Louisburg, North Carolina 27549

PAGE 1 OF 2

Phone: 919-496-8100

Well Permit

Fax: 919-496-8136

Permit Number: 4992 Type: N PIN : 22869-44-349 Date: 6/11/2009

Applicant: MARILYN GARDNER
2741 US HWY 1/HWY 158
HENDERSON, NC 27536

Owner: MARILYN GARDNER
2741 US HWY 1/HWY 158
HENDERSON, NC 27536

Telephone: (252) 492-5017

Telephone: (252) 492-5017

Subdivision:

Lot Number:

Size: 2.000

Physical Address/ Location /Directions VAIDEN RD

WELL INFORMATION:

WELL TYPE: Drilled D WELL DEPTH: 125' FT WELL YIELD: 10 GPM
STAT LEVEL: 30 FT CASE TYPE: one (sandy) stone R CASE DEPTH: 52' FT

COMMENTS

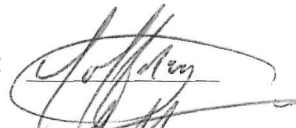
Well drilling contractors are responsible for notifying the Health Department for grouting inspections. The well driller or pump installer is responsible for requesting the well head inspection. Calls must be made to the Health Department between 8:00-9:00 AM on the day of the inspection, Monday-Friday. Any request for grouting or well head inspections requested afterwards will be scheduled the same day, if possible, or the next workday. Have permit number and owner/applicants name ready when making the call.

Actions of representatives of state or local agencies engaged in the evaluation and determination of measures required to effect the compliance with the provisions of this permit shall in no way be taken as a guarantee as to the quality or quantity of water produced by the well.

A well construction permit or repair permit shall be valid for a period of five years, except that the Health Department may revoke a permit, at any time, if it determines that there has been a material change in any fact or circumstance upon which the permit is issued. The validity of a construction permit or repair permit shall not be affected by a change in ownership of the site on which a private drinking water well is proposed to be located. The Health Department may suspend or revoke any permits issued upon a determination that the provisions of these regulations have been violated.

CONSTRUCTION AUTHORIZATION

DATE: 6/12/09

EHS: 

GROUT INSPECTION

DATE: 3/1/10

EHS: 

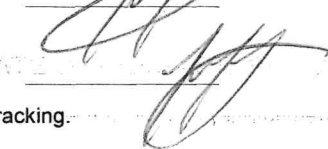
WELL HEAD INSPECTION

DATE: 3/9/10

EHS: 

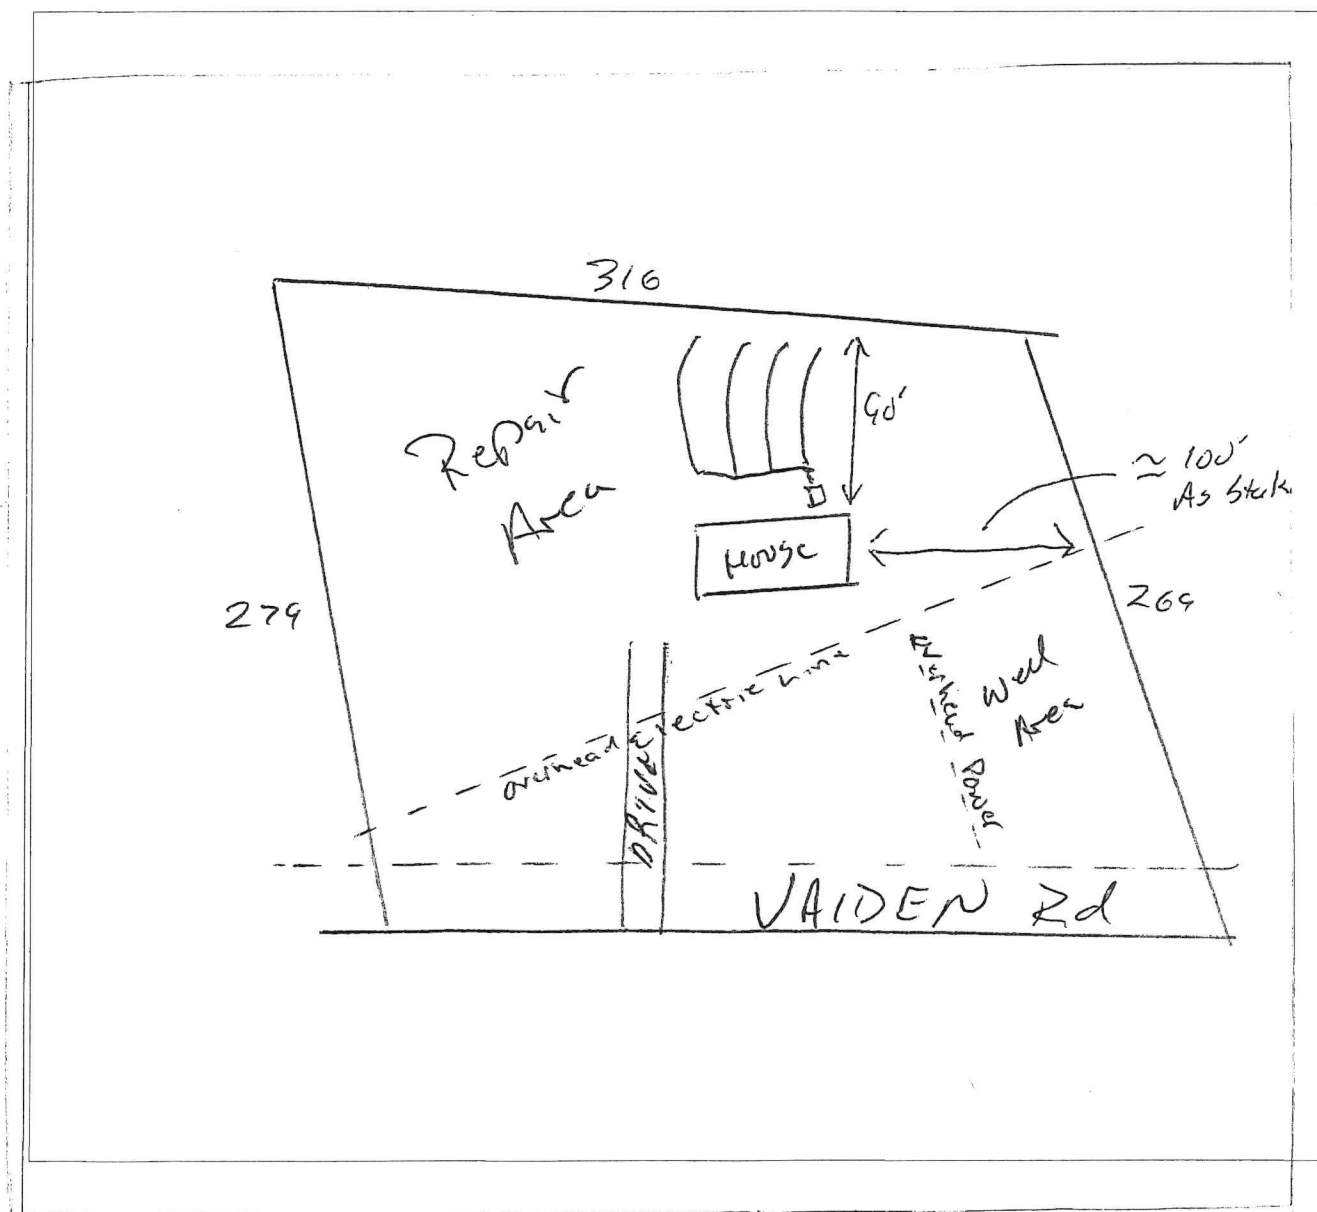
CERTIFICATE OF COMPLETION

DATE: 3/9/10

EHS: 

Franklin County Health DepartmentName: GARDNERPermit Number 4992LOCATION LAT N 36 ° ' LONG W 78 ° 0 'WELL DRILLING CONTRACTOR: Stephenson REG #: 4992 0

PUMP INSTALLER: _____ REG #: _____ 0

SEPTIC SYSTEM LAYOUT AND WELL LOCATION



RESIDENTIAL WELL CONSTRUCTION RECORD

North Carolina Department of Environment and Natural Resources- Division of Water Quality

WELL CONTRACTOR CERTIFICATION # 2423-A

1. WELL CONTRACTOR:

James D Stephenson Sr.

Well Contractor (Individual) Name

Stephenson's Well Drilling, Inc.

Well Contractor Company Name

1158 Cash Road

Street Address

Creedmoor

NC

27522

City or Town

State

Zip Code

(919) 528-1679

Area code Phone number

2. WELL INFORMATION:

WELL CONSTRUCTION PERMIT# #4992

OTHER ASSOCIATED PERMIT#(if applicable)

SITE WELL ID # (if applicable)

3. WELL USE (Check Applicable Box): Residential Water Supply ☒

DATE DRILLED 3-1-10

TIME COMPLETED 11 AM ☒ PM ☐

4. WELL LOCATION:

CITY: LOUISBURG COUNTY: FRANKLIN

VAIDEN RD.

(Street Name, Numbers, Community, Subdivision, Lot No., Parcel, Zip Code)

TOPOGRAPHIC / LAND SETTING: (check appropriate box)

☐ Slope ☐ Valley ☒ Flat ☐ Ridge ☐ Other

LATITUDE 36° 12' 22.3" DMS OR 3X.XXXXXXXX DD

LONGITUDE 78° 06' 22.4" DMS OR 7X.XXXXXXXX DD

Latitude/longitude source: ☒ GPS ☐ Topographic map

(location of well must be shown on a USGS topo map and attached to this form if not using GPS)

5. WELL OWNER

OAKWOOD HOMES

Owner Name

2741 U.S.#1 Hwy. 158

Street Address

HENDERSON

N.C.

27536

City or Town

State

Zip Code

252 492-5017

Area code Phone number

6. WELL DETAILS:

a. TOTAL DEPTH: 125'

b. DOES WELL REPLACE EXISTING WELL? YES ☐ NO ☒

c. WATER LEVEL Below Top of Casing: 30 FT.
(Use "+" if Above Top of Casing)

d. TOP OF CASING IS 1 FT. Above Land Surface*
*Top of casing terminated at/or below land surface may require a variance in accordance with 15A NCAC 2C .0118.

e. YIELD (gpm): 10 METHOD OF TEST Gauge

f. DISINFECTION: Type HTH Amount 1 lb.

g. WATER ZONES (depth):

Top 6.5 Bottom 6.5 Top Bottom

Top Bottom Top Bottom

Top Bottom Top Bottom

Top Bottom Top Bottom

7. CASING: Depth Diameter Thickness/Weight Material

Top 0 Bottom 56 Ft. 6 1/8 SDR21 PVC

Top 56 Bottom 58 Ft. 6 1/8 188 GAU

Top Bottom Ft. Material

8. GROUT: Depth Material Method

Top 0 Bottom 20 Ft. Concrete Pour

Top Bottom Ft. Method

Top Bottom Ft. Method

9. SCREEN: Depth Diameter Slot Size Material

Top N/A Bottom Ft. in. in.

Top Bottom Ft. in. in.

Top Bottom Ft. in. in.

10. SAND/GRAVEL PACK:

Depth Size Material

Top N/A Bottom Ft. Material

Top Bottom Ft. Material

Top Bottom Ft. Material

11. DRILLING LOG

Top Bottom Formation Description

0 1 TOP SOIL

1 1.52 RED SOIL

52 1.25 ROCK

Formation Description

Formation Description

12. REMARKS:

I DO HEREBY CERTIFY THAT THIS WELL WAS CONSTRUCTED IN ACCORDANCE WITH 15A NCAC 2C, WELL CONSTRUCTION STANDARDS, AND THAT A COPY OF THIS RECORD HAS BEEN PROVIDED TO THE WELL OWNER.

James D Stephenson Sr. 3-1-10
SIGNATURE OF CERTIFIED WELL CONTRACTOR DATE

James D Stephenson Sr.

PRINTED NAME OF PERSON CONSTRUCTING THE WELL

Submit within 30 days of completion to: Division of Water Quality - Information Processing,
1617 Mail Service Center, Raleigh, NC 27699-1617, Phone : (919) 807-6300

Form GW-1a
Rev. 2/09

4992

COUNTY OF FRANKLIN

ENVIRONMENT HEALTH APPLICATION (496-8100)

Permit #: 25825

Permit Type: WELL/SEPTIC

Date Issued: 06/10/2009

Project Address: VAIDEN RD,

Location: VAIDEN RD

Size #: 2.000

Subdivision:

Lot #:

Applicant: GARDNER MARILYN
2741 US HWY 1/HWY 158
HENDERSON NC 27536

Phone: 252.492.5017

Owner Name: GARDNER MARILYN

Phone:

Owners Address:

Tax record: 40970

Pin #: 2869-44-3493

Parcel #: N01 00 084A

Zoned: A R

Setbacks Front: 30

Rear: 25

Side: 10

Proposed Use: DOUBLEWIDE

of bedrooms: 4

of people: 3

Township: GOLD MINE

Public Water/Sewer: PRIVATE

ST Road #:

Desc:

Fees Due: \$650.00

Date Paid: 06/10/2009

*** Please complete all sections below***

☐ Yes ☒ No Does this site contain any previously identified jurisdictional wetlands?
☐ Yes ☒ No Is any wastewater, other than domestic, going to be generated?
☐ Yes ☒ No Is the site subject to approval by any other public agency?

*If the answer to any of the above is "yes", applicant must submit supporting documentation.

Please indicate desired system type(s). Systems can be ranked in order of preference.

☒ Conventional ☐ Accepted ☐ Modified Conventional ☐ Alternative
☐ Other ☐ No Preference

Call Environmental Health (919.496.8100) between 8:00 - 9:00 am Monday - Friday in order to schedule an appointment with an environmental health specialist for your lot evaluation. This application for an improvement permit/construction authorization and well permit does not constitute approval for zoning, septic or building permits. It will be necessary to meet all guidelines for zoning, septic and building permits prior to construction. The permit is valid for either 60 months or without expiration, depending upon documentation submitted. (complete site plan= 60 months---complete surveyed plat=without expiration.)

Please contact the Environmental Health Department at 919.496.8100 or visit their website at www.franklincountyenvironmentalhealth.com to determine the status of your application prior to contacting the Planning & Inspections Department.

I hereby certify that I am the owner, or authorized by the owner to act as his/her legal representation. Furthermore, as legal representative (if applicable) I have advised the owner of my intention to apply for this wastewater treatment and disposal system and drinking water and well system permit.

I also certify that all of the statements made in this application and any attached documents are true, complete, and correct, to the best of my knowledge and belief, and are made in good faith. If information in this application for these improvements is falsified, changed or site is altered, then improvement permits and authorization to construct these improvements shall become invalid. Authorized county representatives are granted right of entry to make these evaluations or inspections, and to release information upon public request.

X Erwin R Faulkner 

06/10/2009

Print & Signature of Owner or Owner's Legal Representative

Franklin County DRC Permit

RESIDENTIAL

Zoning Permit #: 14616



ADDRESS: VAIDEN RD

PARCEL NO.: 2869-44-3493

ZONING: A R

SUBDIVISION:

ISSUED TO: GARDNER MARILYN
2741 US HWY 1/HWY 158
HENDERSON, NC 27536

PHONE NUMBER: 252-492-5017

SETBACK: FRONT: 30 RIGHT: 10 LEFT: 10 REAR: 25

COUNTY WATER: NO FLOODPLAIN: NO MISC FEE:

PERMIT TYPE: ZONING PERMIT

TYPE OF CONSTRUCTION: DOUBLEWIDE - NEW SEPTIC

PERMIT DATE: 06/10/2009 WATERSHED NO

TOWNSHIP GOL EXPIRE DATE: 12/10/2009

It is hereby certified that the above use as shown on the plats and plans submitted with this application conforms with all applicable provisions of the Franklin County Zoning Ordinance. The issuance of this application does not allow the violation of Franklin County Zoning Ordinance or other governing regulations. The applicant is responsible for obtaining a building permit (if required) prior to commencing work on the proposed improvement. A final zoning inspection must be scheduled by the applicant.

NOTES:

I hereby certify that all information I have provided to the Planning Department is true and accurate.

APPLICANTS SIGNATURE:

UTILITY COMPANY: PROGRESS ENERGY WAKE ELECTRIC OTHER

NUMBER OF STORIES: 1 _____ 1 1/2 _____ 2 _____ 2 1/2 _____

SQUARE FOOTAGE: HEATED _____ UNHEATED _____ TOTAL _____

BASEMENT: YES _____ NO _____

FIREPLACE: NO _____ MASONARY _____ MANUFACTURED _____

PLAN SETS: MODULAR _____ STICKBUILT _____

NAME OF:

ELECTRICIAN: _____ MECHANICAL: _____

PLUMBING: _____

COST OF CONSTRUCTION: _____

NO MORE THAN 2 STRUCTURAL DEVIATIONS OR PLANS MUST BE REDRAWN

DEPARTMENTAL USE ONLY

	INITIALS (IN)	DATE	INITIALS (OUT)	DATE
ZONING		6/10/09	_____	_____
INITIAL PERMITTING	_____	_____	_____	_____
ADDRESSING	_____	_____	_____	_____
PLAN REVIEW	_____	_____	_____	_____
FIRE REVIEW	_____	_____	_____	_____
SEPTIC/SEWER	_____	_____	_____	_____
FINAL PERMITTING	_____	_____	_____	_____



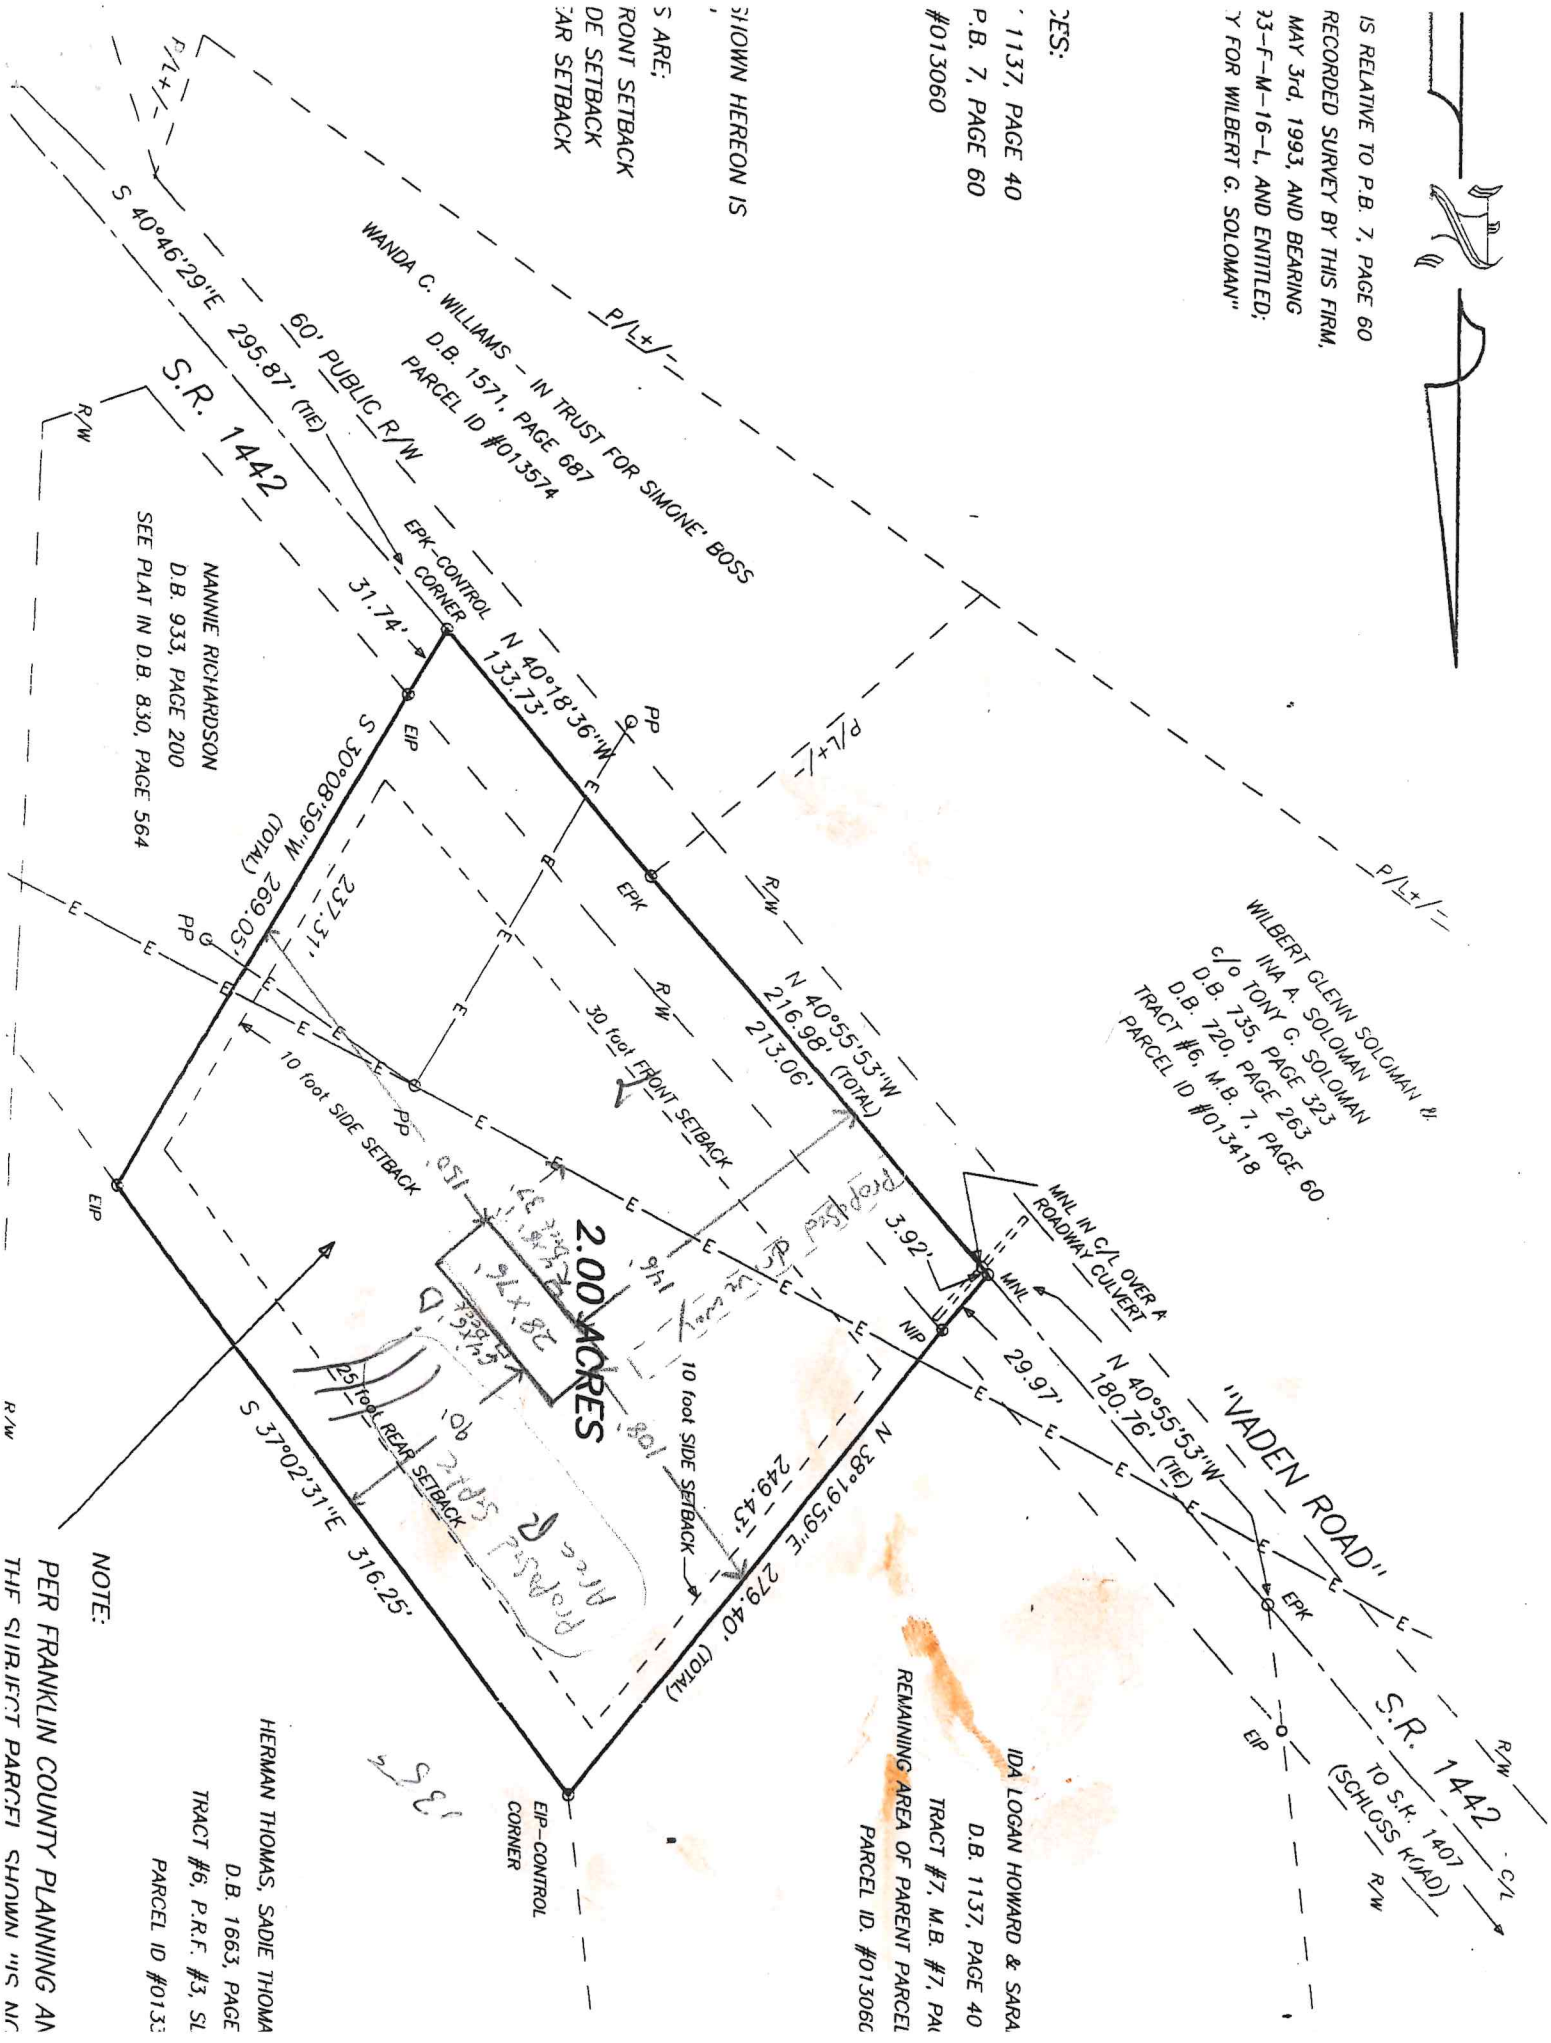
IS RELATIVE TO P.B. 7, PAGE 60
RECORDED SURVEY BY THIS FIRM,
MAY 3rd, 1993, AND BEARING
33-F-M-16-L, AND ENTITLED:
"Y FOR WILBERT G. SOLOMAN"

YES:

1137, PAGE 40
P.B. 7, PAGE 60
#013060

SHOWN HEREON IS

S ARE:
FRONT SETBACK
DE SETBACK
REAR SETBACK



WILBERT GLENN SOLOMAN
INA A. SOLOMAN
c/o TONY C. SOLOMAN
D.B. 735, PAGE 323
D.B. 720, PAGE 60
TRACT #6, M.B. 7, PAGE 60
PARCEL ID #013418

S.R. 1442
TO S.R. 1407
(SCHLOSS ROAD)

IDA LOGAN HOWARD & SARA
D.B. 1137, PAGE 40
TRACT #7, M.B. #7, PAR
REMAINING AREA OF PARENT PARCEL
PARCEL ID. #013060

HERMAN THOMAS, SADIE THOMA
D.B. 1663, PAGE
TRACT #6, P.R.F. #3, SL
PARCEL ID #013563

PER FRANKLIN COUNTY PLANNING AN
THE SUBJECT PARCELS SHOWN "S ARE"

NOTE: