

FRANKLIN COUNTY HEALTH DEPARTMENT

PERMIT NUMBER: 14785C CONST IMPROVE PERMIT 20010302	DATE: 33613	SIZE: 1, 30A
APPLICANT: LOUISBURG DEVELOPMENT CORP 7020 ZEBULON RS WAKE FOREST NC 27587	OWNER: LOUISBURG DEVELOPMENT CORP 7020 ZEBULON RS WAKE FOREST NC 27587	
TELEPHONE: 556-3020		
COMMENT: MH	DESCRIPTION: 5 YEAR ☒	LIFETIME: ☐
LOCATION / DIRECTIONS: ORCHARD HILLS #30 Off Peach Orchard Rd		
FEE: 175.00	SIGNATURE OR OWNER OR AUTHORIZED AGENT:	

THE ABOVE SIGNATURE INDICATES THAT I HAVE READ, UNDERSTAND, AND AGREE WITH ALL PROVISIONS AND INFORMATION AS OUTLINED ON THE BACK SIDE OF THIS FORM


TOPO <u>5</u>	TEXTURE <u>PS</u>	STRUCTURE <u>PS</u>	DEPTH <u>PS</u>
R. HOR <u>5</u>	SOIL. WET <u>5</u>	AVAIL. SP <u>5</u>	OTHER <u>5</u>
MINRL <u>5</u>	OVERALL <u>PS</u>	LTAR <u>.40</u>	
#BEDRMS <u>3</u>	GPD <u>360</u>	DISPOSAL <u>3'x300'</u>	TYPE. SYS <u>Conv.</u>
SZ. TANK <u>900</u>	SZ. CHAM <u>24"</u>	NITRIFI <u>5FD</u>	TYPE. WAT <u>Well</u>
SITE. LOC <u>5</u>	MAX TRENCH DEP <u>24"</u>	TYP. FAC <u>5FD</u>	

REMARKS: Stay 100' from well, 10' from property lines, 5' from foundation.
Run drainlines with contour.

CONTRACTOR: Adams Grading & Hauling

TANK MANUF: Mills 1000

MANUF DATE: 5-10-01

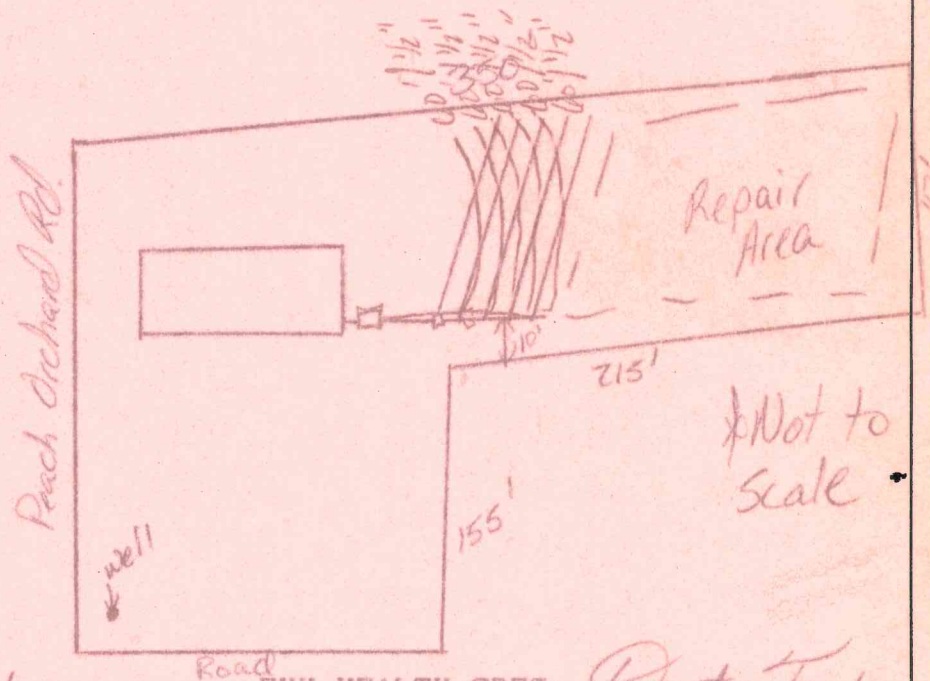

IMPROVEMENT PERMIT DATE: 3/5/01 ENV HEALTH SPEC: Denton, Franklin

CONSTRUCTION AUTHORIZATION DATE: 3/5/01 ENV HEALTH SPEC: Denton, Franklin

OPERATION PERMIT DATE: 6/25/01 ENV HEALTH SPEC: Denton, Franklin