

Fax 26 269-9752

PAGE 1 OF 2

**Franklin County Health Department
Environmental Health Section
107 Industrial Drive-Suite C
Louisburg, North Carolina 27549**

Phone: 919-496-8100

Fax: 919-496-8136

Permit Number: 2845 Type: EX PIN : Date: 7/24/2006

Applicant: JESSE R BROWN
170 FAIRWAY LANE
ZEBULON, NC 27597

Owner: JESSE R BROWN
170 FAIRWAY LANE
ZEBULON, NC 27597

Telephone:

Telephone:

Subdivision: Country Club Farms Lot Number: Size:

Physical Address/ Location /Directions 170 FAIRWAY LANE

Description: LifeTime _____ 5 Year h

TYPE FACIL Res # EMPLOY _____ # BEDRMS 3 GPD 360 LTAR _____

TYPE WAT _____ TYPE SYS CH TYPE REP CH BSMT N BST FX N/A

SIZE TANK 900 SIZE CHB _____ SIZE NITR Exist MTD 2024

COMMENTS Replace existing septic tank and drainline
that will be under addition - see diagram

Septic Contractors are responsible for notifying the health department for final inspections, between 8:00-9:00 AM on the day of completion, Monday - Friday. Any request for final inspections received afterwards will be scheduled the same day, if possible, or the next workday. Have permit number and owner/applicant's name ready when making the call.

Actions of representatives of state or local agencies engaged in the evaluation and determination of measures required to effect the compliance with the provisions of this permit shall in no way be taken as a guarantee that wastewater disposal systems permitted and approved will function in a satisfactory manner for any given period of time, or that such employees assume any liability for damages, consequential or direct which are caused, or may be caused, by a malfunction of this wastewater treatment and disposal system.

Proper precautions must be taken to assure the proper functioning of the system after it has been covered. Do not run any heavy equipment over the system, as soft earth will allow damage to the tank and lines. Pipe all roof drains away from the septic system site to prevent flooding of the lines from surface water. Terrace the ground to prevent excessive drainage from higher areas adjacent to the system. Do not construct driveways over any part of the septic system unless proper provisions were made when the septic system was constructed. Only grass, not trees or shrubbery, should be cultivated over the lines. All plumbing fixtures should be carefully inspected periodically and any problems repaired immediately. All septic tanks should be pumped off by a permitted pump operator on a regular schedule, not to exceed every five years.

The improvement permit and construction authorization is a site approval, for the future installation of a wastewater treatment and disposal system. Changes in ownership of the site do not affect the validity of this permit. However, any alteration of the site or soil conditions, changes in the location of the proposed facility, changes to the wastewater flow and/or characteristics, or submittal of false information with the application or misrepresentation of the property lines may subject this permit to suspension or revocation.

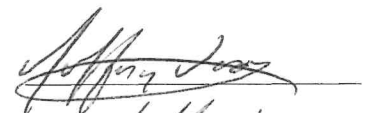
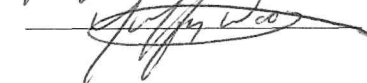
FOR THIS TO BE A VALID CONSTRUCTION AUTHORIZATION, A LAYOUT SHEET MUST BE ATTACHED

IMPROVEMENT PERMIT

DATE 7/24/06 EHS

CONSTRUCTION AUTHORIZATION

DATE 7/24/06 EHS

Franklin County Health Department

Name: BROWN

Permit Number

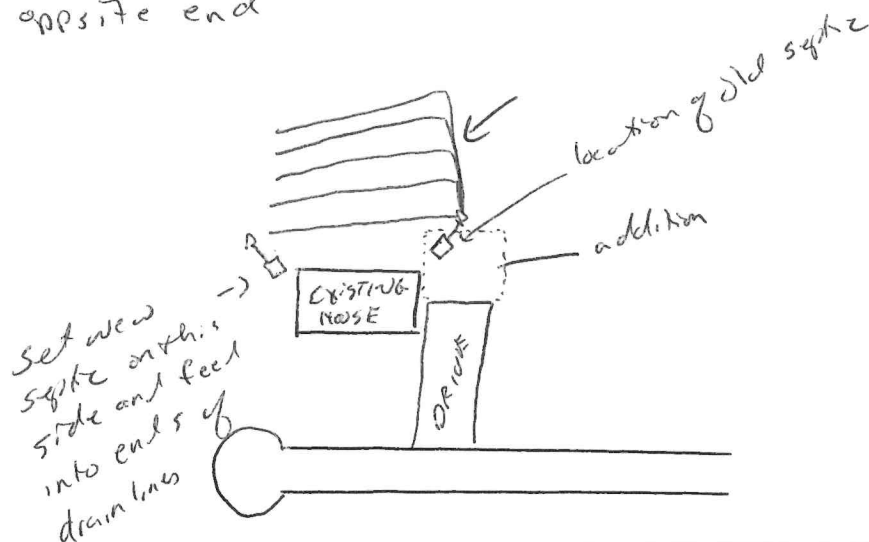
2845

CONTRACTOR Tony Rhodes TANK MANU Mills 1000 MANU DATE 7-6-06WELL INSTALLED YES ☐ NO ☐ SYSTEM CODE GTR-R-G

SEPTIC SYSTEM LAYOUT (SKETCH SYSTEM LAYOUT HERE)

* Pump/crush/fill of old septic tank - remove/block off old distribution box/supply lines - remove any part of septic system that is closer than 5' to building foundation

* Install new septic tank/Dbox/supply line at opposite end of house - keep all applicable setbacks. - Install same amount of drainline (onto the beginning of drainlines) as taken out on opposite end



SEPTIC SYSTEM AS-BUILT

(IF DIFFERENT FROM INITIAL LAYOUT)

ON REVERSE

OPERATIONS PERMIT

DATE 8-25-06 EHSRenee Shearin

FRANKLIN COUNTY

MONTH _____

MALFUNCTIONING SYSTEMS

SYSTEM CODE	AGE	INIT/REP	DIST. SYST	TEXTURE	FLOW	CAUSE CODE	LOCATION	REP/REM CODE
GTR	10	INIT	G	C	360	D	Country Club Farms	TANK

CAUSES OF MALFUNCTION

S	SITE PROBLEMS: SOIL, INFLOW, LANDSCAPE POSITION, GUTTER, ROOTS, ETC.
M	MAINTENANCE: TANK NOT PUMPED, FILTER CLOGGED, ETC.
U	USE: WATER LEAK, TOO MUCH FLOW FOR DESIGN, GREASE, ETC.
D	DAMAGED OR DESTROYED
E	EFFLUENT DISTRIBUTION DEVICE, STEP DOWN, OR DROP BOX
P	PRESSURE DOSING PROBLEMS
A	AGE
Q	COULDN'T DETERMINE

CODE TYPE OF DISTRIBUTION

G	GRAVITY
PM	PRESSURE MANIFOLD
PG	PUMP TO GRAVITY
S	SIPHON
D	DRIP
LPP	LOW PRESSURE PIPE

OTHER CODES FOR USE WITH MALFUNCTIONING SYSTEMS

EZLAY	EEZZZ LAY
TCT	TERRA COTTA TILES
TANK	SEPTIC OR PUMP TANK
GREASE	GREASE TRAP
NR	NON-REPAIRABLE
0.25	25% REDUCTION INNOV OR ACCEP
DWQ	DWQ PERMITTED SYSTEM OTHER THAN SEWER
SWR	CONNECTED TO SEWER