



Existing System Approval

Franklin County Health Department
Environmental Health Section
107 Industrial Drive
Louisburg, NC 27549
Phone: Fax:

For Office Use Only

*CDP File Number:
376515

County ID Number:

Evaluated For:
EXISTING

Permit Valid Until: 06/17/2027

Applicant: NICHOLAS MOTLUCK
Address: 1800 FLAT ROCK CHURCH RD
City: LOUISBURG
State/Zip: NC / 27549
Phone #:

Property Owner: NICHOLAS MOTLUCK
Address: 1800 FLAT ROCK CHURCH RD
City: LOUISBURG
State/Zip: NC / 27549
Phone #:

Property Location & Site Information

Address: 1800 FLAT ROCK CHURCH RD Subdivision: Phase: Lot:
Road#: NC Township:
*Structure: OTHER
of Bedrooms: 0 # of People: 0 Directions: 1800 FLAT ROCK CHURCH
*Water Supply: N/A Type of business: ACCESSORY BUILDING
Basement: ☐ Yes ☒ No Total sq. Footage: No. Of Employees:

*Proposed Improvement:

***Release Conditions:** Footings dug for new structure on site visit. Septic tank is 30 ft from structure, and top line is 45 feet from structure. Repair area would be below current system, further away from structure than initial system.

This release in no way expresses or implies that the existing subsurface sewage treatment and disposal system serving the site will continue to function for any period of time.

Applicant/Legal Reps. Signature Required? ☐ Yes ☐ No

Applicant/Legal Reps. Signature: Date:

*Issued By: Jones, Lori *Date of Issue: 06/17/2022

Authorized State Agent:

****Site Plan/Drawing attached.****


☐ Hand Drawing

☐ Import Drawing

Total Time: (HH:MM)

Hours Minutes

Activity Code: -

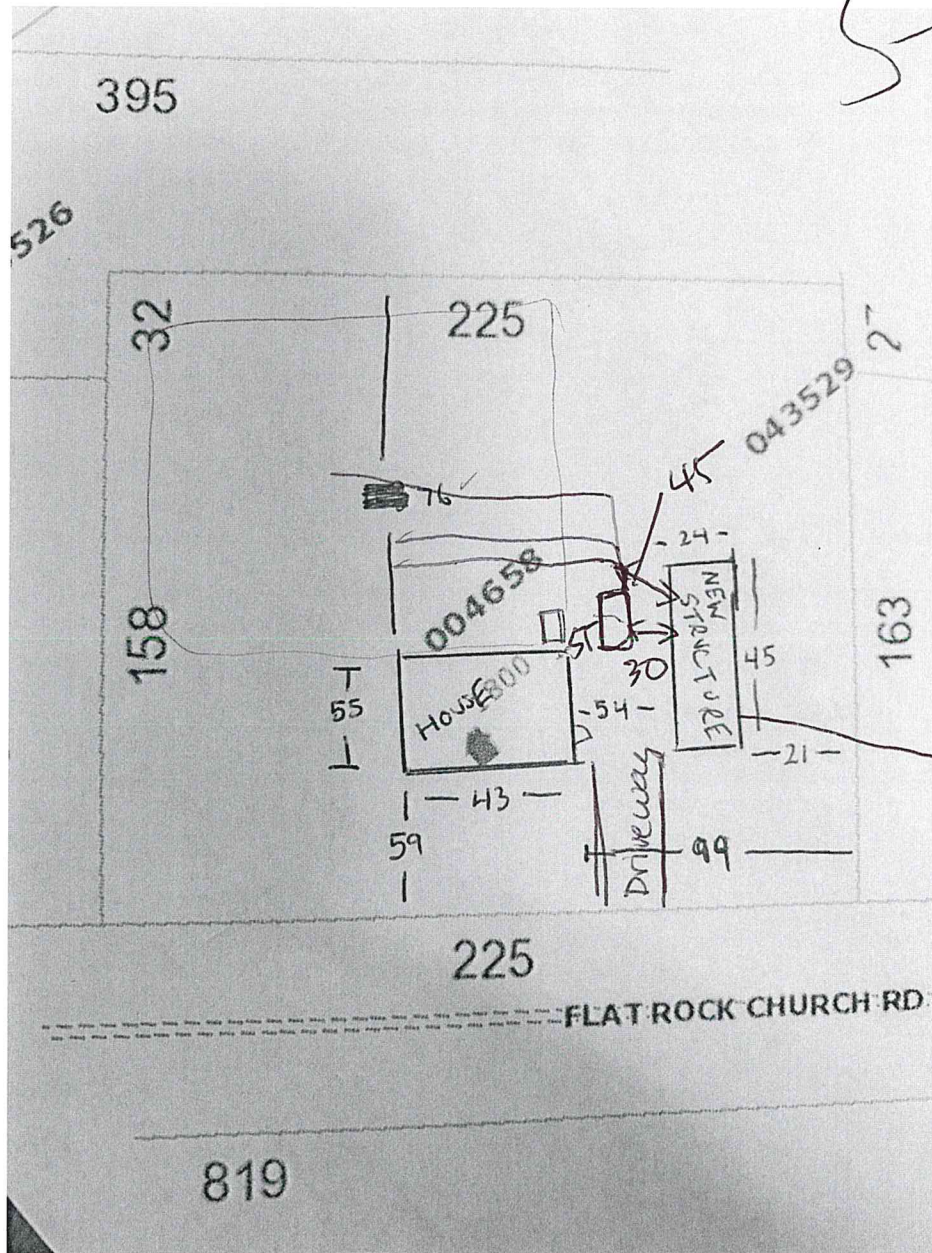

Google Earth