

FRANKLIN COUNTY HEALTH DEPARTMENT

130


PERMIT NUMBER: 49811 IMPROVEMENTS PERMIT	DATE: 06.18.93	4469-168	SIZE: .69A
APPLICANT: POPE & POPE P O BOX 640 YOUNGSVILLE NC 27596 TELEPHONE: 556-6152		OWNER: FARMLAND ASSOCIATES LTD	
COMMENT: SFD		CONTRACTOR: <i>Isabel Powell</i>	
LOCATION / DIRECTIONS: MIMLL CLL CREEK V LOT 168			
FEE: 50.00 7073		SIGNATURE OF OWNER OR AUTHORIZED AGENT:	

THE ABOVE SIGNATURE INDICATES THAT I HAVE READ, UNDERSTAND, AND AGREE WITH ALL PROVISIONS AND INFORMATION AS OUTLINED ON THE BACK SIDE OF THIS FORM

M: 115 900 3/27/95

#BEDRMS 3 DISPOSAL NO OTHER - TYPE.SYS C
SZ. TANK 900 SZ. CHAMB - NITRIFI 3' x 350' OPER. REQ NO
SITE. LOC -

REMARKS: *Keep system shallow - 24" max! Follow contour of lot. 100' from wells & 10' from prop lines.*

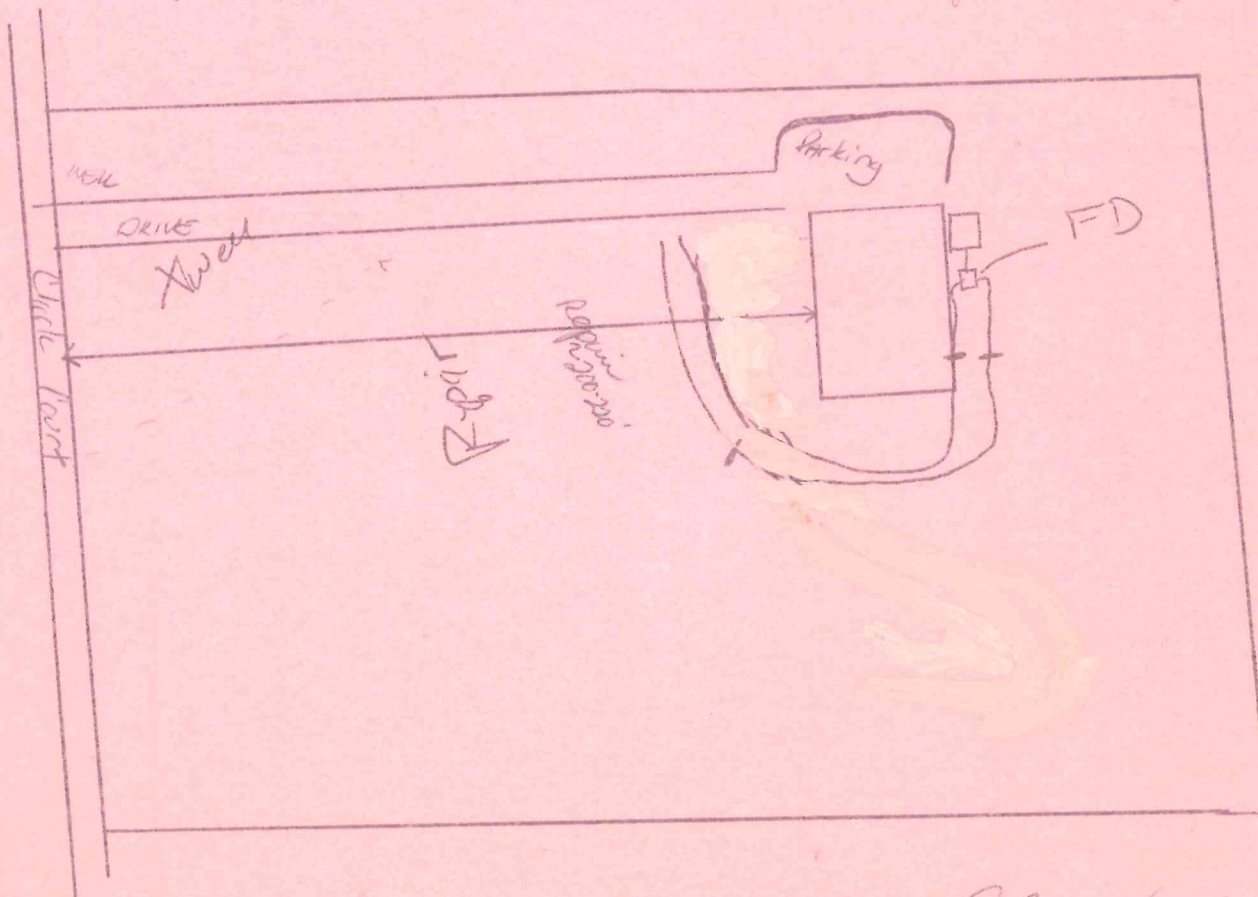

DATE. ISSUED 6-24-93
DATE. APPROVED 5/11/95

EH SPECIALIST *Chris Stalinski*

EH SPECIALIST *Jeffrey N. [Signature]*