

~~Fax 919-573-8358~~
573-8673

803 4558

PAGE 1 OF 2

Franklin County Health Department
Division of Environmental Health
107 Industrial Drive-Suite C
Louisburg, North Carolina 27549

Phone: 919-496-8100

SEPTIC PERMIT

Fax: 919-496-8136

Permit Number: 6121 Type: I PIN: 1834-67-9270 Date: 11/14/2011
Applicant: BLISS HOMES Owner: NEW ERA AUSTIN ROAD DEVELOPE
2500 FOREST LAKE CT
WAKE FOREST, NC 27587
Telephone: (919) 398-1181 Telephone:
Subdivision: WINDSOR ESTATES Lot Number: 3 Size: 0.720

Physical Address/ Location /Directions 50 CONSELLA WAY

Description: LifeTime _____ 5 Year ✓

TYPE FACIL RES # EMPLOY _____ # BEDRMS 4 GPD 480 LTAR 3
TYPE WAT Country TYPE SYS A TYPE REP A BSMT No BST FX N/A
SIZE TANK 1000 SIZE CHB N/A SIZE NITR 3'x400' MTD 30"

COMMENTS Maintain all setbacks, install on contour.

Septic Contractors are responsible for notifying the health department for final inspections, between 8:00-9:00 AM on the day of completion, Monday - Friday. Any request for final inspections received afterwards will be scheduled the same day, if possible, or the next workday. Have permit number and owner/applicant's name ready when making the call.

Actions of representatives of state or local agencies engaged in the evaluation and determination of measures required to effect the compliance with the provisions of this permit shall in no way be taken as a guarantee that wastewater disposal systems permitted and approved will function in a satisfactory manner for any given period of time, or that such employees assume any liability for damages, consequential or direct which are caused, or may be caused, by a malfunction of this wastewater treatment and disposal system.

Proper precautions must be taken to assure the proper functioning of the system after it has been covered. Do not run any heavy equipment over the system, as soft earth will allow damage to the tank and lines. Pipe all roof drains away from the septic system site to prevent flooding of the lines from surface water. Terrace the ground to prevent excessive drainage from higher areas adjacent to the system. Do not construct driveways over any part of the septic system unless proper provisions were made when the septic system was constructed. Only grass, not trees or shrubbery, should be cultivated over the lines. All plumbing fixtures should be carefully inspected periodically and any problems repaired immediately. All septic tanks should be pumped off by a permitted pump operator on a regular schedule, not to exceed every five years.

The improvement permit and construction authorization is a site approval, for the future installation of a wastewater treatment and disposal system. Changes in ownership of the site do not affect the validity of this permit. However, any alteration of the site or soil conditions, changes in the location of the proposed facility, changes to the wastewater flow and/or characteristics, or submittal of false information with the application or misrepresentation of the property lines may subject this permit to suspension or revocation.

FOR THIS TO BE A VALID CONSTRUCTION AUTHORIZATION, A LAYOUT SHEET MUST BE ATTACHED

IMPROVEMENT PERMIT DATE 12-5-11 EHS

CONSTRUCTION AUTHORIZATION DATE 12-5-11 EHS

Visit www.franklincountyenvironmentalhealth.com for permit information and tracking.

Franklin County Health Department

Name: BLISS HOMES

Permit Number

6121

CONTRACTOR

Therion Plumbing

TANK MANU

MCP 1000

MANU DATE

10-24-11

WELL INSTALLED

YES


NO

X

SYSTEM CODE

E21203H-W-C

SEPTIC SYSTEM LAYOUT (SKETCH SYSTEM LAYOUT HERE)

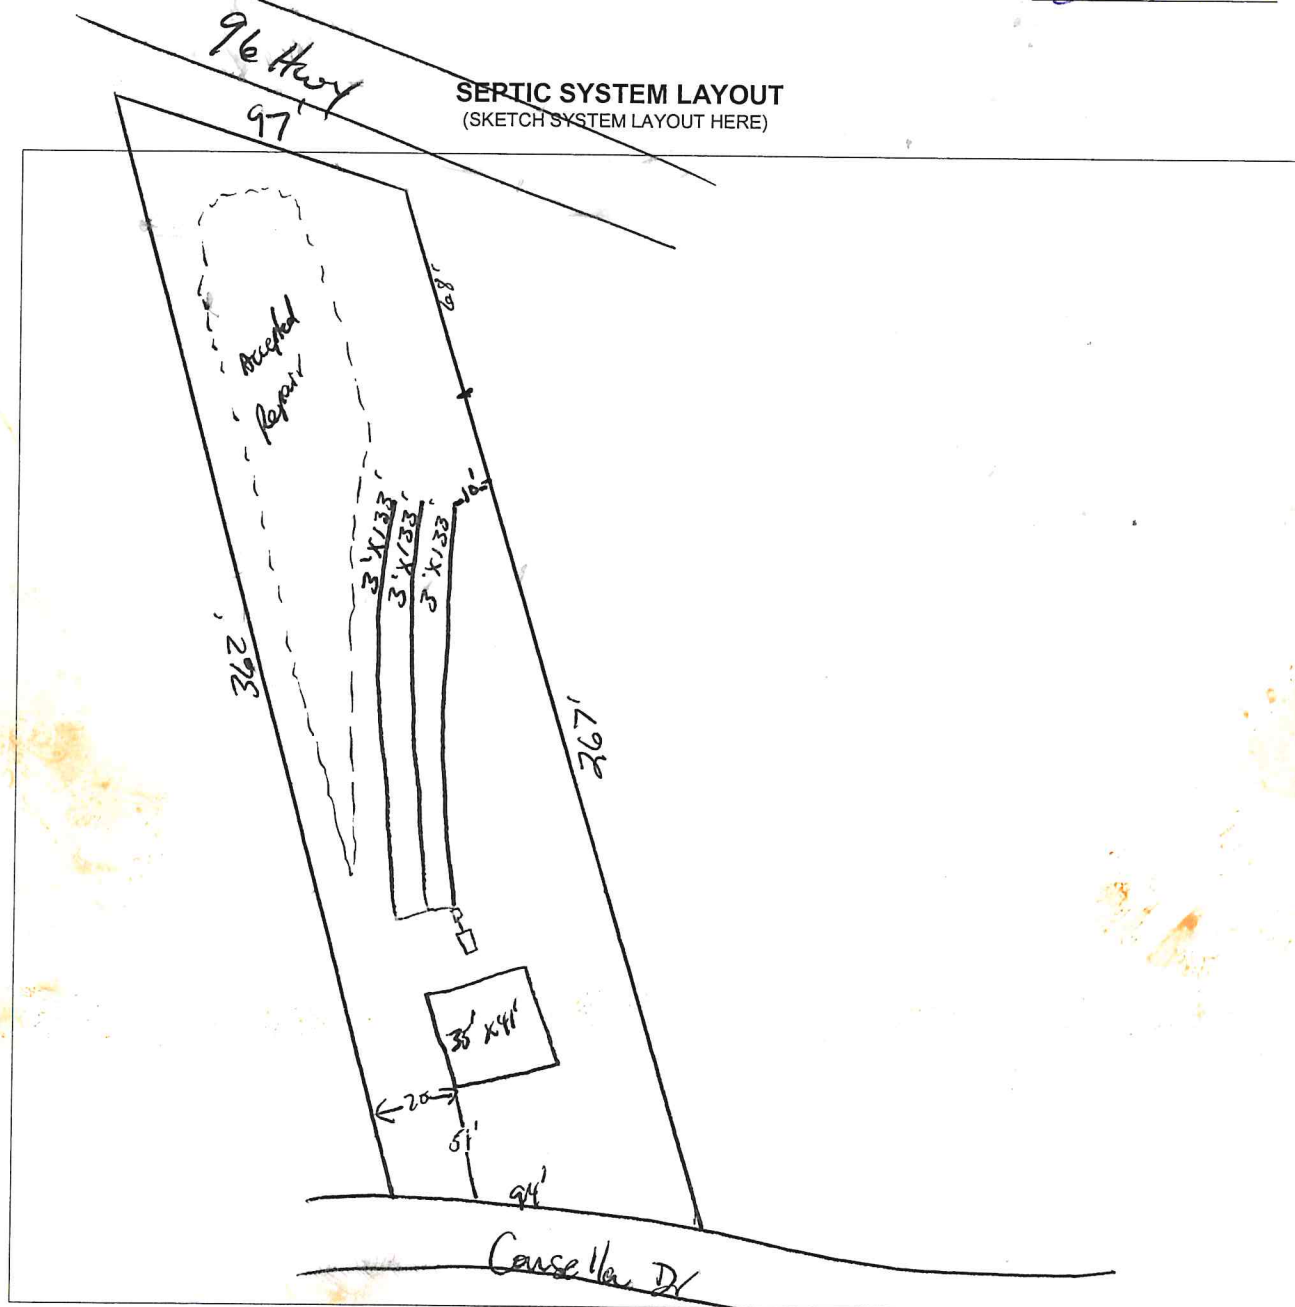

SEPTIC SYSTEM AS-BUILT

(IF DIFFERENT FROM INITIAL LAYOUT)

ON REVERSE

OPERATIONS PERMIT

DATE

2/27/12

EHS

Shad Leonard

TRANSACTION REPORT

DEC/05/2011/MON 05:12 PM

FAX(TX)

#	DATE	START T.	RECEIVER	COM.TIME	PAGE	TYPE/NOTE	FILE
001	DEC/05	05:11PM	99195738358	0:00:59	2	MEMORY OK	G3 4753

Fax 919-573-8358

Franklin County Health Department
Division of Environmental Health
107 Industrial Drive-Suite C
Louisburg, North Carolina 27549

PAGE 1 OF 2

Phone: 919-496-8100

SEPTIC PERMIT

Fax: 919-496-8136

Permit Number: 6121 Type: I PIN: 1834-67-9270 Date: 11/14/2011
Applicant: BLISS HOMES Owner: NEW ERA AUSTIN ROAD DEVELOPE
2500 FOREST LAKE CT
WAKE FOREST, NC 27587
Telephone: (919) 398-1181 Telephone:
Subdivision: WINDSOR ESTATES Lot Number: 3 Size: 0.720

Physical Address/ Location /Directions 50 CONSELLA WAY

Description: LifeTime _____ 5 Year ☒

TYPE FACIL RES # EMPLOY _____ # BEDRMS 4 GPD 480 LTAR 13
TYPE WAT Country TYPE SYS A TYPE REP A BSMT No BST FX N/A
SIZE TANK 1000 SIZE CHB N/A SIZE NITR 3'x400' MTD 30"

COMMENTS Maintain all setbacks, install on contour.

Septic Contractors are responsible for notifying the health department for final inspections, between 8:00-9:00 AM on the day of completion, Monday - Friday. Any request for final inspections received afterwards will be scheduled the same day, if possible, or the next workday. Have permit number and owner/applicant's name ready when making the call.

Actions of representatives of state or local agencies engaged in the evaluation and determination of measures required to effect the compliance with the provisions of this permit shall in no way be taken as a guarantee that wastewater disposal systems permitted and approved will function in a satisfactory manner for any given period of time, or that such employees assume any liability for damages, consequential or direct which are caused, or may be caused, by a malfunction of this wastewater treatment and disposal system.

Proper precautions must be taken to assure the proper functioning of the system after it has been covered. Do not run any heavy equipment over the system, as soft earth will allow damage to the tank and lines. Pipe all roof drains away from the septic system site to prevent flooding of the lines from surface water. Terrace the ground to prevent excessive drainage from higher areas adjacent to the system. Do not construct driveways over any part of the septic system unless proper provisions were made when the septic system was constructed. Only grass, not trees or shrubbery, should be cultivated over the lines. All plumbing fixtures should be carefully inspected periodically and any problems repaired immediately. All septic tanks should be pumped off by a permitted pump operator on a regular schedule, not to exceed every five years.

The improvement permit and construction authorization is a site approval, for the future installation of a wastewater treatment and disposal system. Changes in ownership of the site do not affect the validity of this permit. However, any alteration of the site or soil conditions, changes in the location of the proposed facility, changes to the wastewater flow and/or characteristics, or submittal of false information with the application or misrepresentation of the property lines may subject this permit to suspension or revocation.

FRANKLIN COUNTY SOIL/SITE EVALUATION SHEET

APPLICANT Bloss Homes
 WATER SUPPLY County
 LOCATION/DIRECTIONS #3 Windsor Estates

PROPERTY ID _____
 DATE 12-5-11

FACTORS

PROFILES

		1	2	3	4	5	6
LANDSCAPE POSITION	1940	LS	LS				
SLOPE (%)	1940	4%	4%				
HORIZON I DEPTH	1943	0-8	0-10				
TEXTURE	1941(a) (1)	SL	SL				
CONSISTENCE	1941	Fr	Fr				
STRUCTURE	1941(a)(2)	Cr	Cr				
CLAY MINEROLOGY	1941(a)(3)	SSxP	SBxP				
HORIZON II DEPTH	1943	8-22	10-18				
TEXTURE	1941(a) (1)	C	C				
CONSISTENCE	1941	Fr	Fr				
STRUCTURE	1941(a)(2)	SBK	SBK				
CLAY MINEROLOGY	1941(a)(3)	SSxP	SBxP				
HORIZON III DEPTH	1943	22-46	18-46				
TEXTURE	1941(a) (1)	CL	CL				
CONSISTENCE	1941	Fr	Fr				
STRUCTURE	1941(a)(2)	WSBK	WSBK				
CLAY MINEROLOGY	1941(a)(3)	SSxP	SBxP				
HORIZON IV DEPTH	1943						
TEXTURE	1941(a) (1)						
CONSISTENCE	1941						
STRUCTURE	1941(a)(2)						
CLAY MINEROLOGY	1941(a)(3)						
SOIL WETNESS	1941	>4%	>4%				
RESTRICTIVE HORIZON	1944	>4%	>4%				
SAPROLITE	1943/1956	42"	44"				
CLASSIFICATION	1948	P5	P5				
LTAR (gpd/ft2)	1955	13	3				
OTHER FACTORS (1946)			SITE LTAR (gpd/ft2) <u>3</u>				
AVAILABLE SPACE (1945) <u>P5</u>			SYSTEM TYPE <u>A</u>				
CLASSIFICATION (1948) <u>P5</u>			<u>R=A</u>				
EVALUATED BY: <u>S. Leonard</u>			OTHERS PRESENT <u>Brian @ Bloss Homes</u>				