

FRANKLIN COUNTY HEALTH DEPARTMENT

[illegible]

SEPTIC PERMIT APPLICATION
Franklin County Health Department
Phone 496-8100

TxREC#: 5680
PIN#:

SPermit#: 74681
BPermit#: 5919
TMAP: E07B00 022

Township: Youngsville
Subdivision: Franklin Vineyd
Prop.Address:

Zone: AR
Lot: Lot Size: 3.59A
St.Road: 1103

Applicant: McGee, W. E. & Glenda
Address: Route 7 Box 222
C/S/Z: Louisburg, NC 27549
Phone: (919) 556-2770
SF/Building Permit: Y
Bedroom#: 0
Commercial:
Public Sewer:
Public Water:
Type Facility:
SPermit \$: 50.00
Notes: (existing septic system)

Owner: McGee, W. E. & Glenda
Address: Route 7 Box 222
C/S/Z: Louisburg, NC 27549

Mobile Home Permit:
Bath#: 3.0
Industrial:
Town:

Est.Daily Waste Flow:
Date: 11/30/95 Rec#: 1005

ZONING PERMIT

Department of Planning & Development

Use of Property: Single Family Dwelling


Zoning District: AR

Setback Required: Front:30 Rear: 25 Side: 10

10 wood

Zoning Adminstrator

I certify that all the statements made in this application and any attached documents are true, complete and correct to the best of my knowledge and belief and are made in good faith. I understand that false information may be grounds for rejection of this application. Authorized County representatives are granted right of entry to make evaluations or inspections and to release information upon public request.

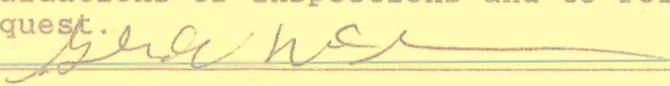

Signature of Owner/Authorized Agent

11/30/95
Date

Call the Health Department (496-8100) between 8:00 AM and 9:00 AM on Monday-Friday to schedule an appointment with an environmental health specialist to evaluate your lot. He/she will show you where to locate the well and septic system, in relation to the desired dwelling location and any property lines. If approved, an improvements permit will be issued. After the septic tank has been installed and approved, the Sanitarian will issue a certification of completion.

PER005B

VICINITY MAP
(NOT TO SCALE)

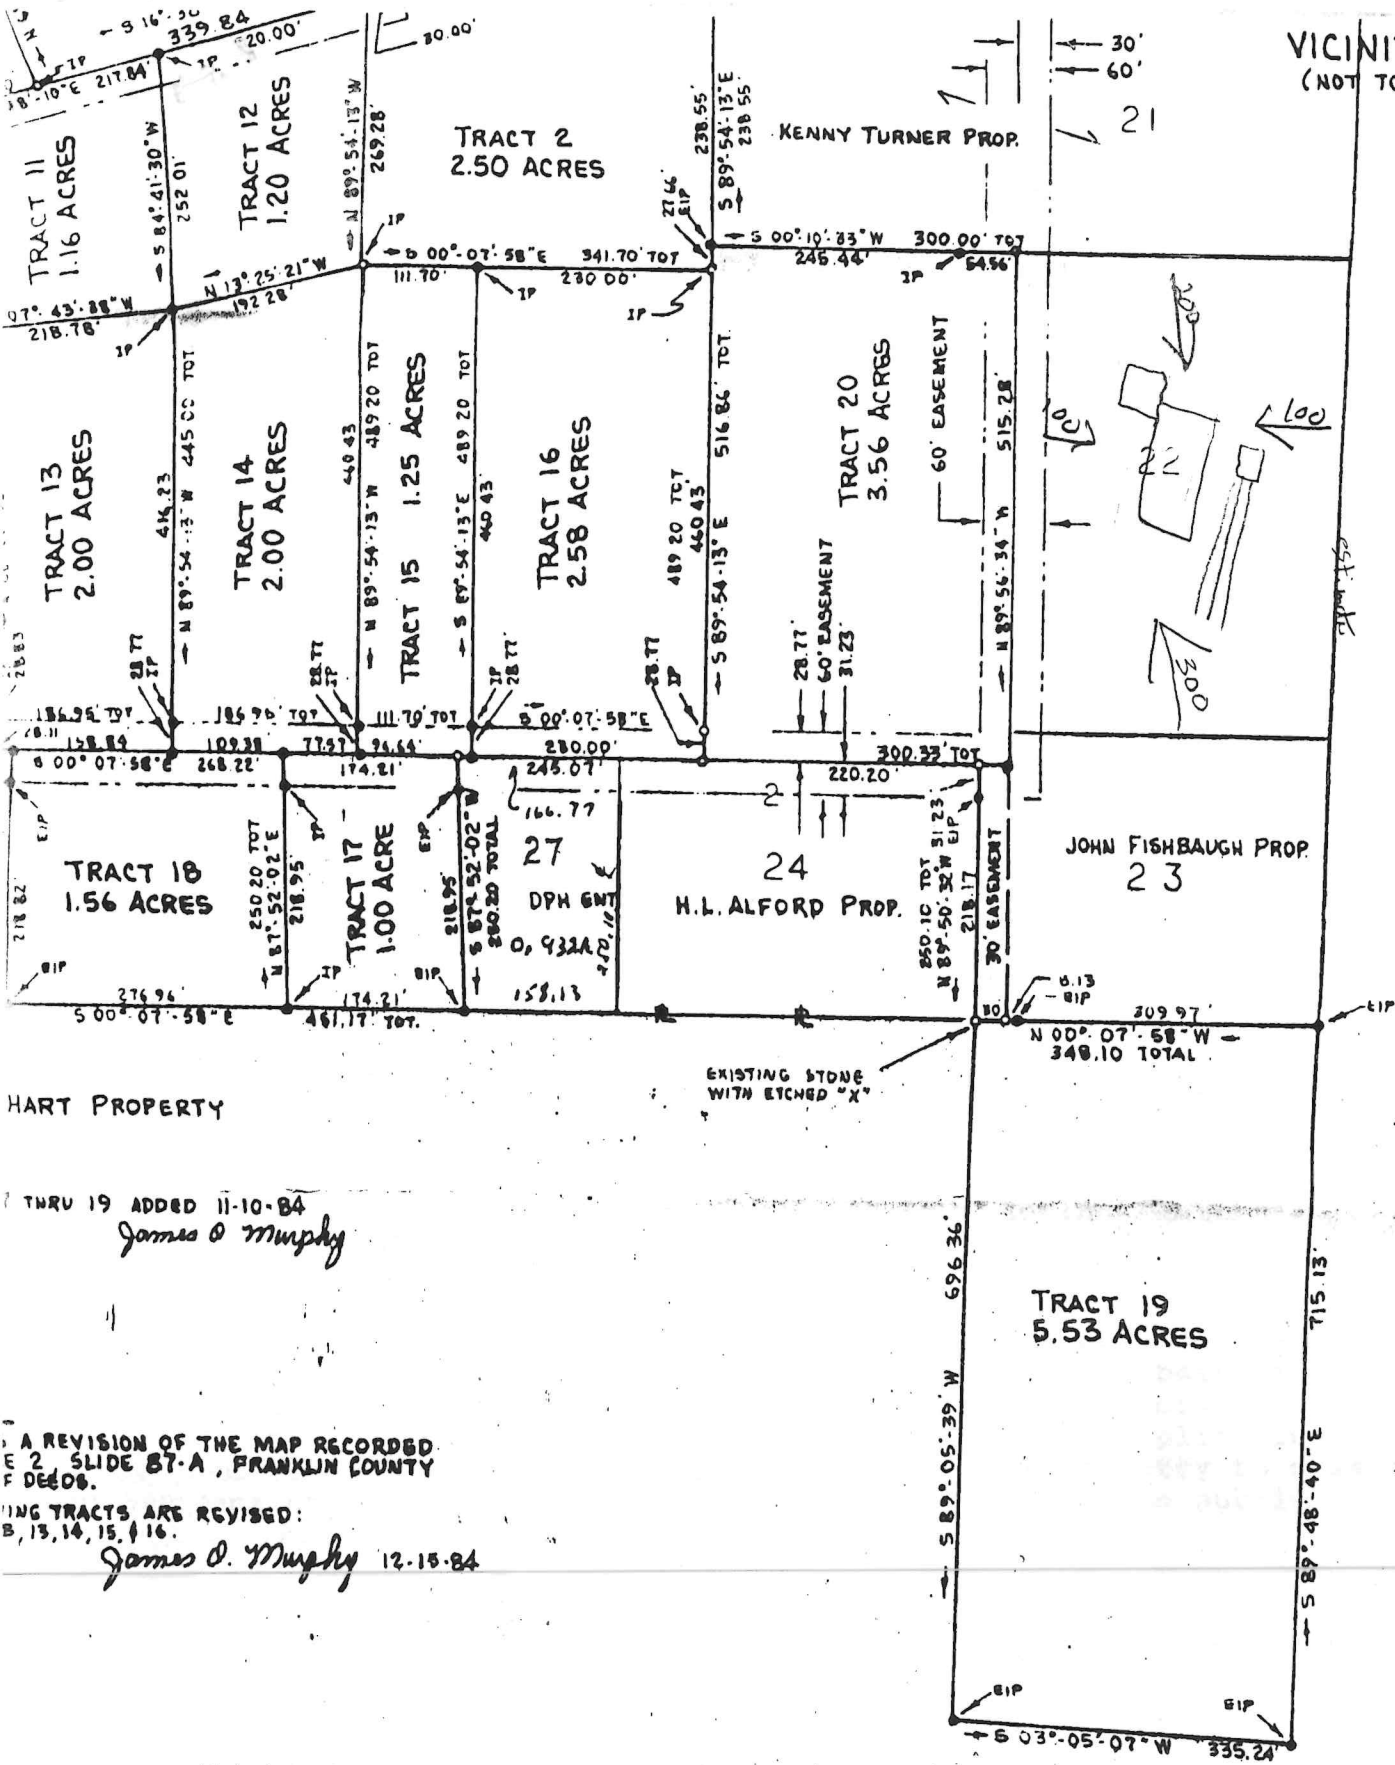

HART PROPERTY


THRU 19 ADDED 11-10-84
James O. Murphy

A REVISION OF THE MAP RECORDED
E 2, SLIDE 87-A, FRANKLIN COUNTY
DEEDS.

ING TRACTS ARE REVISED:
B, 13, 14, 15, & 16.
James O. Murphy 12-16-84

Jean L. Murphy, A Notary Public for Franklin
County, N.C., is hereby acknowledged and
January 1985, at 1000 P.M. and duly certified
Deeds of Franklin Co., N.C., in Public Record File

Register of Deeds
Blair S. Ducock Deputy

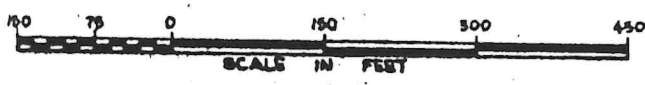

REVISED MAP OF
FRANKLIN VINEYARDS