

GRANVILLE-VANCE HEALTH DEPARTMENT—Sewage Disposal Record

Owner or Contractor Joseph Horse Date 4-2-03 S.R. No. 1710

Location/Address _____

Subdivision/Mobile Home Park Name Granville Ridge Lot Size 9

Permit No. # _____ Lot No. 11

New System ☒ Repair _____

House ☒ Mobile Home _____ Business _____

No. Bedrooms 4 No. People _____ No. Toilets _____

Water Supply: Private ☒ Approved _____

Semi-Public _____ Unapproved _____

Public _____ None _____

Nitrification System:

Tank Size 1000 gal.

Distribution Box ☒ No. Lines 5

Nitrification Field 1371 Sq. Ft.

Lines: 1' 2' 3' 4' 5' 6'

Width 3' 3' 3' 3' 3' _____

Length 92' 92' 92' 92' 92' _____

Grade 0" 0" 0" 1" 0" _____


Stone Depth 12" 12" 12" 12" 12" _____

Layout to be followed by installer:

Improvements Permit By David Cumbee, RS Installer Jeri Cole

Certificate of Completion By Jerry Clayton, RS Date of Inspection 4-2-03

* Construction must comply with all other applicable state and local regulations, but the permit is not a guarantee that the system will not malfunction and the Granville-Vance Health District will not be held responsible for a malfunctioning system.

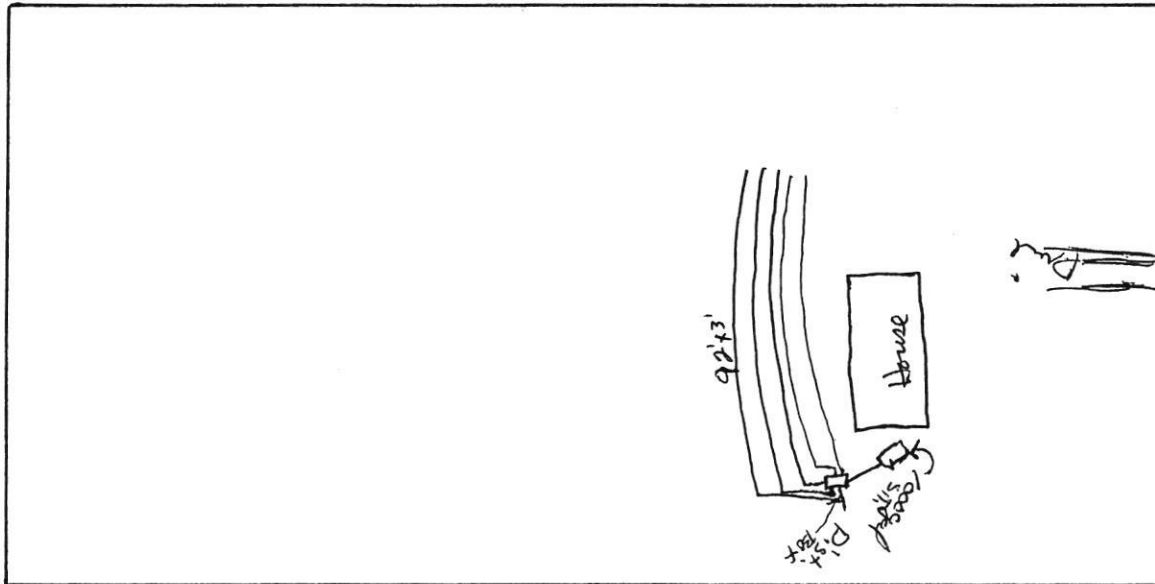


NOTE: Make sketch of installation showing location of house, septic tanks, privies, water supplies on adjacent property, etc. Write in measurements in order that installations may be located at later date.



PERMIT NUMBER **2275**

**GRANVILLE - VANCE DISTRICT HEALTH DEPARTMENT
IMPROVEMENT AND OPERATION PERMITS**

COUNTY:	TAX NO.	TYPE OF ESTABLISHMENT			*THIS PERMIT SHALL BE ACCOMPANIED BY A LAYOUT SHOWN ON A PLAT, INCLUDING SYSTEM REQUIREMENTS.
Granville	SR NO. 1716	RESIDENCE ☒ BUSINESS ☐ OTHER ☐	NUMBER OF BEDROOMS: 4	NUMBER OF OCCUPANTS: 2-11	
OWNER: Southern Showcase					
APPLICANT: Tim Newcomb		WATER SUPPLY			
APPLICANT'S ADDRESS: 20242 Raleigh Rd. Box 304		PUBLIC ☐	WELL ☒	OTHER ☐	*THE IMPROVEMENTS PERMIT MUST BE ATTACHED TO A CONSTRUCTION AUTHORIZATION BEFORE OBTAINING BUILDING PERMIT OR OTHER CONSTRUCTION PERMITS AND BEFORE A WASTEWATER SYSTEM IS INSTALLED.
PROPERTY ADDRESS/LOCATION: Lawrence Rd.		TYPE OF WASTEWATER SYSTEM			
		DESCRIPTION	INITIAL INSTALLATION	REPAIR	
SUBDIVISION: Granville Ridge		DESIGN FLOW:	480 gal/day		
LOT NUMBER: 11		LTAR:	35 gal/day		
REFERENCE SKETCH (SEE PLAT FOR DETAILS) *See attached sketch for layout		ABSORPTION AREA:	1371 sq ft		
		TRENCH WIDTH:	3'		
		TRENCH SPACING:	4' O.C.		
		TOTAL TRENCH LENGTH:	460'		
		NUMBER OF TRENCHES:	5		
		GRAVEL DEPTH:	12"		
		TANK SIZE:	1000 gal + 10 box		*THIS IMPROVEMENT PERMIT IS SUBJECT TO REVOCATION IF THE INTENDED USE CHANGE FROM THOSE SHOWN ON THE IMPROVEMENT PERMIT. CHANGES SHALL REQUIRE HEALTH DEPARTMENT APPROVAL.
		CONDITIONS:	*See auct. to const.		
IMPROVEMENT PERMIT					DATE: 2-11-03
FOR: Southern Showcase					1-5-00
ISSUED BY: David Cumbee					
OPERATION PERMIT					DATE:
SYSTEM INSTALLED BY: Jim Cole					4-2-03
ISSUED BY: Jerry B. Clayton, RS					

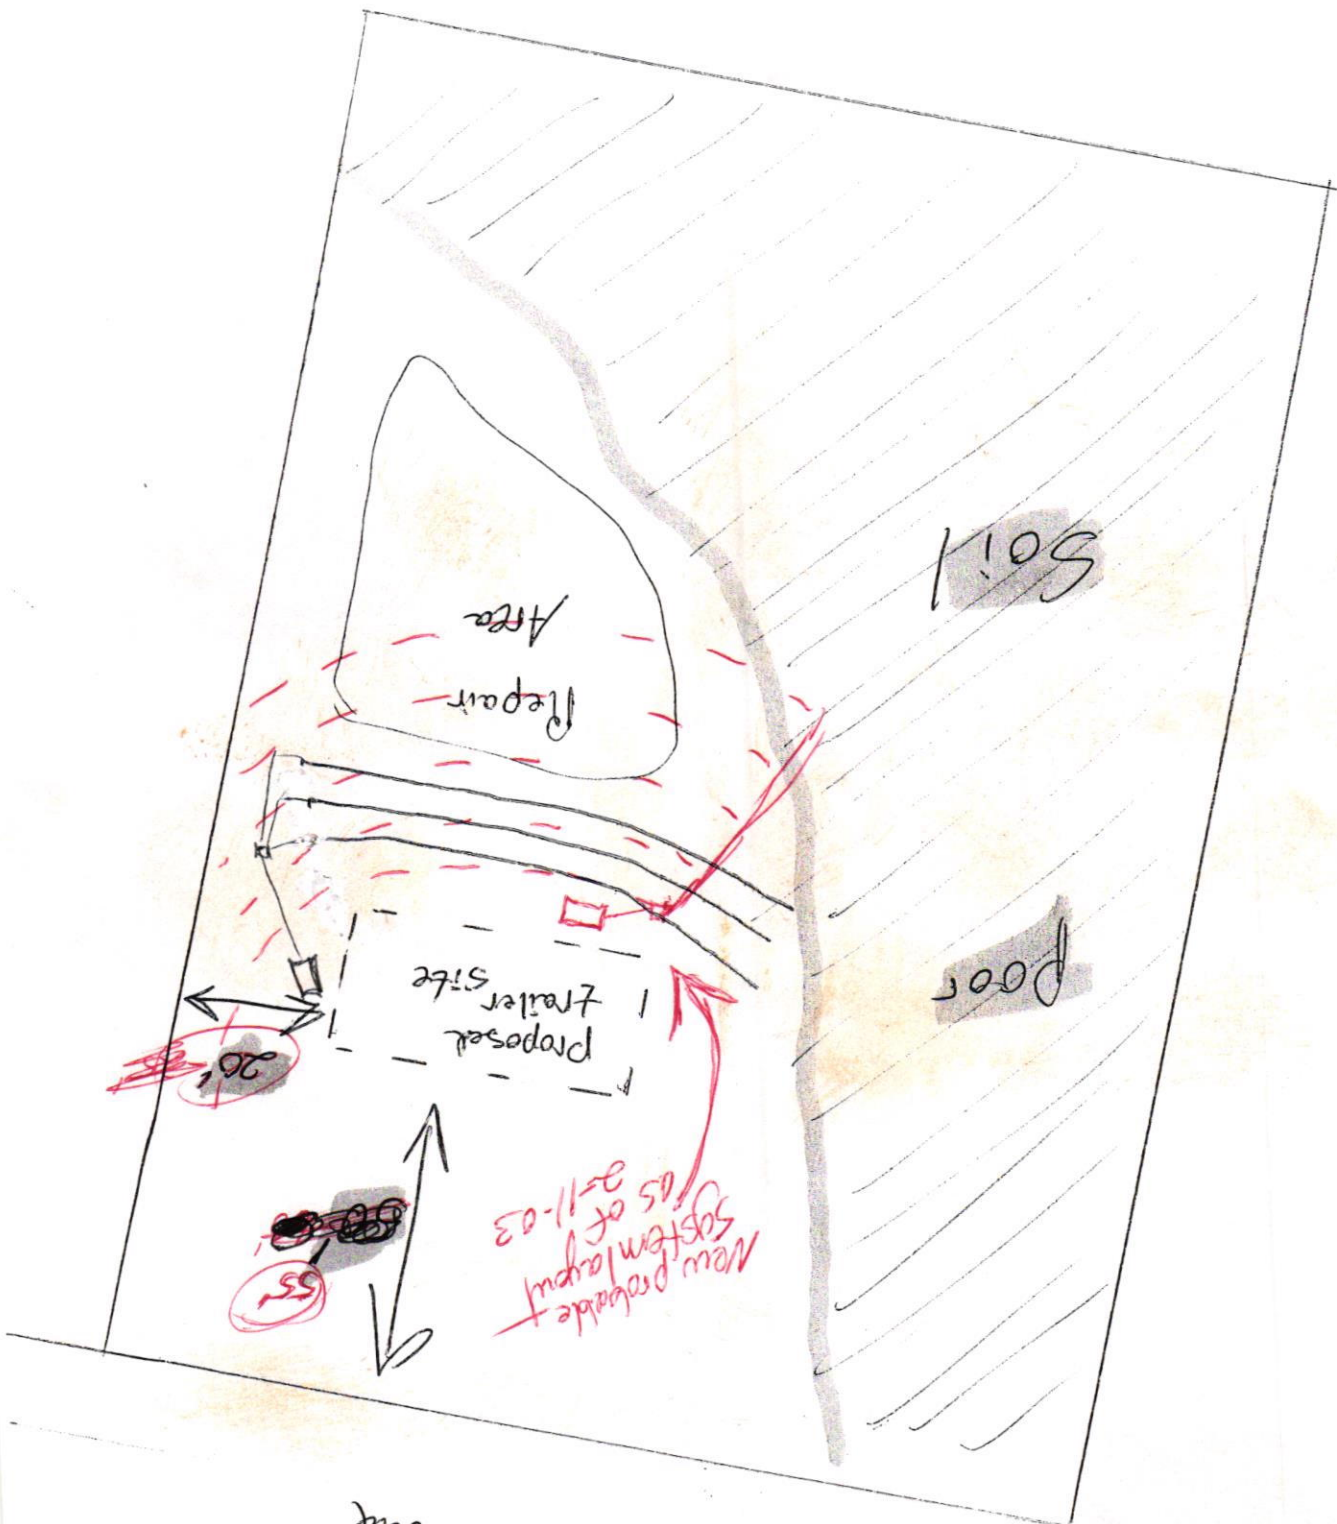

Gannville Bridge Road

→ To Lawrence Rd