


NOTE: Make sketch of installation showing location of house, septic tanks, privies, water supplies on adjacent property, etc. Write in measurements in order that installations may be located at later date.

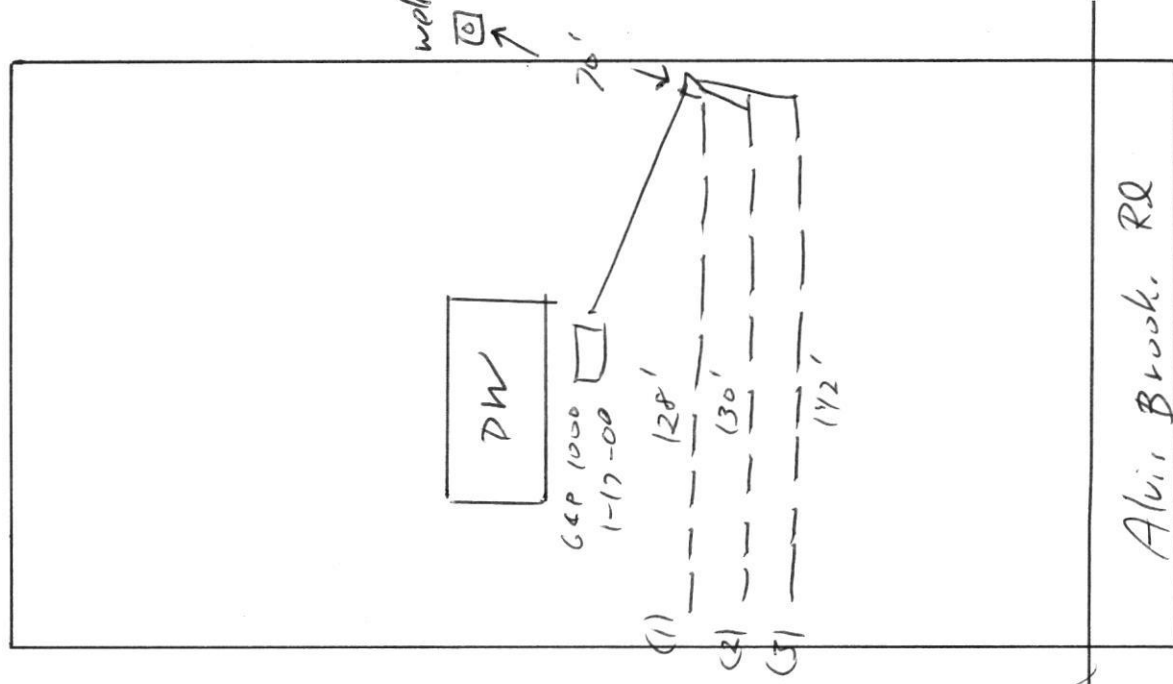

S.P.
1353

→
Sunset Rd.

GRANVILLE-VANCE HEALTH DEPARTMENT—Sewage Disposal Record

Owner or Contractor Charles Adcock Date 3-9-00 S.R. No. 1333

Location/Address Alvis Brook RD

Subdivision/Mobile Home Park Name _____ Lot Size 1.885

Permit No. # 1991 Lot No. Tract 1

New System ☒ Repair _____

House _____ Mobile Home PW Business _____

No. Bedrooms 3 No. People 2 No. Toilets _____

Water Supply: Private ☒ Approved _____

Semi-Public _____ Unapproved _____

Public _____ None _____

Nitrification System:

Tank Size 1000 gal.

Distribution Box ☒ No. Lines 3

Nitrification Field 1200 Sq. Ft.

Lines: 1 2 3 4 5 6

Width 3' 3' 3' _____

Length 128' 130' 142' _____

Grade 0' 0' 0' _____

Stone Depth 12" 12" 12" _____

Layout to be followed by installer:

Improvements Permit By Eddie Yount Installer John Ayres

Certificate of Completion By Eddie Yount Date of Inspection 3-9-00

* Construction must comply with all other applicable state and local regulations, but the permit is not a guarantee that the system will not malfunction and the Granville-Vance Health District will not be held responsible for a malfunctioning system.