

FRANKLIN COUNTY HEALTH DEPARTMENT

PERMIT NUMBER: <u>17074C CONST IMPROVE PERMIT 20030114</u>	DATE: <u>2728-94-3491</u>	SIZE: <u>1.940A</u>
APPLICANT: <u>RAY BOBBY L</u> <u>109 BRODIE PRIVETTE RD</u> <u>ZEBULON NC 27597</u>		OWNER: <u>RAY BOBBY L</u>
TELEPHONE: <u>269-8463</u>		
COMMENT: <u>MH</u>	DESCRIPTION: 5 YEAR ☒	LIFETIME: ☐
LOCATION / DIRECTIONS: <u>BEAVER RUNN #9</u>		
FEE: <u>225.00</u>		SIGNATURE OR OWNER OR AUTHORIZED AGENT:

THE ABOVE SIGNATURE INDICATES THAT I HAVE READ, UNDERSTAND, AND AGREE WITH ALL PROVISIONS AND INFORMATION AS OUTLINED ON THE BACK SIDE OF THIS FORM

TOPO <u>PS</u>	TEXTURE <u>PS</u>	STRUCTURE <u>PS</u>	DEPTH <u>PS</u>
R. HOR <u>PS</u>	SOIL. WET <u>PS</u>	AVAIL. SP <u>PS</u>	OTHER _____
MINRL <u>PS</u>	OVERALL <u>PS</u>	LTAR <u>0.3</u>	
#BEDRMS <u>3</u>	GPD <u>360</u>	DISPOSAL _____	TYPE. SYS <u>Conv.</u>
SZ. TANK <u>1000</u>	SZ. CHAM <u>24"</u>	NITRIFI <u>3'x400'</u>	TYPE. WAT <u>Priv.</u>
SITE. LOC _____	MAX TRENCH DEP _____	TYP. FAC <u>SFD</u>	

REMARKS: * DRAWING Not to Scale

* EXACT TANK & Drain Field LOCATION CAN VARY Slightly!

CONTRACTOR: B. H. Thomas


TANK MANUF: mpd 1000

MANUF DATE: 11/15/02

* Install SYSTEM Along Contour & IN DRY

Conditions

* Do Not PARK or Drive Over SYSTEM AREA!

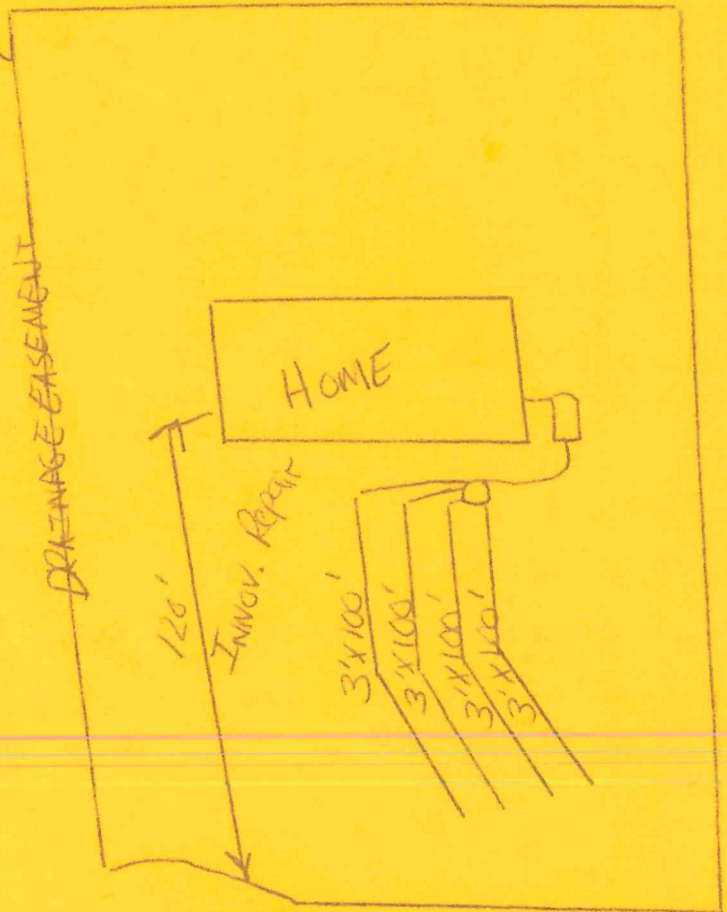

BEAVER RUN DR.

IMPROVEMENT PERMIT DATE: 1/15/03

CONSTRUCTION AUTHORIZATION DATE: 1/15/03

OPERATION PERMIT DATE: 3/17/03

ENV HEALTH SPEC: Andy Smith

ENV HEALTH SPEC: Andy Smith

ENV HEALTH SPEC: Andy Smith

COUNTY OF FRANKLIN

ENVIRONMENT HEALTH APPLICATION (496-8100)

Permit #: **8594**

Permit Type: **SEPTIC PERMIT**

Date Issued: **01/13/2003**

Project Address: **BEAVER RUN,**

Location: **BEAVER RUN**

Subdivision: **BEAVER RUN**

Lot #: **9**

Size #: **1.940**

170740

Applicant: **RAY BOBBY L.**

109 BRODIE PRIVETTE ROAD

ZEBULON NC 27597

Phone: **269-8463**

Contractor:

Phone:

Proposed Use: **DOUBLEWIDE**

Work:

Desc:

Bldg Cost: \$0	Fees Due: \$225.00	Date Paid: 01/13/2003
Zoned: AR	Setbacks Front: 30	Rear 25 Side 10
Tax record: 34782	Pin #: 2728-94-3491	Parcel #: J13E00 009
Township: DUNN	Public Water/Sewer: PRIVATE	ST Road #:
Special Conditions/Property Owner: RAY BOBBY L.		
# of bedrooms: 3	# of people: 4	Approved for Issuance by:
** Environmental Health Use Only ** Type Wastewater - Sewage: _____ Industrial Process Wastewater: _____ Type Water Supply - Private: _____ Community: _____ Previously Identified Jurisdictional Wetland - Yes: _____ No _____		
I certify that all the statements made in this application and any attached documents are true, complete and correct to the best of my knowledge and belief and are made in good faith. I understand that false information may be grounds for rejection of this application. Authorized county representatives are granted right of entry to make evaluations or inspections and to release information upon public request.		

Call Environment Health (496-8100) between 8:00 AM and 9:00 AM Monday thru Friday to schedule an appointment with the environment health specialist to evaluate your lot. He/She will show you where to locate the well and septic system, in relation to the desired dwelling location and any property lines. If approved, an improvements permit will be issued. After the septic tank has been installed and approved, the Sanitarian will issue a certification of completion.

[Signature]
 Fees Are Nonrefundable
 (Signature of Contractor, Authorized Agent or Owner)

1 13 03
 Date

Franklin County DRC Application

RESIDENTIAL

Zoning Permit #: 6048



ADDRESS: **BEAVER RUN**

PARCEL NO.: **2728-94-3491**

ZONING: **AR**

SUBDIVISION: **BEAVER RUN**

LOT: **9**

ISSUED TO: **RAY BOBBY L.**

109 BRODIE PRIVETTE ROAD

ZEBULON NC 27597

PHONE NUMBER: **269-8463**

SETBACK: FRONT: **30** RIGHT: **10** LEFT: **10** REAR: **25**

COUNTY WATER: **N/A** FLOODPLAIN: **N/A**

PERMIT TYPE: **ZONING PERMIT**

TYPE OF CONSTRUCTION: **DOUBLE-WIDE MOBILE HOME**

PERMIT DATE: **01/13/2003** WATERSHED **N/A**

TOWNSHIP **DUN** EXPIRE DATE: **07/13/2003**

It is hereby certified that the above use as shown on the plats and plans submitted with this application conforms with all applicable provisions of the Franklin County Zoning Ordinance. The issuance of this application does not allow the violation of Franklin County Zoning Ordinance or other governing regulations. The applicant is responsible for obtaining a building permit (if required) prior to commencing work on the proposed improvement. A final zoning inspection must be scheduled by the applicant.

NOTES:

I hereby certify that all information I have provided to the Planning Department is true and accurate.

APPLICANT'S SIGNATURE:

[Handwritten Signature]

UTILITY COMPANY : **CP & L** WAKE ELECTRIC OTHER
 NUMBER OF STORIES: **1** 1 1/2 2 2 1/2
 SQUARE FOOTAGE: HEATED UNHEATED TOTAL
 BASEMENT: **N/A** YES NO MANUFACTURED
 FIREPLACE: **N/A** MASONRY MANUFACTURED
 PLAN SETS: MODULAR STICKBUILT
 ELECTRICIAN: MECHANICAL:
 PLUMBING:
 MULTI USE PLAN #
 COST OF CONSTRUCTION:

NO MORE THAN 2 STRUCTURAL DEVIATIONS OR PLANS MUST BE REDRAWN

DEPARTMENTAL USE ONLY

	INITIALS (IN)	DATE	INITIALS (OUT)	DATE
ZONING	<i>PPW</i>	<i>1-13-03</i>		
INITIAL PERMITTING				
ADDRESSING				
PLAN REVIEW				
FIRE REVIEW				
SEPTIC/SEWER				
FINAL PERMITTING				

