

FRANKLIN COUNTY HEALTH DEPARTMENT


PERMIT NUMBER: 36391 IMPROVEMENTS PERMI	DATE: 01.29.92	7352	SIZE: 4A
APPLICANT: BRODIE ANDREW 123 HAYES STREET LOUISBURG NC 27549 TELEPHONE: 496-2861		OWNER: BRODIE ANDREW 123 HAYES STREET LOUISBURG NC 27549	
COMMENT: MOBILE HOME		CONTRACTOR: <i>Thurmon Johnson</i>	
LOCATION / DIRECTIONS: SR 1223 ~ 1 mile north on W side ~ 2 miles off road.			
FEE: 50.00 23423		SIGNATURE OF OWNER OR AUTHORIZED AGENT:	

THE ABOVE SIGNATURE INDICATES THAT I HAVE READ, UNDERSTAND, AND AGREE WITH ALL PROVISIONS AND INFORMATION AS OUTLINED ON THE BACK SIDE OF THIS FORM

5-17-94 Ellis 1000 gal

#BEDRMS <u>3</u>	DISPOSAL <u>-</u>	OTHER <u>-</u>	TYPE. SYS <u>C</u>
SZ. TANK <u>900</u>	SZ. CHAMB <u>-</u>	NITRIFI <u>300'x3'</u>	OPER. REQ <u>N</u>
SITE. LOC <u>-</u>			

REMARKS: Keep from shallow - 24" max. 4' from center of plot! Keep depth on 9' center!!!

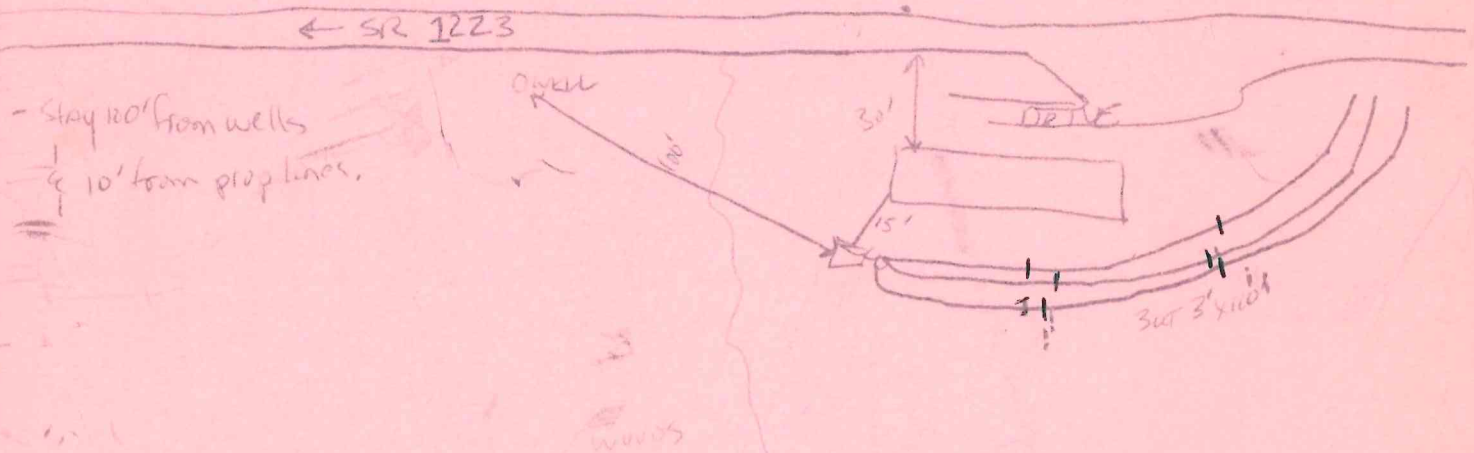

DATE. ISSUED 2/2/92

EH SPECIALIST Chris Hedrick

DATE. APPROVED 7-22-94

EH SPECIALIST E. Glenn Johnson