

FRANKLIN COUNTY HEALTH DEPARTMENT

00P# 458981


PERMIT NUMBER: 57661 IMPROVEMENTS PERMIT	DATE: 04.03.95	3998	SIZE: .69A
APPLICANT: GILEWICZ MICHAEL H PO BOX 319 WAKE FOREST NC27588 TELEPHONE: 556-1946	OWNER: WOODLIEF MATTIE		
COMMENT: SFD	CONTRACTOR: Mark Young Constr.		
LOCATION / DIRECTIONS: BRISTOL #13 101 New Castle Ct. Youngsville 27596			
FEE: 100.00 10028		SIGNATURE OF OWNER OR AUTHORIZED AGENT:	

THE ABOVE SIGNATURE INDICATES THAT I HAVE READ, UNDERSTAND, AND AGREE WITH ALL PROVISIONS AND INFORMATION AS OUTLINED ON THE BACK SIDE OF THIS FORM

6/2/95 Mills 460

#BEDRMS	<u>3</u>	DISPOSAL	<u>N</u>	OTHER	<u>-</u>	TYPE. SYS	<u>C</u>
SZ. TANK	<u>900</u>	SZ. CHAMB	<u>-</u>	NITRIFI	<u>3'x300'</u>	OPER. REQ	<u>N</u>
SITE. LOC	<u>-</u>						

REMARKS: * Shallow System + Sump - 50' from well, 10' from property lines

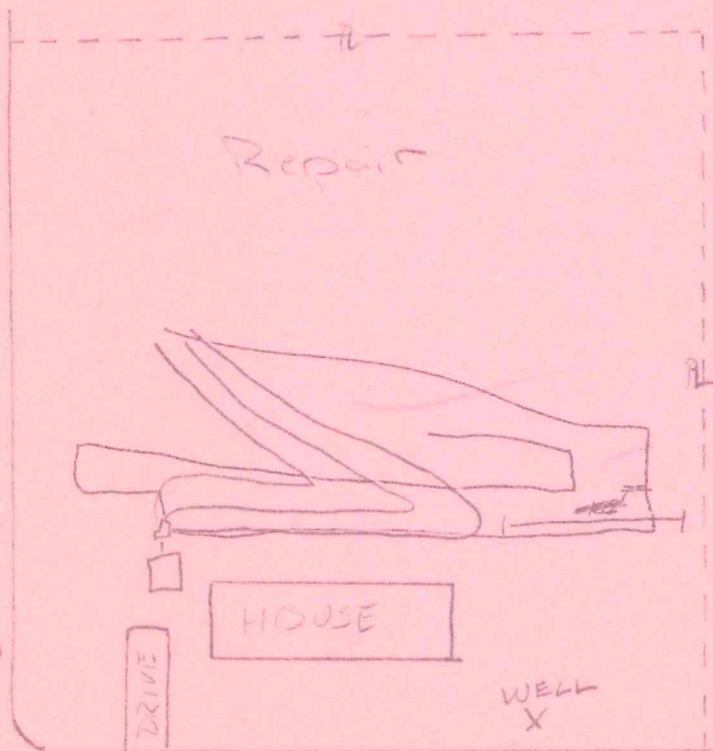

NEW CASTLE COURT

DATE. ISSUED 4/7/95EH SPECIALIST [Signature]DATE. APPROVED 8/17/95EH SPECIALIST [Signature]

SEPTIC PERMIT APPLICATION
Franklin County Health Department
Phone 496-8100

TxREC#: 3998
PIN#:

SPermit#: 6766I
BPermit#: 4739
TMAP: D05 00 029B-13

Township: Youngsville
Subdivision: Bristol
Prop.Address:

Zone: AR
Lot: 13 Lot Size: 0.69A
St.Road: 1125

Applicant: Gilewicz, Michael H
Address: P.O. Box 319
C/S/Z: Wake Forest, NC 27588
Phone: (919) 556-1946
SF/Building Permit: Y
Bedroom#: 3
Commercial:
Public Sewer:
Public Water:
Type Facility:
SPermit \$:100.00
Notes:

Owner: Woodlief, Mattie
Address:
C/S/Z:
Mobile Home Permit:
Bath#: 2.0
Industrial:
Town:
Est.Daily Waste Flow:
Date: 04/03/95 Rec#: 10028

ZONING PERMIT

Department of Planning & Development

Use of Property: single family dwelling

Zoning District: AR

Setback Required: Front:30 Rear: 25 Side: 10

B. Winstead

Zoning Administrator

I certify that all the statements made in this application and any attached documents are true, complete and correct to the best of my knowledge and belief and are made in good faith. I understand that false information may be grounds for rejection of this application. Authorized County representatives are granted right of entry to make evaluations or inspections and to release information upon public request.

Debbie Rawls

4-3-95

Signature of Owner/Authorized Agent

Date

Call the Health Department (496-8100) between 8:00 AM and 9:00 AM on Monday-Friday to schedule an appointment with an environmental health specialist to evaluate your lot. He/she will show you where to locate the well and septic system, in relation to the desired dwelling location and any property lines. If approved, an improvements permit will be issued. After the septic tank has been installed and



MPG BUILDERS

P.O. Box 919


Wake Forest, NC 27588-0319

BRISTOL SUBDIVISION PHASE TWO

FRANKLIN COUNTY (YOUNGSVILLE)

919 / 556-1946

LOT 13

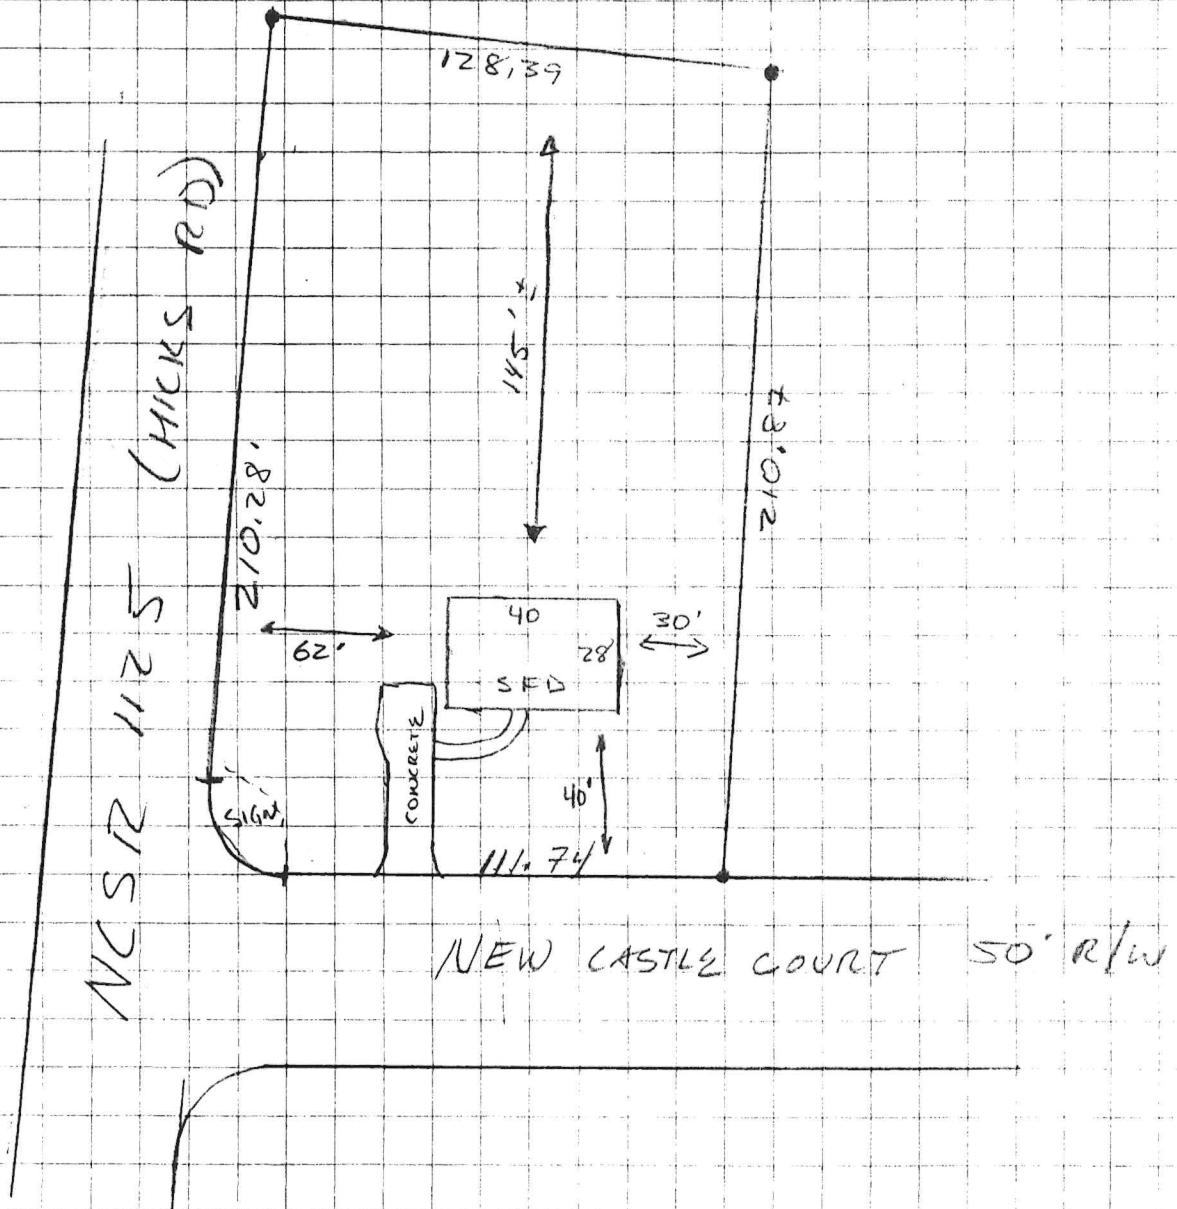

SCALE: 1" = 50'