



OPERATION PERMIT

Franklin County Health Department
107 Industrial Drive
Louisburg, NC 27549
Phone:

For Office Use Only

*CDP File Number 366073 - 1

County ID Number: 1882-78-1220

Evaluated For: NEW

Property Owner: MICHAEL SCHRIVER

Address: PO BOX 550

Road #:

City: YOUNGSVILLE

State/Zip: NC/ 27596

Phone #:

Township:

Subdivision: HIGHCROFT

Phase : NEW

Lot: 21

Structure: SINGLE FAMILY

of Bedrooms: 4

of People: 3

Water Supply: PUBLIC

Saprolite System?: ☐ Yes ☒ No

Pump Required?: ☒ Yes ☐ No

Design Flow: 480

System Classification/Description: TYPE III B. SYSTEM
W/SINGLE EFFLUENT PUMP

Installer: Trueworks

Specific System EZFLOW EZ 1203H-GEO

Installed:

STB: 502

PT: no stamped #

Comments:

Certification #:

Septic Tank Date: 05/22/2022

Pump Tank Date: 05/20/2022

This system has been installed in compliance with applicable NC General Statutes, Rules for Sewage Treatment and Disposal, and all conditions of the Improvement Permit and Construction Authorization.

PERMIT CONDITIONS:

I. Performance: System shall perform in accordance with Rule .1961.

II. Monitoring: As required by Rule .1961.

III. Maintenance: Ground absorption sewage treatment and disposal systems shall be checked, and the contents of the septic tank removed, periodically from all compartments, to ensure proper operation of the system. The contents shall be pumped whenever the solids level is found to be more than 1/3 of the liquid depth in any compartment.

Other:

Subsurface Operator Required: ☐ Yes ☒ No

If yes, see attached sheet for additional operation conditions, maintenance and reporting.

Operation:

Other:

Authorized State Agent: Jones, Lori

Date of Issue: 08/04/2022

Owner/Applicant: _____


3:30/4:00

LEXUS
801 300
6321

2014

Manifold
230-240 Supply

Today

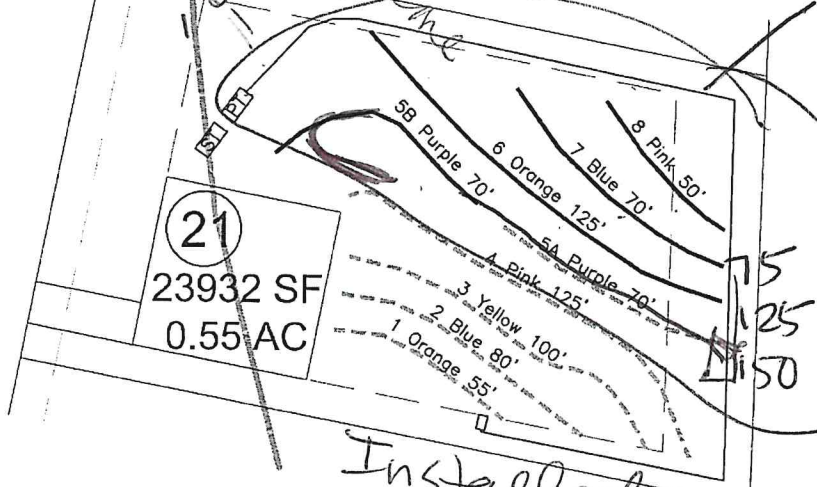

New design on lot.

Installed Repair Area (switched)
Old design

As built from new design

- *Keep tanks and drain lines 10' from property lines.
- *Not a survey.
- *Not a guarantee of a septic permit.
- *Keep supply lines >5' from property lines.
- *Some lines are flagged longer in the field than lengths indicate.
- *No grading septic area.

System: ☐ Repair: ☒

Patio addition was reason for change

System: Pressure Manifold
Lines: 1-5A, (430')
Accepted Status System
0.3 Soil LTAR
24" Trench Bottom

Repair: T&J Panel
Lines: 5B-8, (315')
Accepted Status System
0.3 Soil LTAR
30" Trench Bottom

GRAPHIC SCALE
1" = 50'



Central Carolina Soil Consulting, PLLC
1900 South Main Street, Suite 110
Wake Forest, North Carolina 27587
Phone (919)569-6704 Fax (919)569-6703

4-Bedroom Septic Layout
Lot 21, High Croft Subdivision
Franklin County, North Carolina

Job# : 2243
Drawn By : JR
Date : 11/05/2018
Revision: