



OPERATION PERMIT

Franklin County Health Department
107 Industrial Drive
Louisburg, NC 27549
Phone:

For Office Use Only

*CDP File Number 354136 - 1

County ID Number: 1881-86-5588

Evaluated For: NEW

Lisa Ferguson 105 Teal Drive

Property Owner: LGI HOMES

Address: 1450 LAKE ROBBINS DRIVE

Road #:

City: THE WOODLANDS

State/Zip: TX/ 77380

Phone #:

Township:

Subdivision: BAILEY FARMS

Phase : NEW

Lot: 59

Structure: SINGLE FAMILY

of Bedrooms: 3

of People: 3

Water Supply: N/A

Saprolite System?: ☐ Yes ☒ No

Pump Required?: ☐ Yes ☒ No

Design Flow: 360

System Classification/Description: TYPE II A. CONV SYSTEM
(SINGLE-FAMILY OR 480 GPD OR LESS)

Installer:

Certification #:

Specific System UNKNOWN

Installed:

Septic Tank Date: 07/28/2021

STB: 1000

Pump Tank Date: _____

PT:

Comments:

This system has been installed in compliance with applicable NC General Statutes, Rules for Sewage Treatment and Disposal, and all conditions of the Improvement Permit and Construction Authorization.

PERMIT CONDITIONS:

I. Performance: System shall perform in accordance with Rule .1961.

II. Monitoring: As required by Rule .1961.

III. Maintenance: Ground absorption sewage treatment and disposal systems shall be checked, and the contents of the septic tank removed, periodically from all compartments, to ensure proper operation of the system. The contents shall be pumped whenever the solids level is found to be more than 1/3 of the liquid depth in any compartment.

Other:

Subsurface Operator Required: ☐ Yes ☒ No

If yes, see attached sheet for additional operation conditions, maintenance and reporting.

Operation:

Other:

Authorized State Agent: Bendel, Joel

Date of Issue: 10/06/2021

Owner/Applicant: _____



File # 354136 PIN# _____

Property Address: 105 Teal Dr.

Applicant or Owner Name: Lisa Ferguson

Environmental Health Septic/Well Permit Diagram

Building permits cannot be issued nor should construction begin without Construction Authorization issuance.

☒ Septic Improvement Permit ☒ Septic Construction Authorization (CA) ☐ CA Reissue** ☒ As Built
☐ Well Construction Authorization ☐ Additional Diagram/Specifications Attached

Diagram Date**: 5-17-21 EHS: Joel Bendel


**Any previously dated CA diagram is revoked and/or invalid. Confirm this is the valid diagram for the site before beginning any construction.

Installation/grouting inspections may be scheduled the day before, or, the day of installation until 9am by contacting the Environmental Health office at 919 496 8100. A revisit fee may apply if installation is not ready for inspection at the time requested. Septic Operations Permits will be issued after installation is approved, all permits conditions are met, and any outstanding fees are paid. Well Certificate of Completion will be issued after well head approval, all permit conditions are met, and any outstanding fees are paid.

Septic Tank 1000 Pump Tank 1000 Drainfield 3'x300' Type System Pto Acc Max Trench Depth 20"

Septic Contractor _____ Septic/Pump tank dates _____ Pump fee? ☒ Yes ☐ No

Well Contractor _____ Well Grout date: _____

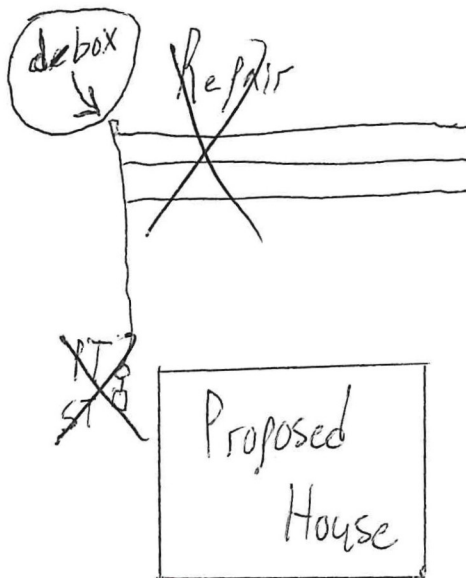

19 Panels - 1st line
29 Panels - 2nd line
17 Panels - 3rd line
10 Panels - 4th line (Far back)

