

File# 388662PIN# 2831-80-3567Property Address: 125 Oswego DriveApplicant Or Owner Name: Yandry Mastromihalis
Nate Mullins**Environmental Health Septic/Well Permit Diagram**

Building permits cannot be issued nor should construction begin without Construction Authorization issuance.


☐ Septic Improvement Permit ☐ Septic Construction Authorization (CA) ☒ CA Reissue** ☒ As Built
☐ Well Construction Authorization ☐ Additional Diagram/Specifications Attached

Diagram Date**: 11-20-24EHS: Cybil Ene****Any previously dated CA diagram is revoked and/or invalid. Confirm this is the valid diagram for the site before beginning any construction.**

Installation inspections may be scheduled the day before or the day of installation by 9am. Contact the Environmental Health office at 919 496-8100. A revisit fee may apply if installation is not ready for inspection at the time requested. SEPTIC OPERATIONS PERMITS will be issued after installation is approved, all permit conditions are met, and any outstanding fees are paid. WELL CERTIFICATE OF COMPLETION will be issued after well head approval, all permit conditions are met, and any outstanding fees are paid.

Septic Tank 1000 Pump Tank 1000 Drain field 3'x400' Type System PtoA/C Max trench depth 24"Septic Contractor Avila Construction Septic/Pump tank dates PT MCP 1000
ST MCP 1000 PUMP FEE PAID pd 6/2/25
CBE

Well Contractor _____ Well Head Date: _____ PUMP FINAL: _____ N/A (CIRCLE)

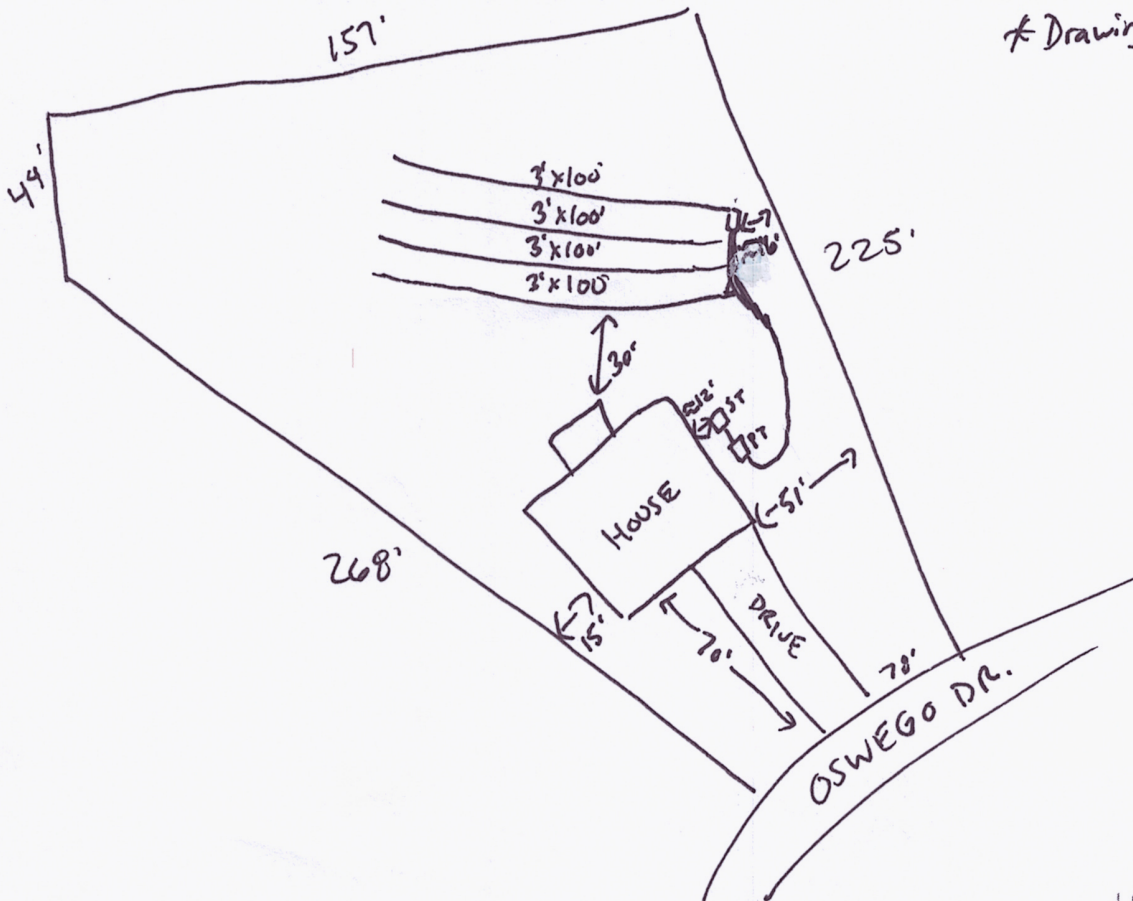

Joel Bendel
✓ id tanks + lines
4-22-25

✓ id pump, floats,
alarm, + d box
6-2-25