

FRANKLIN COUNTY HEALTH DEPARTMENT

PERMIT NUMBER: 142740- CONST IMPROVE PERMIT 20000719	DATE: 3/3/20	SIZE: 1.09A
APPLICANT: OLSON PAUL F 6040-A SIX FORKS RD RALEIGH NC 27609	OWNER: OLSON PAUL F 6040-A SIX FORKS RD RALEIGH NC 27609	
TELEPHONE: 790-1490		
COMMENT: SFD	DESCRIPTION: 5 YEAR ☒	LIFETIME: ☐
LOCATION / DIRECTIONS: WOODCROFT #31 - 190 WOODCROFT DR YNG Off Sid Mitchell Rd.		
FEE: 175.00	SIGNATURE OR OWNER OR AUTHORIZED AGENT:	


THE ABOVE SIGNATURE INDICATES THAT I HAVE READ, UNDERSTAND, AND AGREE WITH ALL PROVISIONS AND INFORMATION AS OUTLINED ON THE BACK SIDE OF THIS FORM

TOPO <u>S</u>	TEXTURE <u>PS</u>	STRUCTURE <u>PS</u>	DEPTH <u>PS</u>
R. HOR <u>✓</u>	SOIL. WET <u>CS</u>	AVAIL. SP <u>✓</u>	OTHER <u>✓</u>
MINRL <u>S</u>	OVERALL <u>PS</u>	LTAR <u>35</u>	
#BEDRMS <u>3</u>	GPD <u>360</u>	DISPOSAL <u>✓</u>	TYPE. SYS <u>Coar.</u>
SZ. TANK <u>900</u>	SZ. CHAM <u>✓</u>	NITRIFI <u>3'x350' 45% S</u>	TYPE. WAT <u>well</u>
SITE. LOC <u>✓</u>	MAX TRENCH DEP <u>24"</u>	TYP. FAC <u>SFD</u>	

REMARKS: Clear lot for Construction Authorization and lot layout.
Call the Health Dept. when this is done.

CONTRACTOR: Triangle Pump & Tank
TANK MANUF: Ellis 900gal
MANUF DATE: 03-21-00

*Stay 100' from well, 5' from foundation
10' from property lines
Run drain lines with contour.
Infiltrator system
42 panels less than 3/4" fall each line

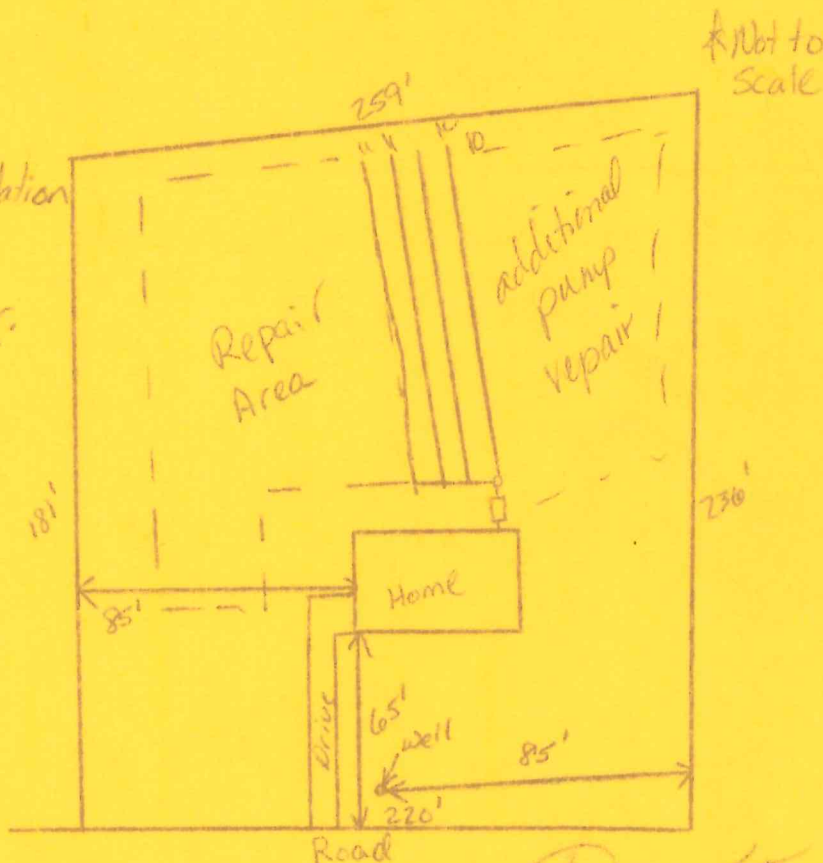

IMPROVEMENT PERMIT DATE: 7/20/00

CONSTRUCTION AUTHORIZATION DATE: 8/8/00

OPERATION PERMIT DATE: 11/08/00

ENV HEALTH SPEC: Dustin G. [Signature]

ENV HEALTH SPEC: Dustin G. [Signature]

ENV HEALTH SPEC: Heather [Signature]

COUNTY OF FRANKLIN

ENVIRONMENT HEALTH APPLICATION (496-8100)

Permit #: 00-15634

Permit Type: EH

14274c

Date Issued: 07-11-00

Project Address: 190 WOODCROFT DR, YOUNGSVILLE

Location: 190 WOODCROFT DR, YOUNGSVILLE

Subdivision: WOODCROFT

Lot #: 31

Size: 1.09

Owner Name: OLSEN, PAUL F.

Phone: (919)-790-1490

Address: 6040-A SIX FORKS RD

City: RALEIGH

State: NC Zip: 27609

Contractor: OLSON, PAUL F.

Phone: (919)-790-1491

Address: 6040-A SIX FORKS ROAD

City: RALEIGH

State: NC Zip: 27609

Proposed use: OLSEN, PAUL F.

Work: SFD

Desc:

Valuation:	Fees due: \$ 175.00	Fees Paid: \$ 175.00
Zoned: AR	Setbacks Front: 30	Rear: 25 Side: 10
Tax Rec #: 33320	Pin #:	Parcel#: B05 C00 031
Township: YNGS	Public Water/Sewer:	ST Road #:

Special conditions:

of bedrooms: 3


of bathrooms: 2.5

Approved for Issuance by

ED

I certify that all the statements made in this application and any attached documents are true, complete and correct to the best of my knowledge and belief and are made in good faith. I understand that false information may be grounds for rejection of this application. Authorized county representatives are granted right of entry to make evaluations or inspections and to release information upon public request.


Call Environment Health (496-8100) between 8:00 AM and 9:00 AM Monday thru Friday to schedule an appointment with the environment health specialist to evaluate your lot. He/She will show you where to locate the well and septic system, in relation to the desired dwelling location and any property lines. If approved, an improvements permit will be issued. After the septic tank has been installed and approved, the Sanitarian will issue a certification of completion.

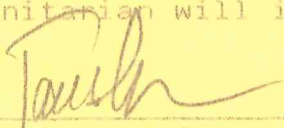

(Signature of Contractor or Authorized Agent)

7 / 12 / 2007

Date

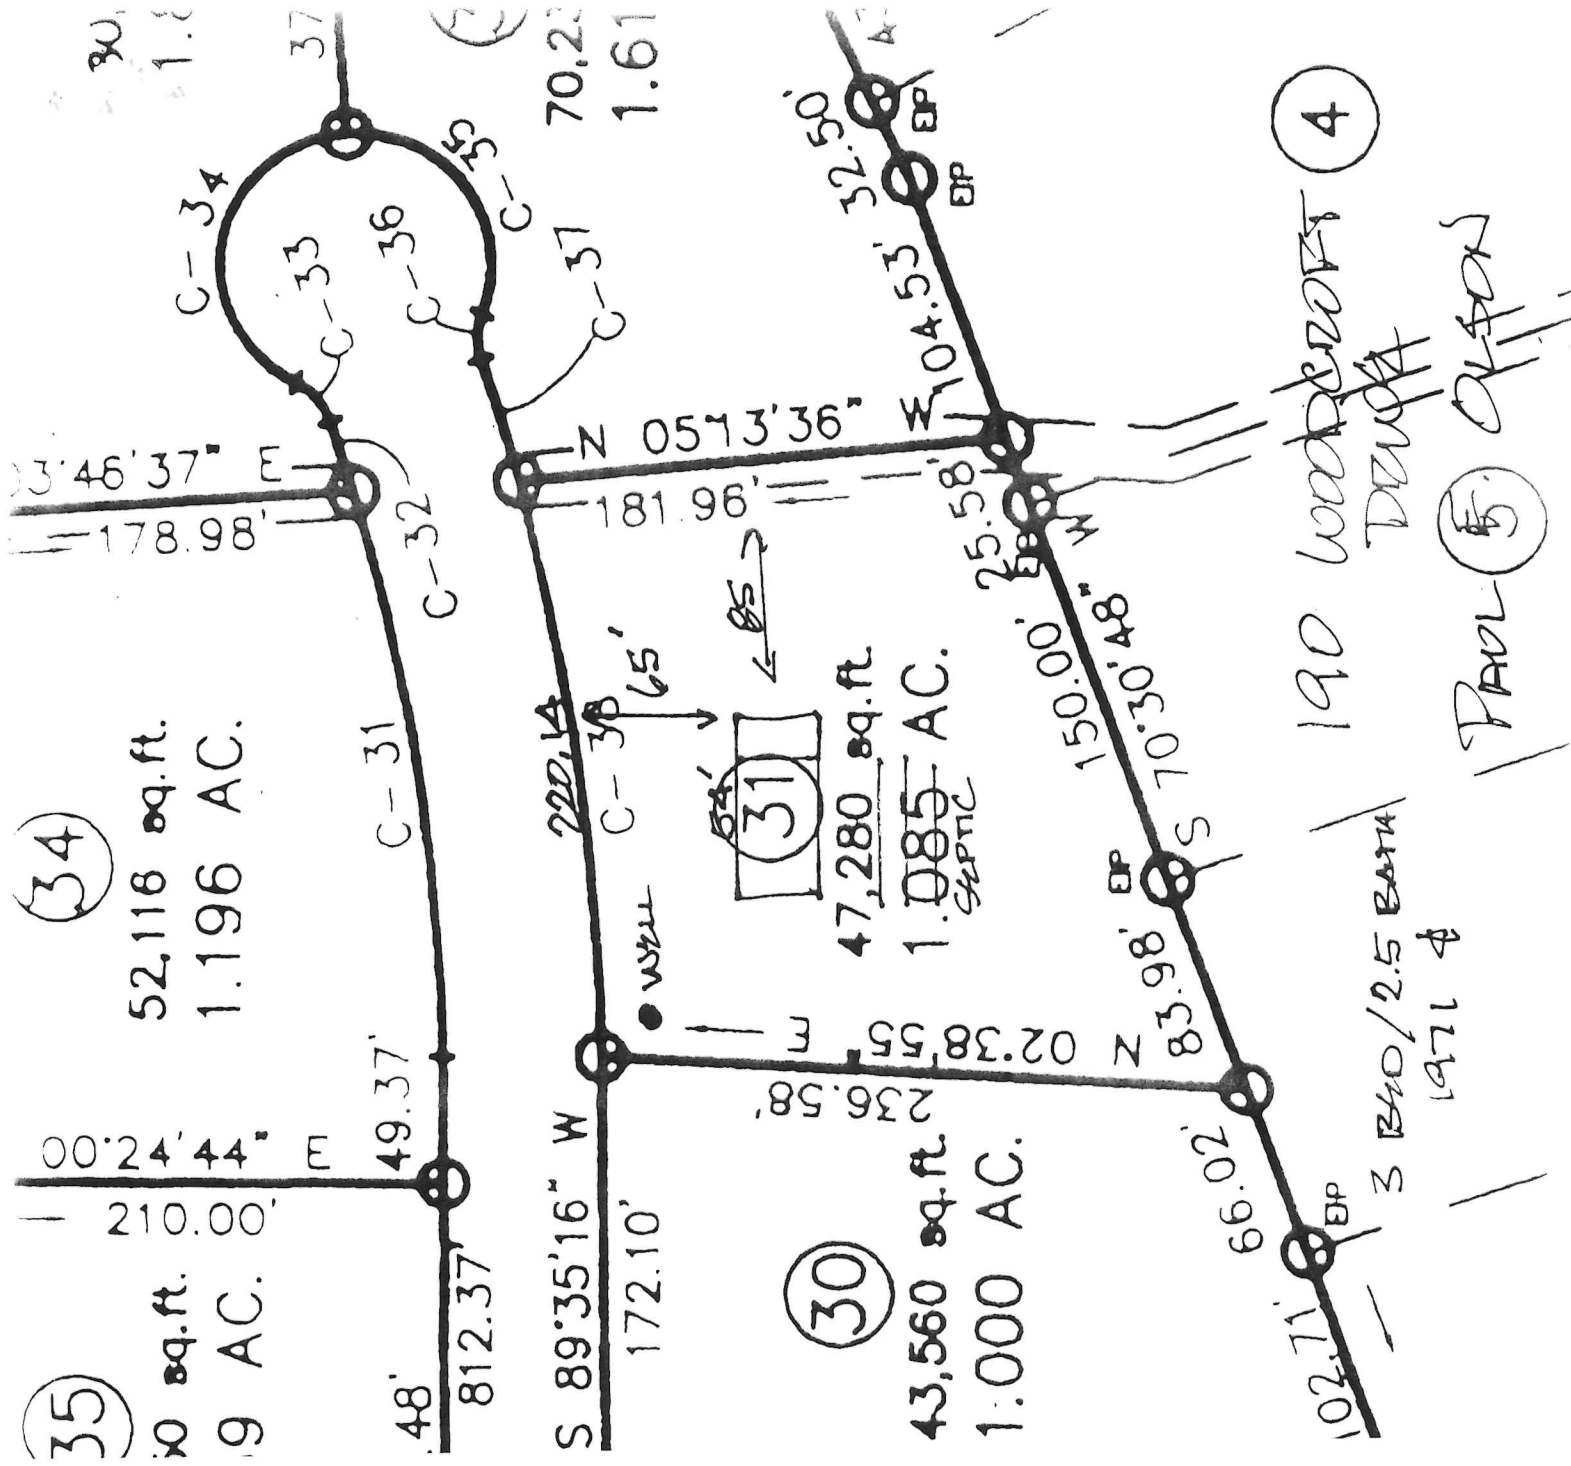

DEPARTMENT OF ENVIRONMENT,
HEALTH & NATURAL RESOURCES
DIVISION OF ENVIRONMENTAL HEALTH

COUNTY: _____ SHEET _____ OF _____
PROPERTY I.D. # _____
TAX #: _____
DATE: _____

OWNER: Paul Olson
WATER SUPPLY: _____
LOCATION: Woodcroft #31

		PROFILES									
TESTS		1	2	3	4	5	6	7	8	9	10
SCAPE POSITION	.1940	SS									
PERCENT (%)	.1940	8%									
ZON 1 DEPTH	.1943	0-6"									
TEXTURE	.1941 (a)(1)	SLL									
PERSISTENCE	.1941	FR									
STRUCTURE	.1941 (a)(2)	GRK									
MINERALOGY	.1941 (a)(3)	SEMP									
ZON 2 DEPTH	.1943	6"-36"									
TEXTURE	.1941 (a)(1)	C									
PERSISTENCE	.1941	FR-FI									
STRUCTURE	.1941 (a)(2)	GRK									
MINERALOGY	.1941 (a)(3)	SEMP									
ZON 3 DEPTH	.1943										
TEXTURE	.1941 (a)(1)										
PERSISTENCE	.1941										
STRUCTURE	.1941 (a)(2)										
MINERALOGY	.1941 (a)(3)										
ZON 4 DEPTH	.1943										
TEXTURE	.1941 (a)(1)										
PERSISTENCE	.1941										
STRUCTURE	.1941 (a)(2)										
MINERALOGY	.1941 (a)(3)										
SETBACK	.1942										
ACTIVE HORIZON	.1944										
DATE	.1943/.1956										
CLASSIFICATION	.1948	B									
LOAD (gpd/ft2)	.1955	135									

FACTORS (.1946):	SITE LTAR (gpd/ft2):
AVAILABLE SPACE (.1945):	
CLASSIFICATION (.1948):	
INSTALLED BY:	SYSTEM TYPE:
REMARKS:	OTHERS PRESENT: