

FRANKLIN COUNTY HEALTH DEPARTMENT

PERMIT NUMBER: <u>167286</u>	DATE: <u>20020812</u>	SIZE: <u>1.099A</u>
APPLICANT: RATASKI NANCY N & CHRISTOP 105 CEDAR CREEK LAND YOUNGSVILLE NC 27596 TELEPHONE: <u>801-9743</u> <u>556-2397</u>		OWNER: RATASKI NANCY N &
COMMENT: <u>SFD</u>		DESCRIPTION: 5 YEAR ☒ LIFETIME: ☐
LOCATION / DIRECTIONS: <u>Corner of Hicks & Cedar Creek Ln.</u>		
FEE: <u>225.00</u>		SIGNATURE OR OWNER OR AUTHORIZED AGENT:

THE ABOVE SIGNATURE INDICATES THAT I HAVE READ, UNDERSTAND, AND AGREE WITH ALL PROVISIONS AND INFORMATION AS OUTLINED ON THE BACK SIDE OF THIS FORM

TOPO <u>PS</u>	TEXTURE <u>PS</u>	STRUCTURE <u>PS</u>	DEPTH <u>PS</u>
R. HOR <u>PS</u>	SOIL. WET <u>PS</u>	AVAIL. SP <u>PS</u>	OTHER <u>PS</u>
MINRL <u>PS</u>	OVERALL <u>PS</u>	LTAR <u>0.26</u>	
#BEDRMS <u>2</u>	GPD <u>240</u>	DISPOSAL	TYPE. SYS <u>Conv.</u>
SZ. TANK <u>900 gal</u>	SZ. CHAM	NITRIFI <u>3'x300'</u>	TYPE. WAT <u>P.W.</u>
ITE. LOC	MAX TRENCH DEP <u>30"</u>	TYP. FAC <u>SFD</u>	

REMARKS: * DRAWING Not to Scale

EXACT TANK & Drain Field LOCATION May Vary Slight!
ONCE LOT IS CLEARED

RACTOR: ADM Construction

TANK MANUF: Ellis 900


MANUF DATE: 3/18/03

*Septic TANK
will be Slightly
Above Ground!

* Lines May
be Installed on
8' Centers to Min
TANK Being out
OF Ground!

* Install Drain Field
Along Contour &
System IN DRY
Conditions!

* Do Not PARK or
Drive over System
AREA!

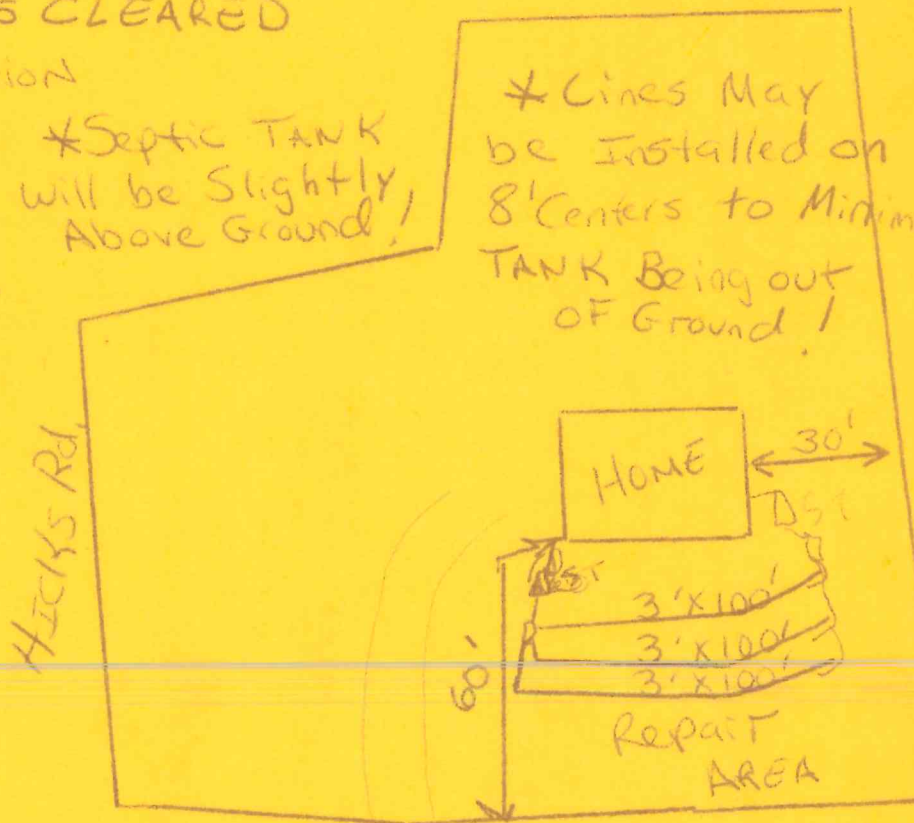

IMPROVEMENT PERMIT DATE: 8/14/02

CONSTRUCTION AUTHORIZATION DATE: 8/14/02

OPERATION PERMIT DATE: 6/13/03

ENV HEALTH SPEC: Andy Smith

ENV HEALTH SPEC: Andy Smith

ENV HEALTH SPEC: Andy Smith

COUNTY OF FRANKLIN

ENVIRONMENT HEALTH APPLICATION (496-8100)

Permit #: 7633

Permit Type: SEPTIC PERMIT

Date Issued: 08/13/2002

Project Address: ,

Location:

16728C

Lot #: 1

Subdivision:

Size #: 1.099

Applicant: RATASKI NANCY N & CHRISTOPHER
105 CEDAR CREEK LANE
YOUNGSVILLE NC 27596

Phone: 556-2397

Contractor:

Phone:

Proposed Use: SFD

Work:

Desc:

Bldg Cost: \$0 Fees Due: \$225.00 Date Paid: 08/13/2002

Zoned: A R Setbacks Front: 30 Rear 25 Side 10

Tax record: 9675

Pin #: 1864-16-2447

Parcel #: D04 00 031

Township: FRANKLINTO Public Water/Sewer: PRIVATE

ST Road #:

Special Conditions/Property Owner: RATASKI NANCY N &

of bedrooms: 2

of people:

2

Approved for Issuance by:

** Environmental Health Use Only **

Type Wastewater - Sewage: _____ Industrial Process Wastewater: _____

Type Water Supply - Private: _____ Community: _____

Previously Identified Jurisdictional Wetland - Yes: _____ No _____

I certify that all the statements made in this application and any attached documents are true, complete and correct to the best of my knowledge and belief and are made in good faith. I understand that false information may be grounds for rejection of this application. Authorized county representatives are granted right of entry to make evaluations or inspections and to release information upon public request.

Call Environment Health (496-8100) between 8:00 AM and 9:00 AM Monday thru Friday to schedule an appointment with the environment health specialist to evaluate your lot. He/She will show you where to locate the well and septic system, in relation to the desired dwelling location and any property lines. If approved, an improvements permit will be issued. After the septic tank has been installed and approved, the Sanitarian will issue a certification of completion.

Nancy N Rataski
(Signature of Contractor, Authorized Agent or Owner)

Date

8/13/02

Franklin County Zoning Permit

FRANKLIN COUNTY

Franklin County, North Carolina

Planning Department

215 E Nash Street, Louisburg, North Carolina 27549

496-2909

Zoning Permit Number: 5623



ADDRESS:

PARCEL NO.: 1864-16-2447

ZONING: A R

SUBDIVISION:

LOT: 1

ISSUED TO:

RATASKI NANCY N & CHRISTOPHER

105 CEDAR CREEK LANE

YOUNGSVILLE NC 27596

SETBACK: FRONT: 30

RIGHT: 10

LEFT: 10

REAR: 25

COUNTY WATER: N/A

FLOODPLAIN: N/A

PERMIT TYPE:

ZONING PERMIT

DETAILS:

SFD

PERMIT DATE: 08/13/2002

WATERSHED N/A

FEE: \$0.00

TOWNSHIP FRNK

EXPIRE DATE: 02/13/2003

It is hereby certified that the above use as shown on the plats and plans submitted with the application conforms with all applicable provisions of the Franklin County Zoning Ordinance. The issuance of this Permit does not allow the violation of Franklin County Zoning Ordinances or other governing Regulations.

The applicant is responsible for obtaining a building permit (if required) prior to commencing work on the proposed improvement. A final zoning inspection must be scheduled by the applicant.

APPROVED BY:

DATE:

Dana Wood

08/13/2002

Zoning Inspector

I hereby certify that all information I have provided to the Planning Department is true and accurate.

APPLICANTS SIGNATURE:

Nancy N Rataski

PLAT IS APPROVED FOR RECORDING PURSUANT TO SECTION _____ OF THE FRANKLIN COUNTY SUBDIVISION REGULATIONS.

DIVISION ADMINISTRATOR _____ DATE _____

W OFFICER'S CERTIFICATE
FRANKLIN COUNTY, NORTH CAROLINA
REVIEW OFFICER OF
FRANKLIN COUNTY CERTIFY THAT THE MAP OR PLAT TO WHICH
CERTIFICATION IS AFFIXED MEETS ALL STATUTORY
REQUIREMENTS FOR RECORDING.

W OFFICER _____ DATE _____

FRANKLIN COUNTY
JAMES O. MURPHY, CERTIFY THAT THIS PLAT WAS DRAWN UNDER MY
SUPERVISION FROM AN ACTUAL SURVEY MADE UNDER MY SUPERVISION
(DESCRIPTION RECORDED IN BOOK 895, PAGE 694, ETC.)
(NOTE: THAT BOUNDARIES NOT SURVEYED ARE CLEARLY INDICATED
HEREIN); THAT INFORMATION FOUND IN REFERENCES LISTED HEREON;
THE RATIO OF PRECISION AS CALCULATED IS 1/10,000+;
THIS PLAT WAS PREPARED IN ACCORDANCE WITH G.S. 47-30
AND IS RECOMMENDED.

LESS MY ORIGINAL SIGNATURE, REGISTRATION NUMBER, AND SEAL
31 DAY OF JULY, 2002.

James O. Murphy
SURVEYOR
PE 4884, PLS L-2253
NORTH CAROLINA
PROFESSIONAL
SEAL
2253

NOTE:
LOT -1 REV- AND ALL OTHER SOLID LINES
HEREON WERE SURVEYED 7-31-02. ALL
OTHER LINES SHOWN HEREON AS BROKEN
LINES WERE TAKEN FROM RECORDS, SPECIFICALLY

LINDA H. STONE, REGISTER OF DEEDS
FRANKLIN COUNTY, NORTH CAROLINA
FILED FOR REGISTRATION
DATE _____ TIME _____

