

Granville-Vance District Health Department
Environmental Health

Pin _____

Permit Number 2183 (septic)

☒ Improvement Permit


☒ Construction Authorization 3135 (well)

Site Sketch

Cornie Ross / LG Homes
Applicants Name
[Signature]
Authorized State Agent

931 Weatherby Ln / Weatherby lot #11
Subdivision - Section - Lot
2-20-20
Date

System components represent approximate contours only. The contractor must flag the system prior to beginning the installation to insure that proper grade is maintained.

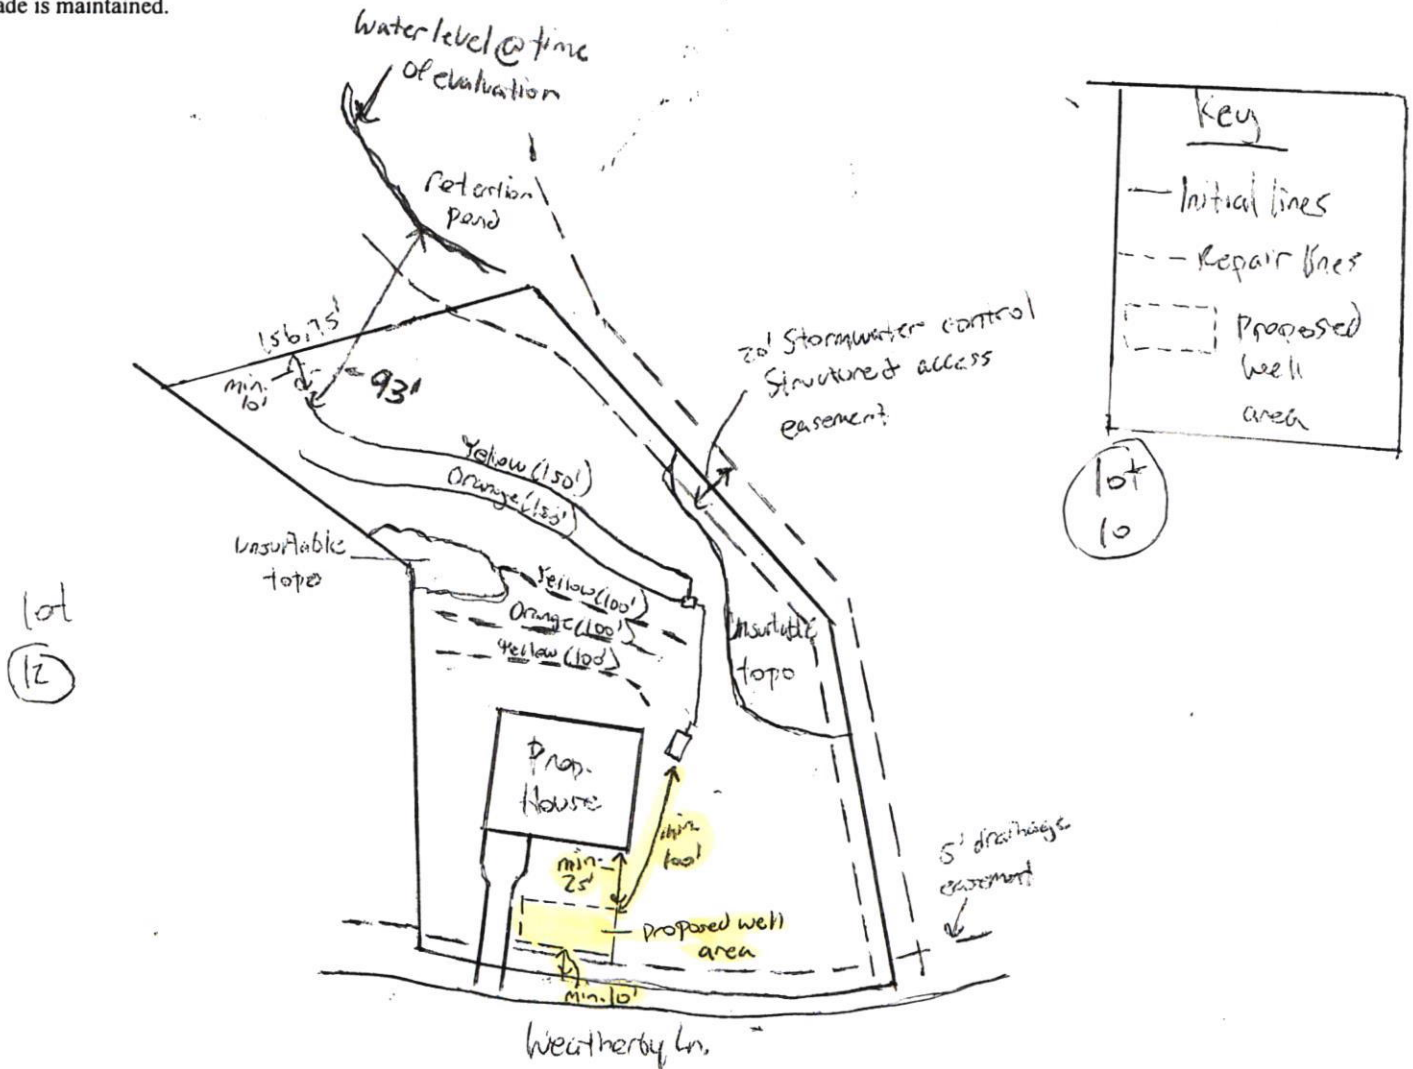

- Notes:
- o Stay off all easements w/ septic & well
 - o system/initial/repair laid out in field by RETHS
 - o Stay off unsuitable topography
 - o Keep drainlines min. 10' off property lines
 - o min. 50' off retention pond

- Stay off all easements!
- Stay off bad topography
- System (initial/repair) layed in field by RETS
- Do not install/call for inspection in wet conditions
- Maintain all setbacks
- 50' min. off retention pond, creeks, streams

DATE: 2-20-20

ISSUED BY: *W. B.*

Unless otherwise indicated, the same conditions above apply regarding system type, layout, location and installation requirement.

(The wastewater system cannot be installed until authorization is signed)

Comments: Contractor to establish & follow contour

Environmental Health Specialist:

Construction Authorization Addendum ☒ Yes ☐ No

DATE: 7/5/20

Quality Service

ISSUED BY:

PERFORMANCE, MONITORING, MAINTENANCE AND OPERATION
AS REQUIRED BY RULE .1961

Granville - Vance District Health Department

Environmental Health

3135

Well Construction Permit

Owner/Applicant: LGI Homes/Connie Ross

Date: 2-20-20

Address or Location of Property: 931 Weatherby Ln.

Subdivision & Lot #: Weatherby II

Septic Permit #: 2183

Zoning Permit #: 21524

Environmental Health Specialist: [Signature]

This well permit is to locate and site the area that a private groundwater well may be established on the property listed above by the Environmental Health Specialists of Granville County. If one does not locate the well in the approved area and complete the well as specified by the 15A NCAC .02C rules, then permits may be revoked. At completion of drilling of the well, grout must be witnessed by EHS and a well log turned into Environmental Health.

Minimum Setbacks: (these are the main setbacks, but not all required setbacks)

Setback from property lines – 10 ft

Setback from septic tank and drain field, including repair area – 100 ft

Setback from structural foundations – 25 ft

Setback from ponds, lakes or other bodies of water – 50 ft

Site Sketch:

See
attached

0 Stay off all easements

Conditions: min. 100' off any part of septic (including
neighboring lots)
025' min. off base foundations
010' min. off property lines
0 maintain all setbacks

Authorized Agent: [Signature]

Date: 2-20-20

1 Well Grout: (Circle or write in)

Witnessed: Yes or No EHS Agent: [Signature]

Date: 2-8-20 Annular Space Open: Yes or No

Over reamed: Yes or No Depth Grouted: 20'

Method: Pump ☒ Poured ☐ Pressure

Well Log received: Yes or No (EHS to Attach to Permit)

Driller Name: Southern Well Cert. #

Depth: 400' Casing Depth: 95' GPM: 20

As Built Drawing:

2 Well Final: (Place a check mark when finalized)

Seal Present and Intact: ☒ Air Vent: ☒

Hose Spigot: ☒ Electrical Box: ☒

Pump Installer Tag: ☒ Well Installer Tag: ☒

All holes sealed: ☒ 12" above grade: ☒

Comments:

3 Well Completion Permit: [Signature] EHS

Date Completed: 9/11/20

4 Water Samples Taken: Date:

EHS: Results:

Retest: Results: