



OPERATION PERMIT

Franklin County Health Department
107 Industrial Drive
Louisburg, NC 27549
Phone:

For Office Use Only

*CDP File Number 302254 - 1
County ID Number: 1846-84-6784
Evaluated For: NEW

Property Owner: PINNACLE HOME BUILDERS

Address: 210 BARNHILL LN

Road #:

City: WAKE FOREST

State/Zip: NC/ 27587

Phone #: (919) 291-7000

Township:

Subdivision:

Phase : NEW

Lot: 1

Structure: SINGLE FAMILY

of Bedrooms: 3

of People: 3

Water Supply: NEW WELL

Saprolite System?: ☐ Yes ☒ No

Pump Required?: ☐ Yes ☒ No

Design Flow: 360

System Classification/Description: TYPE II A. CONV SYSTEM
(SINGLE-FAMILY OR 480 GPD OR LESS)

Installer: Clay Breedlove

Certification #: 5699

Specific System 25% REDUCTION INNOVATIVE OR ACCEPTED

Installed:

STB: 392

PT:

Comments:

Septic Tank Date: 12/23/2019

Pump Tank Date: _____

This system has been installed in compliance with applicable NC General Statutes, Rules for Sewage Treatment and Disposal, and all conditions of the Improvement Permit and Construction Authorization.

PERMIT CONDITIONS:

I. Performance: System shall perform in accordance with Rule .1961.

II. Monitoring: As required by Rule .1961.

III. Maintenance: Ground absorption sewage treatment and disposal systems shall be checked, and the contents of the septic tank removed, periodically from all compartments, to ensure proper operation of the system. The contents shall be pumped whenever the solids level is found to be more than 1/3 of the liquid depth in any compartment.

Other:

Subsurface Operator Required: ☐ Yes ☒ No

If yes, see attached sheet for additional operation conditions, maintenance and reporting.

Operation:

Other:

Authorized State Agent: Ennis, Crystal

Date of Issue: 06/09/2020

Owner/Applicant: _____

File # 302254 PIN# 1846-84-6784

Property Address: Lot #1 Mt. Olivet Ch. Rd

Applicant or Owner Name: Pinnacle Home Builders

Environmental Health Septic/Well Permit Diagram

Building permits cannot be issued nor should construction begin without Construction Authorization issuance.

☒ Septic Improvement Permit
 ☒ Septic Construction Authorization (CA)
 ☐ CA Reissue**
 ☒ As Built
 ☒ Well Construction Authorization
 ☐ Additional Diagram/Specifications Attached

Diagram Date**: 2-3-20 EHS: Shad Leonard


**Any previously dated CA diagram is revoked and/or invalid. Confirm this is the valid diagram for the site before beginning any construction.

Installation/grouting inspections may be scheduled the day before, or, the day of installation until 9am by contacting the Environmental Health office at 919 496 8100. A revisit fee may apply if installation is not ready for inspection at the time requested. Septic Operations Permits will be issued after installation is approved, all permits conditions are met, and any outstanding fees are paid. Well Certificate of Completion will be issued after well head approval, all permit conditions are met, and any outstanding fees are paid.

Septic Tank 1000 Pump Tank N/A Drainfield 3' x 300' Type System Accepted Max Trench Depth 24"

Septic Contractor Clay Breedlove Septic/Pump tank dates 12-23-19 Pump fee? Yes ☒ No ☐
GCP 1000

Well Contractor _____ Well Grout date: _____

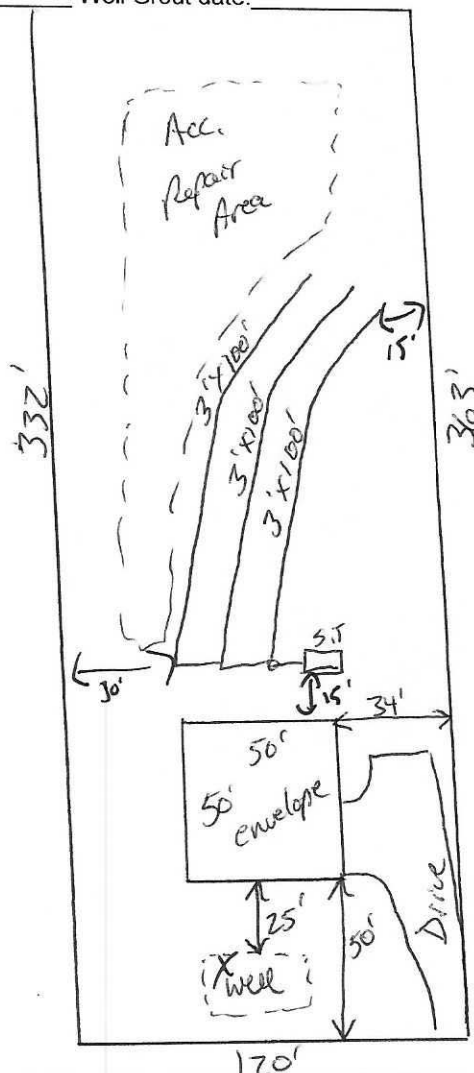

- Drawing not to scale
- Maintain all setbacks
- Install on contour.