

FRANKLIN COUNTY HEALTH DEPARTMENT


2570

PERMIT NUMBER: 53661 IMPROVEMENTS PERMIT	DATE: 11.12.93	4274-35	SIZE: .99A
APPLICANT: TURNER ASHLEY BUILDERS P O BOX 369 CLAYTON NC 27520 TELEPHONE: 553-0774	OWNER: MC ASSOCIATES		
COMMENT: SFD	CONTRACTOR: SHANE BRANTLEY		
LOCATION / DIRECTIONS: NORTH VALLEY LOT 35			
FEE: 80.00 4490		SIGNATURE OF OWNER OR AUTHORIZED AGENT:	

THE ABOVE SIGNATURE INDICATES THAT I HAVE READ, UNDERSTAND, AND AGREE WITH ALL PROVISIONS AND INFORMATION AS OUTLINED ON THE BACK SIDE OF THIS FORM

#BEDRMS 3 DISPOSAL 12 OTHER - TYPE. SYS C
SZ. TANK 900 SZ. CHAMB - NITRIFI 31350 OPER. REQ 12
SITE. LOC -

REMARKS: Shallow system 24' max! Followed along 150' from well to 10' from pipe line

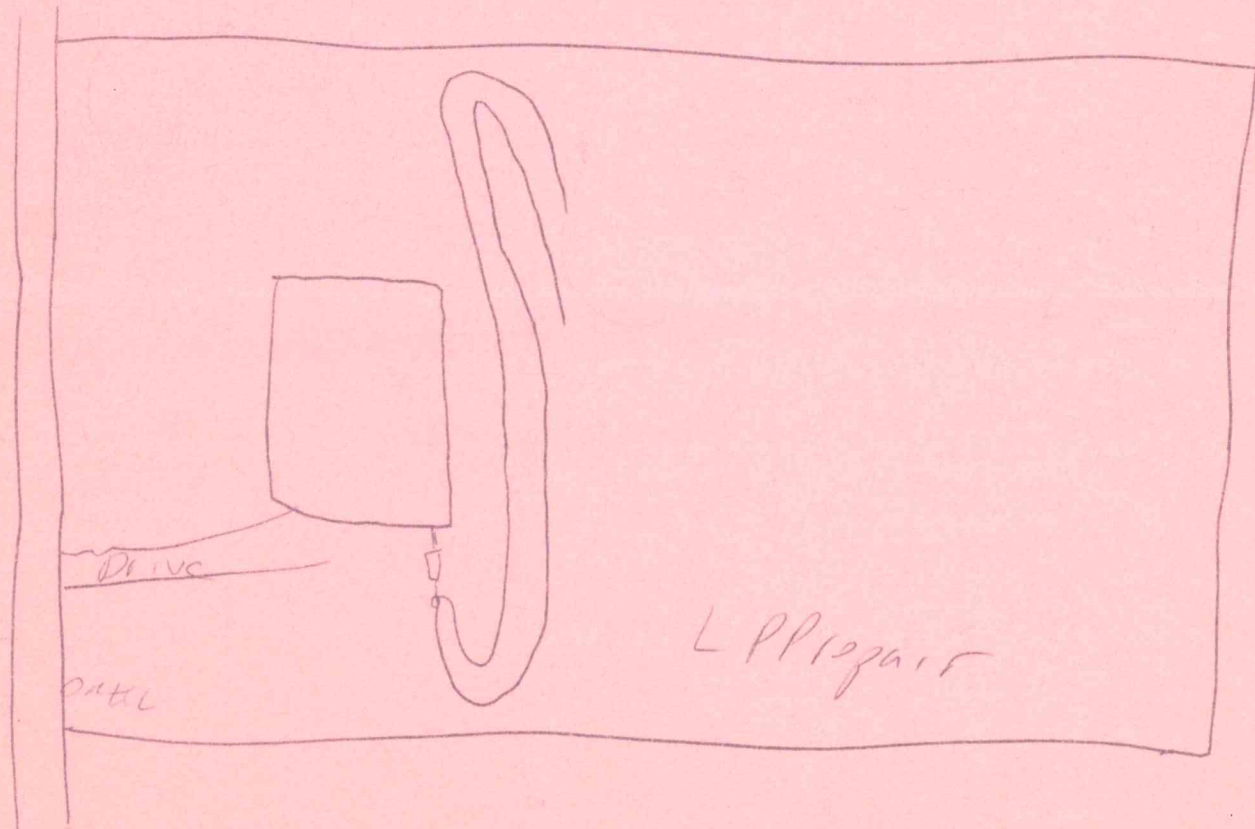

DATE. ISSUED 12-1-93

EH SPECIALIST Al Hahn

DATE. APPROVED 2-21-94

EH SPECIALIST E Glenn John