

562-8716

FRANKLIN COUNTY HEALTH DEPARTMENT

PERMIT NUMBER: 131516 CONST IMPROVE PERMIT 20030306	DATE: 2003-07-07	2003-07-07	SIZE: 10.650A
APPLICANT: KING JR GEORGE T 211 NELSON PARKWAY HAMPTON VA 23669	OWNER: LANDWORKS		
TELEPHONE: 496-3990			
COMMENT: SFD	DESCRIPTION: 5 YEAR ☐	LIFETIME: ☐	
LOCATION / DIRECTIONS: DEER TRAILS #9 - 60 DOE CROSSING DR LRG			
FEE: 225.00	SIGNATURE OR OWNER OR AUTHORIZED AGENT:		

THE ABOVE SIGNATURE INDICATES THAT I HAVE READ, UNDERSTAND, AND AGREE WITH ALL PROVISIONS AND INFORMATION AS OUTLINED ON THE BACK SIDE OF THIS FORM

TOPO <u>PS</u>	TEXTURE <u>PS</u>	STRUCTURE <u>PS</u>	DEPTH <u>PS</u>
R. HOR <u>6</u>	SOIL. WET <u>PS</u>	AVAIL. SP <u>-</u>	OTHER <u>-</u>
MINRL <u>SFXP</u>	OVERALL <u>PS</u>	LTAR <u>.35</u>	
#BEDRMS <u>3</u>	GPD <u>360</u>	DISPOSAL <u>N/A</u>	TYPE. SYS <u>Conv.</u>
SZ. TANK <u>900</u>	SZ. CHAMB <u>-</u>	NITRIFI <u>3'x350'</u>	TYPE. WAT <u>P.W.</u>
SITE. LOC <u>-</u>	MAX TRENCH DEP <u>30"</u>	TYP. FAC <u>SFD</u>	

REMARKS: Maintain setbacks (100' well, 15' Foundation, 10' property lines)

* Drawing not to scale


* ~~Install lines on contour~~ May require pump for plumbing in basement

CONTRACTOR: Triangle Pump & Tank

TANK MANUF: 21115 1000

MANUF DATE: 4/5/01

Revised Drawing

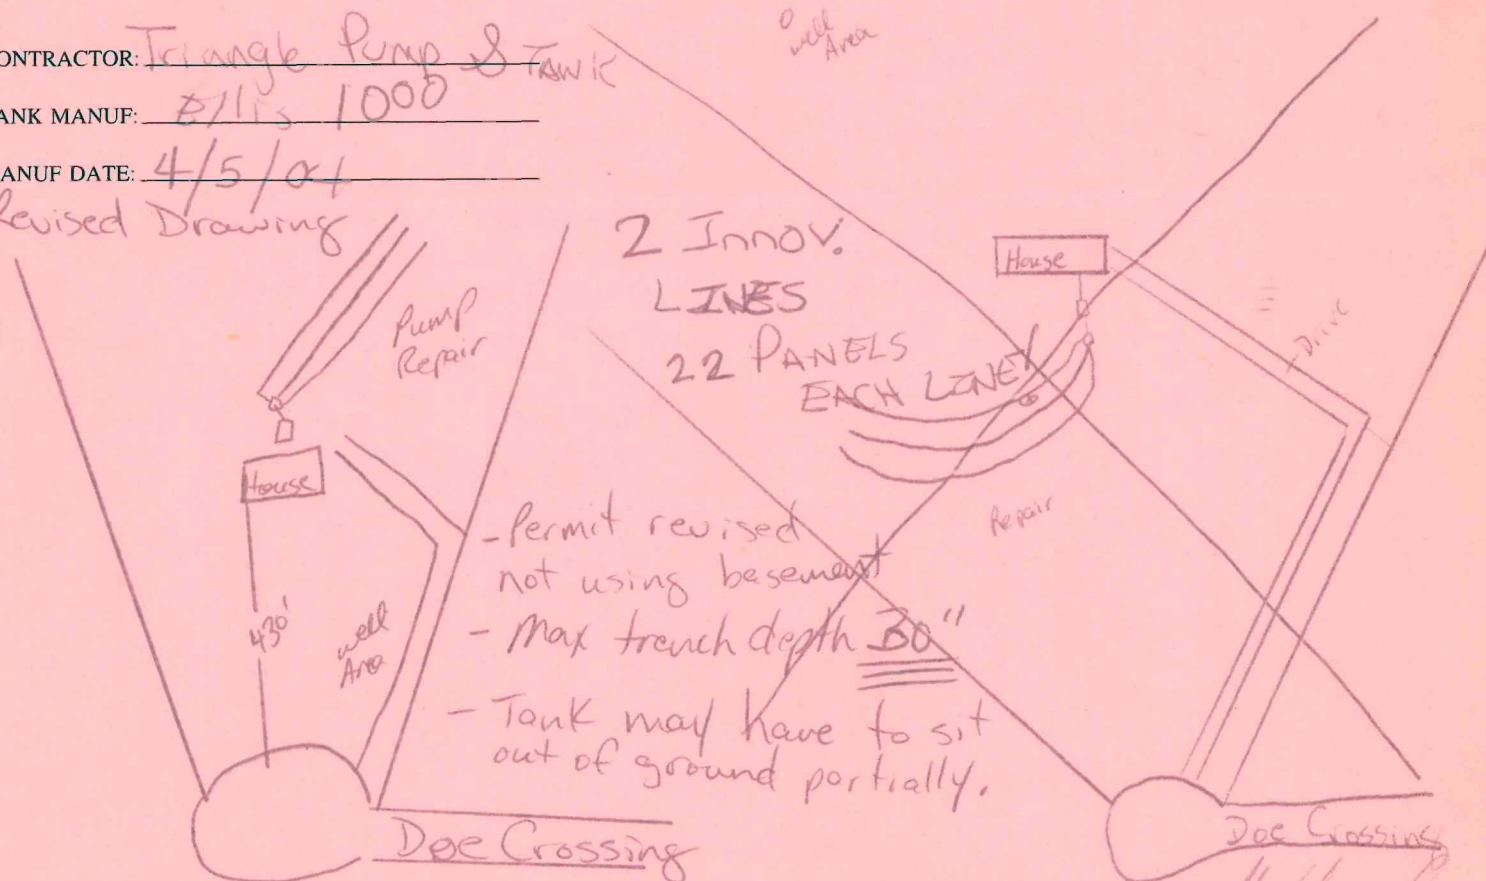

IMPROVEMENT PERMIT DATE: 3/6/03

CONSTRUCTION AUTHORIZATION DATE: 3/6/03

OPERATION PERMIT DATE: 7/19/04

ENV HEALTH SPEC: Shad Leonard

Revised 4/22/04 SEL
ENV HEALTH SPEC: Shad Leonard

ENV HEALTH SPEC: Andy Smith

COUNTY OF FRANKLIN

ENVIRONMENT HEALTH APPLICATION (496-8100)

Permit #: 8834

Permit Type: SEPTIC PERMIT

Date Issued: 03/03/2003

Project Address: 60 DOE CROSSING DR, LOUISBURG NC 27549

Location: 60 DOE CROSSING DR

Lot #: 9

Subdivision: DEER TRAILS

Size #: 10.650

Applicant: KING, JR., GEORGE T.
211 NELSON PARKWAY
HAMPTON VA 23669

Phone: 496.3990

17151C

Contractor:

Phone:

Proposed Use: SFD

Work:

Desc:

Bldg Cost: \$0	Fees Due: \$225.00	Date Paid: 03/03/2003
Zoned: AR	Setbacks Front: 30	Rear 25 Side 10
Tax record: 34973	Pin #: 2807-67-9761	Parcel #: H04 00 077M
Township: LOUISBURG	Public Water/Sewer: PRIVATE	ST Road #:
Special Conditions/Property Owner: LANDWORKS		
# of bedrooms: 3 # of people: 2 Approved for Issuance by:		
** Environmental Health Use Only **		
Type Wastewater - Sewage: _____ Industrial Process Wastewater: _____		
Type Water Supply - Private: _____ Community: _____		
Previously Identified Jurisdictional Wetland - Yes: _____ No: _____		
I certify that all the statements made in this application and any attached documents are true, complete and correct to the best of my knowledge and belief and are made in good faith. I understand that false information may be grounds for rejection of this application. Authorized county representatives are granted right of entry to make evaluations or inspections and to release information upon public request.		


Call Environment Health (496-8100) between 8:00 AM and 9:00 AM Monday thru Friday to schedule an appointment with the environment health specialist to evaluate your lot. He/She will show you where to locate the well and septic system, in relation to the desired dwelling location and any property lines. If approved, an improvements permit will be issued. After the septic tank has been installed and approved, the Sanitarian will issue a certification of completion.

 All Fees are Nonrefundable

(Signature of Contractor, Authorized Agent or Owner)

3, 3, 03

Date

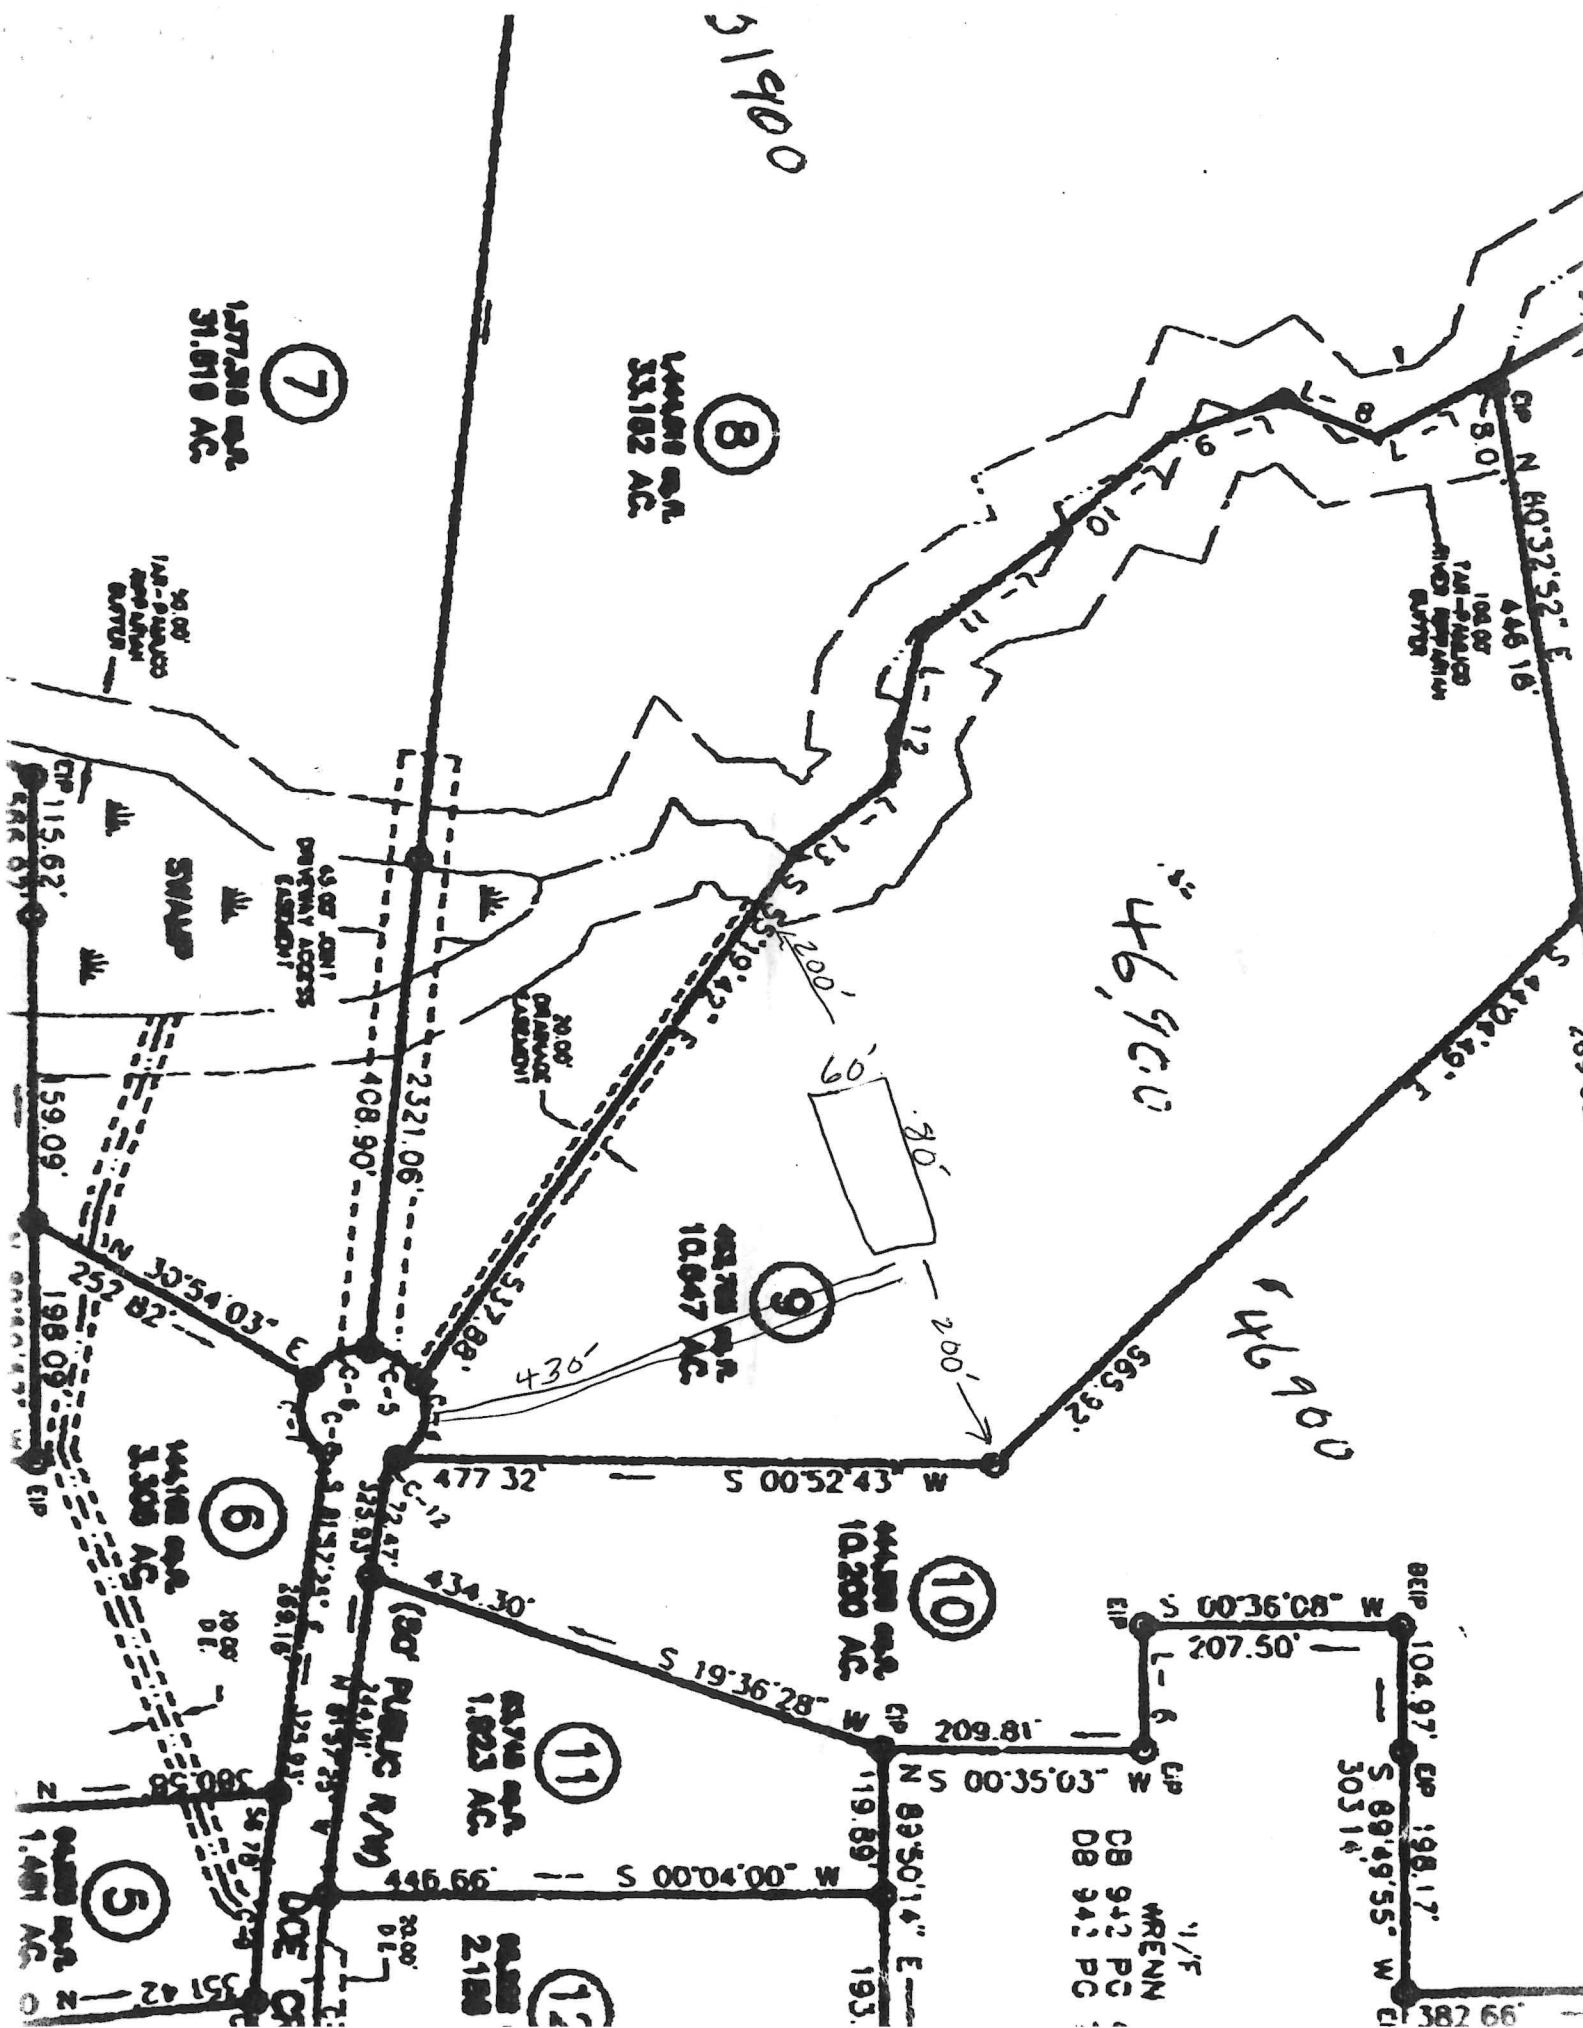

FRANKLIN COUNTY SOIL/SITE EVALUATION SHEET

APPLICANT George T King Jr
 WATER SUPPLY Prio
 LOCATION/DIRECTIONS Doe Crossing Lot #9

PROPERTY ID _____
 DATE 3/5/03

FACTORS

PROFILES

		1	2	3	4	5	6
LANDSCAPE POSITION	1940	LS	LS	LS	LS		
SLOPE (%)	1940	4%	5%	4%	5%		
HORIZON I DEPTH	1943	0-8	0-12	0-10	0-26		
TEXTURE	1941(a) (1)	SL	SL	SL	SL		
CONSISTENCE	1941	fr, ss, sp	fr, ss, sp	fr, ss, sp	fr, ss, sp		
STRUCTURE	1941(a)(2)	cr	cr	cr	cr		
CLAY MINEROLOGY	1941(a)(3)	SEXP	SEXP	SEXP	SEXP		
HORIZON II DEPTH	1943	8-28	12-38	10-36	26-42		
TEXTURE	1941(a) (1)	CL	CL	SCL	SCL		
CONSISTENCE	1941	fr, ss, sp	fr, ss, sp	fr, ss, sp	fr, ss, sp		
STRUCTURE	1941(a)(2)	SBK	SBK	SBK	SBK		
CLAY MINEROLOGY	1941(a)(3)	SEXP	SEXP	SEXP	SEXP		
HORIZON III DEPTH	1943	28-42					
TEXTURE	1941(a) (1)	fr, ss, sp					
CONSISTENCE	1941	fr, ss, sp					
STRUCTURE	1941(a)(2)	SBK					
CLAY MINEROLOGY	1941(a)(3)	SEXP					
HORIZON IV DEPTH	1943						
TEXTURE	1941(a) (1)						
CONSISTENCE	1941						
STRUCTURE	1941(a)(2)						
CLAY MINEROLOGY	1941(a)(3)						
SOIL WETNESS	1941						
RESTRICTIVE HORIZON	1944						
SAPROLITE	1943/1956						
CLASSIFICATION	1948						
LTAR (gpd/ft2)	1955	.135	.35	.35	.35		
OTHER FACTORS (1946)				SITE LTAR (gpd/ft2) .135			
AVAILABLE SPACE (1945)				SYSTEM TYPE <u>Conventional</u>			
CLASSIFICATION (1948) <u>P3</u>							
EVALUATED BY: <u>Shed Leonard</u>				OTHERS PRESENT			