



OPERATION PERMIT

Franklin County Health Department
107 Industrial Drive
Louisburg, NC 27549
Phone:

For Office Use Only

*CDP File Number 367070 - 1
County ID Number: 2830-55-0669
Evaluated For: NEW

Applicant: Carolina's Construction

Property Owner: LEES ENTERPRISE LLC
Owner Address: 280 LAKE ROYALE

City: LOUISBURG
State/Zip: NC/ 27549

Phone #:
Address: 440 SHAWNEE DR
LOUISBURG, NC 27549

Road #:
Township:
Subdivision: LAKE ROYALE
Phase : NEW Lot: 258

Structure: SINGLE FAMILY

of Bedrooms: 3

of People: 3 (max 6)

Water Supply: PUBLIC

Saprolite System?: ☐ Yes ☒ No

Pump Required?: ☐ Yes ☒ No

Design Flow: 360

System Classification/Description: TYPE III B. SYSTEM
W/SINGLE EFFLUENT PUMP

Installer: BUSY BEEZ

Certification #: 6983

Specific System CHAMBER
Installed:

STB: 646

PT:

Septic Tank Date: _____

Pump Tank Date: _____

Comments: 300' CHAMBER INSTALLED

This system has been installed in compliance with applicable NC General Statutes, Rules for Sewage Treatment and Disposal, and all conditions of the Improvement Permit and Construction Authorization.

PERMIT CONDITIONS:

I. Performance: System shall perform in accordance with Rule .1301.

II. Monitoring: As required by Rule .1301.

III. Maintenance: Ground absorption sewage treatment and disposal systems shall be checked, and the contents of the septic tank removed, periodically from all compartments, to ensure proper operation of the system. The contents shall be pumped whenever the solids level is found to be more than 1/3 of the liquid depth in any compartment.

Other:

Subsurface Operator Required: ☐ Yes ☒ No

If yes, see attached sheet for additional operation conditions, maintenance and reporting.

Operation:

Other: 300' CHAMBER INSTALLED

Authorized State Agent: Ennis, Crystal

Date of Issue: 09/30/2025

Owner/Applicant: _____



File # 367070

PIN#

Property Address: 440 Shawnee Dr.

Applicant or Owner Name: Carolina Const.

Environmental Health Septic/Well Permit Diagram

Building permits cannot be issued nor should construction begin without Construction Authorization issuance.

☒ Septic Improvement Permit ☒ Septic Construction Authorization (CA) ☐ CA Reissue** ☒ As Built
☐ Well Construction Authorization ☐ Additional Diagram/Specifications Attached

Diagram Date**: 1-10-22 EHS: Joel Bendel

**Any previously dated CA diagram is revoked and/or invalid. Confirm this is the valid diagram for the site before beginning any construction.


Installation/grouting inspections may be scheduled the day before, or, the day of installation until 9am by contacting the Environmental Health office at 919 496 8100. A revisit fee may apply if installation is not ready for inspection at the time requested. Septic Operations Permits will be issued after installation is approved, all permits conditions are met, and any outstanding fees are paid. Well Certificate of Completion will be issued after well head approval, all permit conditions are met, and any outstanding fees are paid.

Septic Tank 1000 Pump Tank 1000 Drainfield 3'X300' Type System P to Acc Max Trench Depth 30"

Septic Contractor Busy Beez Septic/Pump tank dates PT Ellis 1000
ST DB 1006 ST3 Pump fee? NO YES pd 9/26/25 Att

Well Contractor _____ Well Grout date: _____

* Refer to
attached plot
plan also

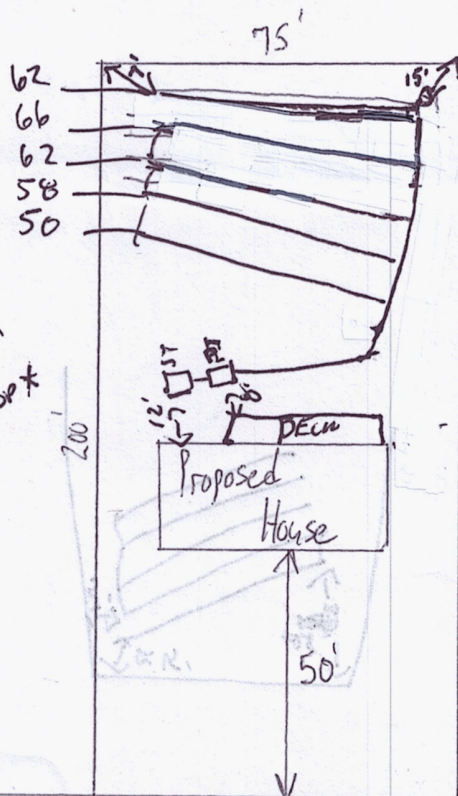

* Lines at top of
Slope

9/26
* NEED TO PAY PUMP FEE FOR OP *
7-18-25 CPE
6M3L-N-P-III
1/2 tanks, lines, pump, floats, alarm

Shawnee Dr.