




1 LEVEL 2 SUBFLOOR
1/4" = 1'-0"

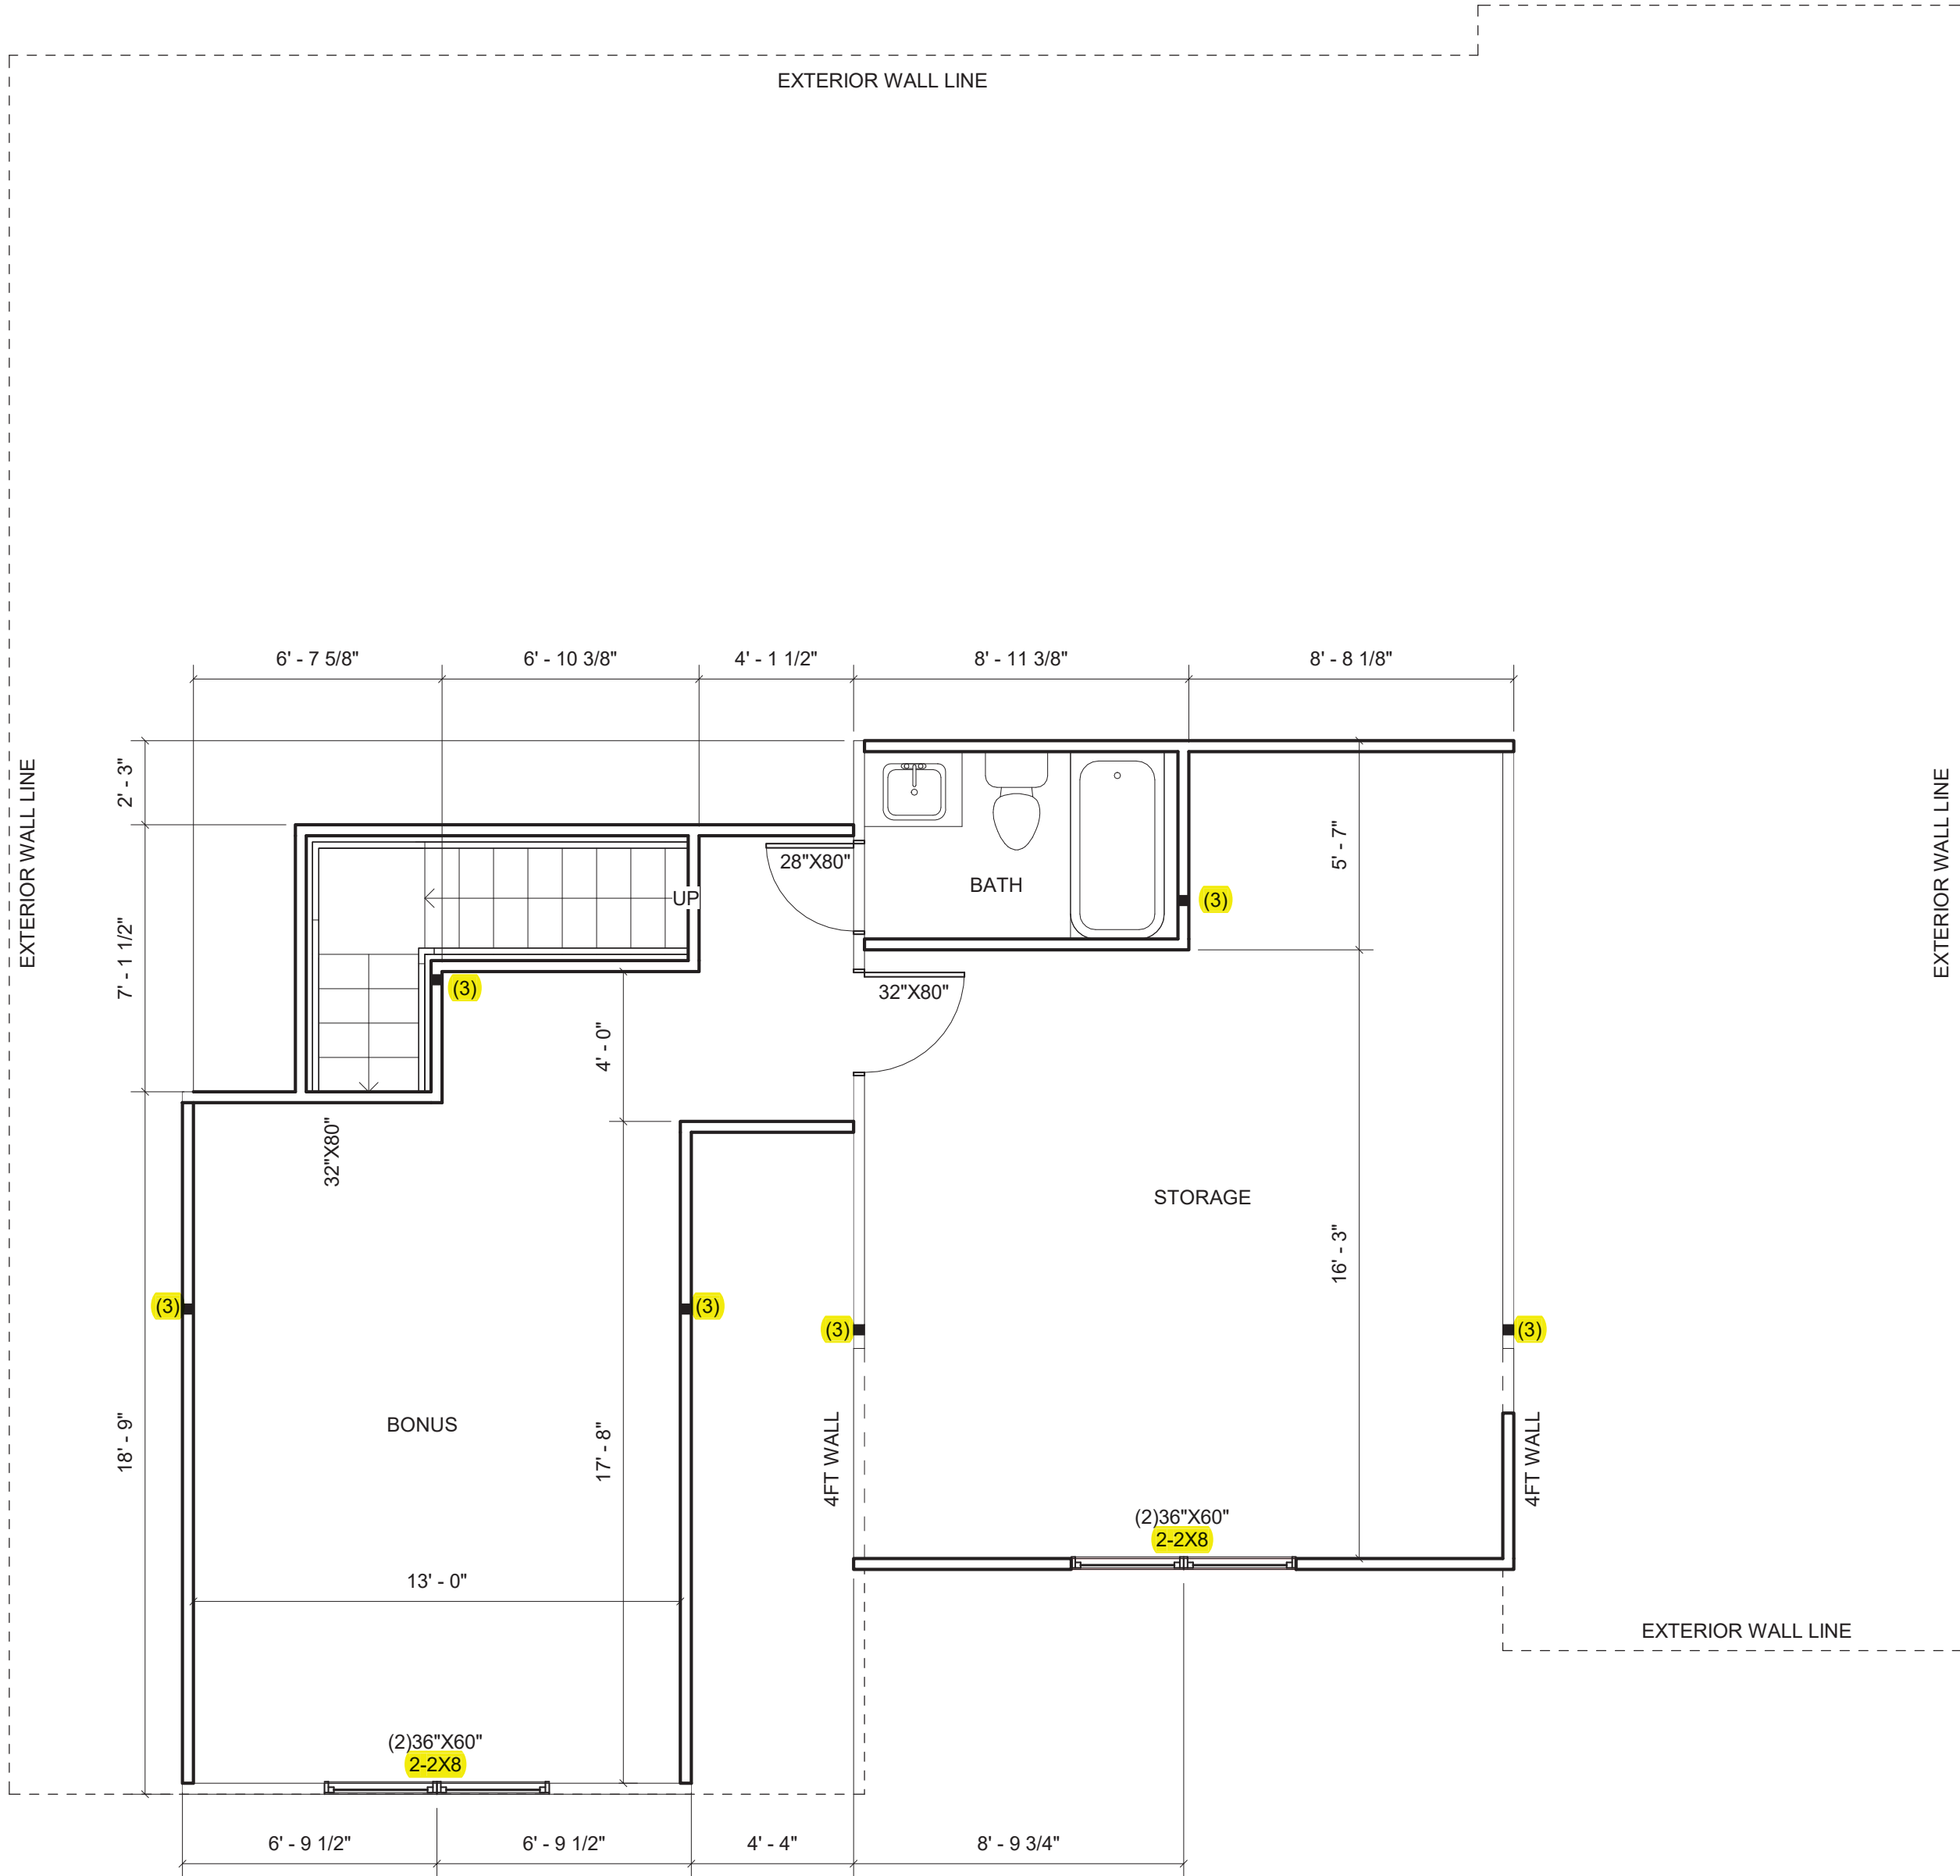

2 LEVEL 2 FLOOR PLAN
1/4" = 1'-0"

REVIEWED FOR CODE COMPLIANCE
FRANKLIN COUNTY NORTH CAROLINA
Plans must be on site at all times. It is the responsibility of the Permit holder or Contractor to comply with all local Ordinances, rules and regulations and the North Carolina Building Codes as if they were part of the specifications for the building. These shall be considered the official approved plans over anything shown, described or implied to the contrary. Reviewer is not responsible for mistakes or oversights during the plan review. -- McCannady
10/15/2024 9:34:09 AM

Set Issue Dates	
DATE	DESCRIPTION
9/11/24	FOR CONSTRUCTION

Revision Schedule		
#	DATE	DESCRIPTION

Proj. Date	9/11/24
Designed By	FP
Drawn By	FP
Checked By	FP
Sheet Name	LEVEL 2 SUBFLOOR & FLOOR PLANS
Sheet Number	