

Franklin County Health Department
Division of Environmental Health
107 Industrial Drive-Suite C
Louisburg, North Carolina 27549

PAGE 1 OF 2

Phone: 919-496-8100

SEPTIC PERMIT

Fax: 919-496-8136

Permit Number: 4559 Type: I PIN : 2727-50-8484 Date: 7/1/2008

Applicant: DIAMOND BUILDERS INC
10825 DEBNAM RD
ZEBULON, NC 27597-9342

Owner: B DEAN & MARY SUE BROWN
8200 WHITE OAK RD
GARNER, NC 27529

Telephone: (919) 404-0346

Telephone:

Subdivision: HARRISON VILLAGE

Lot Number: 82

Size: 1.350

Physical Address/ Location /Directions 35 HARRISON ST

Description: LifeTime _____ 5 Year X

TYPE FACIL SFD # EMPLOY 1 # BEDRMS 3 GPD 360 LTAR .39/d

TYPE WAT Priv TYPE SYS I TYPE REP Protect BSMT N BST FX N/A

SIZE TANK 900 SIZE CHB 1000 SIZE NTR 3x33' MTD 15"

COMMENTS 6-8" Approved ETL material must be placed over drain field area

Septic Contractors are responsible for notifying the health department for final inspections, between 8:00-9:00 AM on the day of completion, Monday - Friday. Any request for final inspections received afterwards will be scheduled the same day, if possible, or the next workday. Have permit number and owner/applicant's name ready when making the call.

Actions of representatives of state or local agencies engaged in the evaluation and determination of measures required to effect the compliance with the provisions of this permit shall in no way be taken as a guarantee that wastewater disposal systems permitted and approved will function in a satisfactory manner for any given period of time, or that such employees assume any liability for damages, consequential or direct which are caused, or may be caused, by a malfunction of this wastewater treatment and disposal system.

Proper precautions must be taken to assure the proper functioning of the system after it has been covered. Do not run any heavy equipment over the system, as soft earth will allow damage to the tank and lines. Pipe all roof drains away from the septic system site to prevent flooding of the lines from surface water. Terrace the ground to prevent excessive drainage from higher areas adjacent to the system. Do not construct driveways over any part of the septic system unless proper provisions were made when the septic system was constructed. Only grass, not trees or shrubbery, should be cultivated over the lines. All plumbing fixtures should be carefully inspected periodically and any problems repaired immediately. All septic tanks should be pumped off by a permitted pump operator on a regular schedule, not to exceed every five years.

The improvement permit and construction authorization is a site approval, for the future installation of a wastewater treatment and disposal system. Changes in ownership of the site do not affect the validity of this permit. However, any alteration of the site or soil conditions, changes in the location of the proposed facility, changes to the wastewater flow and/or characteristics, or submittal of false information with the application or misrepresentation of the property lines may subject this permit to suspension or revocation.

FOR THIS TO BE A VALID CONSTRUCTION AUTHORIZATION, A LAYOUT SHEET MUST BE ATTACHED

IMPROVEMENT PERMIT

DATE 9/29/08 EHS [Signature]

CONSTRUCTION AUTHORIZATION

DATE 9/29/08 EHS [Signature]

Franklin County Health Department

Name: DIAMOND BUILDER

Permit Number

4559

CONTRACTOR *[Signature]* TANK MANU _____ MANU DATE _____

WELL INSTALLED YES _____ NO _____ SYSTEM CODE _____

SEPTIC SYSTEM LAYOUT
(SKETCH SYSTEM LAYOUT HERE)

See ~~attached~~ attached layout & tap chart from CESC

✓ lin 8/17/09
CMS

need to check
tanks & pump

SEPTIC SYSTEM AS-BUILT

(IF DIFFERENT FROM INITIAL LAYOUT)

ON REVERSE

OPERATIONS PERMIT


DATE

9/30/09

EHS

Chris [Signature]
[Signature]

Harrison Village Lot # 82 3-Bedroom System Layout

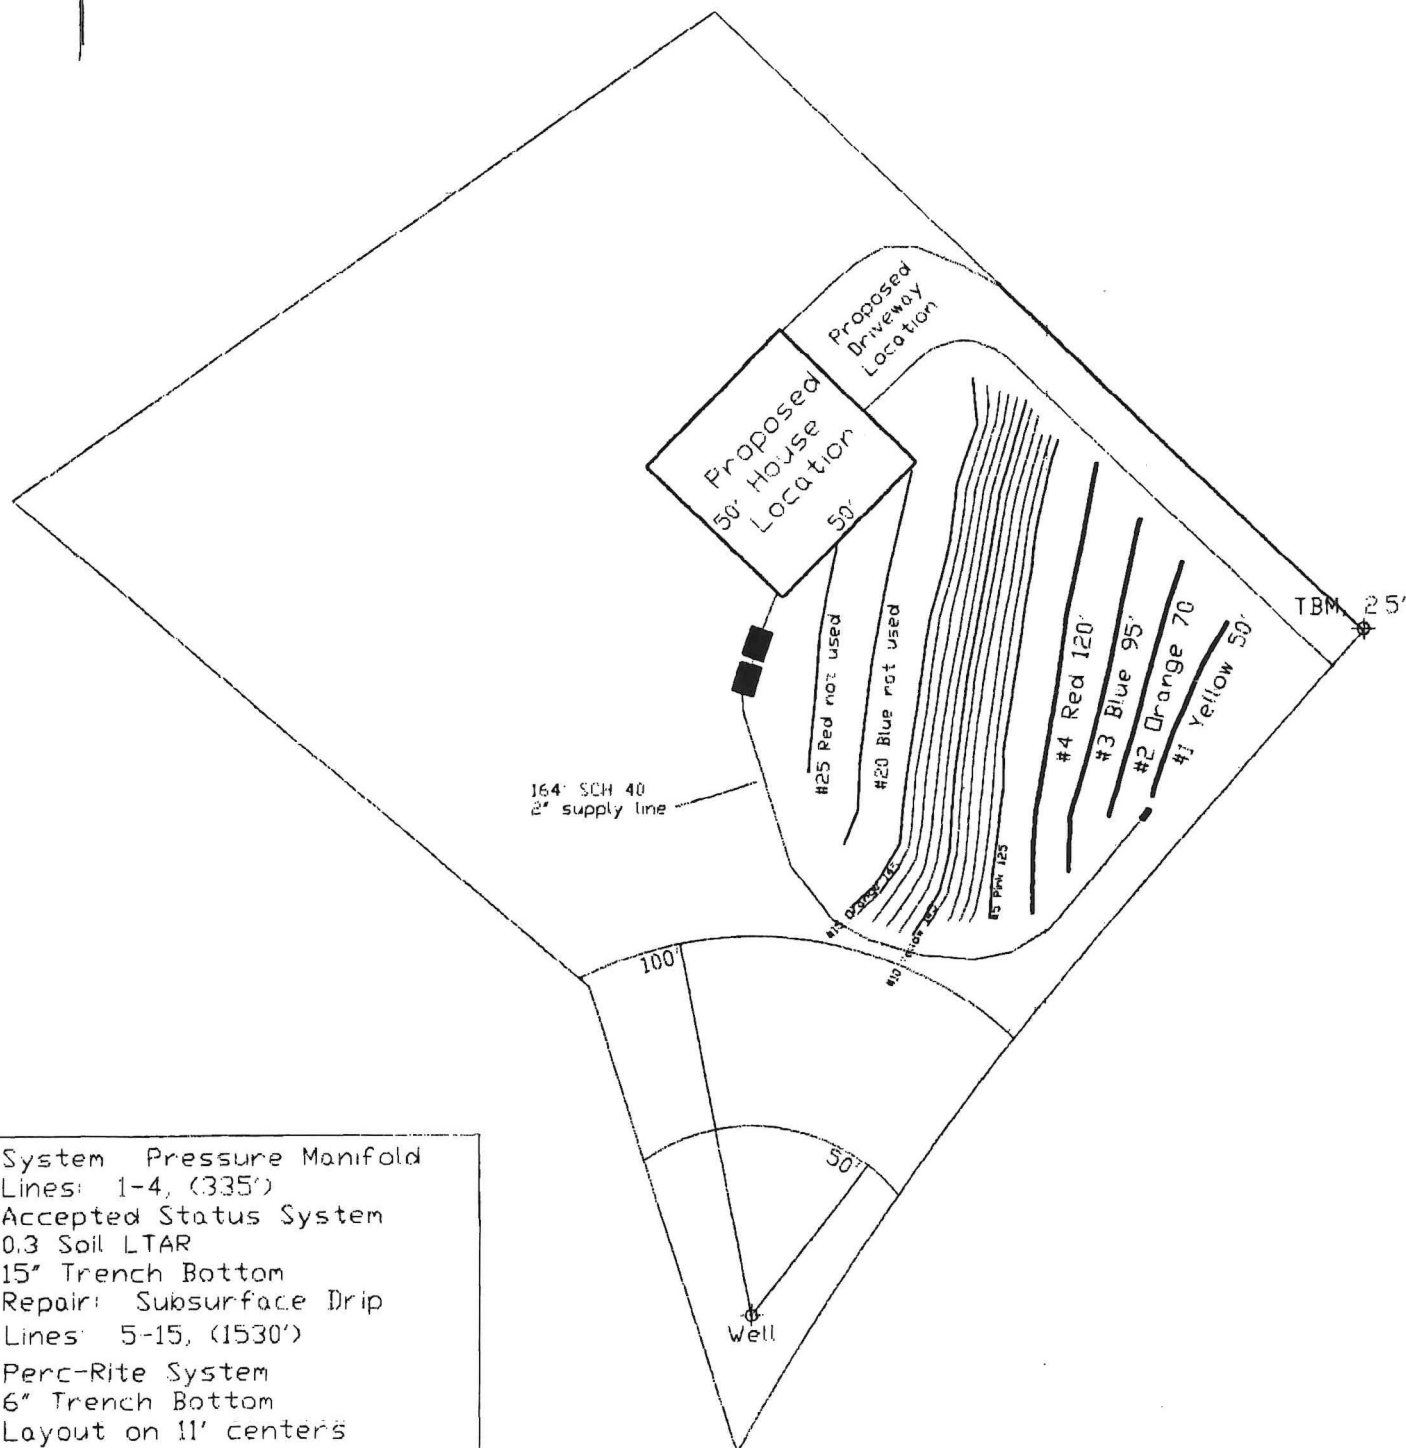

System Pressure Manifold
Lines: 1-4, (335')
Accepted Status System
0.3 Soil LTAR
15" Trench Bottom
Repair: Subsurface Drip
Lines: 5-15, (1530')

Perc-Rite System
6" Trench Bottom
Layout on 11' centers
Propose four lines between
flagged lines shown above
0.125 Soil LTAR
~1530' of line shown for
repair. Only 1440' needed
at 0.125 Soil LTAR (3-bedroom).

GRAPHIC SCALE
1" = 50'



Central Carolina
Soil Consulting
919-784-9449
Project # 656