

Fax 528-7533

**Franklin County Health Department
Environmental Health Section
107 Industrial Drive-Suite C
Louisburg, North Carolina 27549**

PAGE 1 OF 2

Phone: 919-496-8100

Fax: 919-496-8136

Permit Number: 3178 Type: J PIN: Date: 1/2/2007

Applicant: PEEDIN FAMILY HOMES INC Owner: PEEDIN FAMILY HOMES INC
6201 CLAMSHELL DR 6201 CLAMSHELL DR
WAKE FOREST, NC 27587 WAKE FOREST, NC 27587

Telephone: (919) 528-3153 Telephone: (919) 528-3153

Subdivision: PRINCETON MANOR Lot Number: 2 Size:

Physical Address/ Location /Directions WESTBOURNE DR

Description: LifeTime 5 Year X

TYPE FACIL Res # EMPLOY 1 # BEDRMS 4 GPD 480 LTAR 3⁹/₁₆
TYPE WAT Gm TYPE SYS I TYPE REP I BSMT N BST FX N/A
SIZE TANK 1000 SIZE CHB 3x400 SIZE NITR 30" MTD 30"

COMMENTS 400' Innwater/ Accepted

Septic Contractors are responsible for notifying the health department for final inspections, between 8:00-9:00 AM on the day of completion, Monday - Friday. Any request for final inspections received afterwards will be scheduled the same day, if possible, or the next workday. Have permit number and owner/applicant's name ready when making the call.

Actions of representatives of state or local agencies engaged in the evaluation and determination of measures required to effect the compliance with the provisions of this permit shall in no way be taken as a guarantee that wastewater disposal systems permitted and approved will function in a satisfactory manner for any given period of time, or that such employees assume any liability for damages, consequential or direct which are caused, or may be caused, by a malfunction of this wastewater treatment and disposal system.

Proper precautions must be taken to assure the proper functioning of the system after it has been covered. Do not run any heavy equipment over the system, as soft earth will allow damage to the tank and lines. Pipe all roof drains away from the septic system site to prevent flooding of the lines from surface water. Terrace the ground to prevent excessive drainage from higher areas adjacent to the system. Do not construct driveways over any part of the septic system unless proper provisions were made when the septic system was constructed. Only grass, not trees or shrubbery, should be cultivated over the lines. All plumbing fixtures should be carefully inspected periodically and any problems repaired immediately. All septic tanks should be pumped off by a permitted pump operator on a regular schedule, not to exceed every five years.

The improvement permit and construction authorization is a site approval, for the future installation of a wastewater treatment and disposal system. Changes in ownership of the site do not affect the validity of this permit. However, any alteration of the site or soil conditions, changes in the location of the proposed facility, changes to the wastewater flow and/or characteristics, or submittal of false information with the application or misrepresentation of the property lines may subject this permit to suspension or revocation.

**FOR THIS TO BE A VALID CONSTRUCTION AUTHORIZATION, A LAYOUT SHEET MUST BE
ATTACHED**

IMPROVEMENT PERMIT DATE 1/17/07 EHS [Signature]CONSTRUCTION AUTHORIZATION DATE 1/17/07 EHS [Signature]

P. 003/005

FAX No. 9194968136

APR/11/2011/MON 01:57 PM F C ENVMTL SERVICES

Franklin County Health Department


Name: PEEDIN FAMILY HO

Permit Number

3178

Allen; Jeff
WoodCONTRACTOR Quality Landscapes TANK MANU M: 115 / 1000 MANU DATE 3-26-10WELL INSTALLED YES _____ NO X SYSTEM CODE EZ12037-N-6SEPTIC SYSTEM LAYOUT
(SKETCH SYSTEM LAYOUT HERE)

Revised

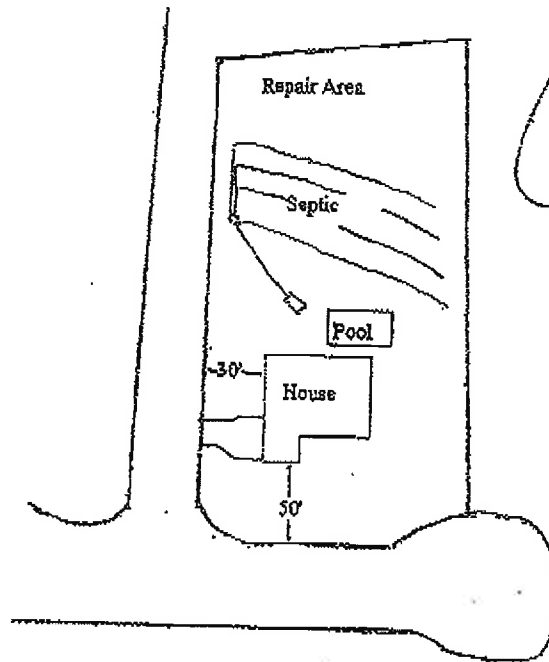Revisions signed
11/15/10 JRWSEPTIC SYSTEM AS-BUILT
(IF DIFFERENT FROM INITIAL LAYOUT)
ON REVERSE

OPERATIONS PERMIT

DATE 5/29/10 EHS

Franklin County Health Department

Name: PEEDIN FAMILY HO

Permit Number


3178

CONTRACTOR _____ TANK MANU _____ MANU DATE _____

WELL INSTALLED YES _____ NO _____ SYSTEM CODE _____

SEPTIC SYSTEM LAYOUT (SKETCH SYSTEM LAYOUT HERE)

Spoke w/ Monte Peedin 1/16/07 concerning pool - Mr Peedin said pool was not necessary

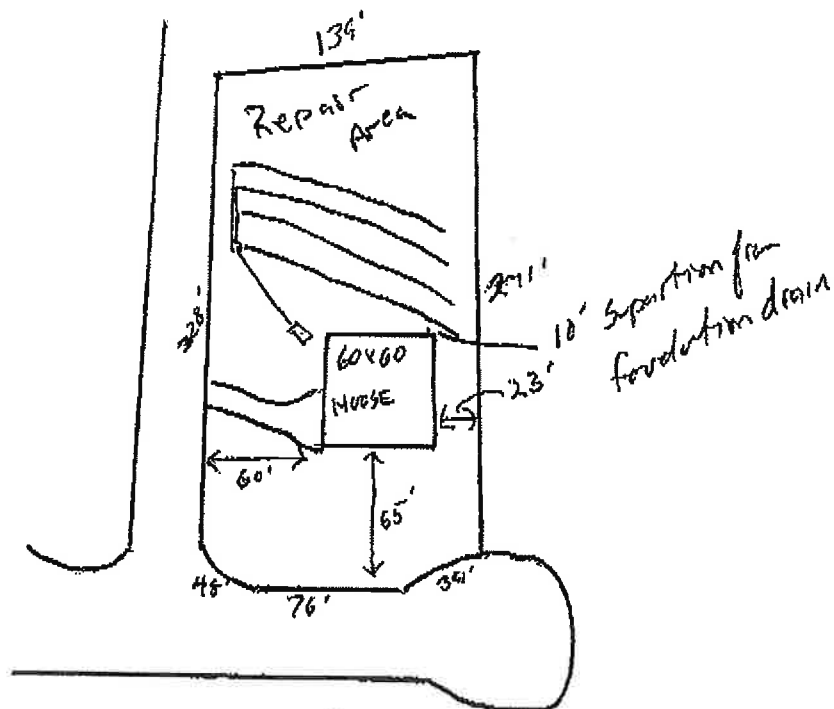

SEPTIC SYSTEM AS-BUILT
(IF DIFFERENT FROM INITIAL LAYOUT)
ON REVERSE

OPERATIONS PERMIT

DATE _____ EHS _____