



OPERATION PERMIT

Franklin County Health Department
107 Industrial Drive
Louisburg, NC 27549
Phone:

For Office Use Only

*CDP File Number 356117 - 1
County ID Number: _____
Evaluated For: NEW

Property Owner: NORMAN DILLARD

Address: 14112 BOLD RUN HILL RD

Road #:

City: WAKE FOREST

State/Zip: NC/ 27587

Phone #:

Township:

Subdivision: WOODLAND PARK

Phase : NEW

Lot: 51

Structure: SINGLE FAMILY

of Bedrooms: 3

of People: 6

Water Supply: N/A

Saprolite System?: ☐ Yes ☒ No

Pump Required?: ☐ Yes ☒ No

Design Flow:

System Classification/Description: TYPE III B. SYSTEM
W/SINGLE EFFLUENT PUMP

Installer: HBM

Specific System UNKNOWN

Installed: pump & gravity

STB: mid 51000 7/2/21

PT: 14-1151000 6/22/21

Comments:

Certification #:

Septic Tank Date: _____

Pump Tank Date: _____

This system has been installed in compliance with applicable NC General Statutes, Rules for Sewage Treatment and Disposal, and all conditions of the Improvement Permit and Construction Authorization.

PERMIT CONDITIONS:

I. Performance: System shall perform in accordance with Rule .1961.

II. Monitoring: As required by Rule .1961.

III. Maintenance: Ground absorption sewage treatment and disposal systems shall be checked, and the contents of the septic tank removed, periodically from all compartments, to ensure proper operation of the system. The contents shall be pumped whenever the solids level is found to be more than 1/3 of the liquid depth in any compartment.

Other:

Subsurface Operator Required: ☐ Yes ☒ No

If yes, see attached sheet for additional operation conditions, maintenance and reporting.

Operation:

Other:

Authorized State Agent: Wood, Jeffrey

Date of Issue: 12/10/2021

Owner/Applicant: _____



Septic 2100

File # 356117 PIN# _____

Property Address: 275 Sorrel Drive

Applicant or Owner Name: Norman Dillard

Environmental Health Septic/Well Permit Diagram

Building permits cannot be issued nor should construction begin without Construction Authorization issuance.

☒ Septic Improvement Permit ☒ Septic Construction Authorization (CA) ☐ CA Reissue** ☐ As Built
☒ Well Construction Authorization ☐ Additional Diagram/Specifications Attached

Diagram Date**: 5-7-21 EHS: Cyf


**Any previously dated CA diagram is revoked and/or invalid. Confirm this is the valid diagram for the site before beginning any construction.

Installation/grouting inspections may be scheduled the day before, or, the day of installation until 9am by contacting the Environmental Health office at 919 496 8100. A revisit fee may apply if installation is not ready for inspection at the time requested. Septic Operations Permits will be issued after installation is approved, all permits conditions are met, and any outstanding fees are paid. Well Certificate of Completion will be issued after well head approval, all permit conditions are met, and any outstanding fees are paid.

Septic Tank 1000 Pump Tank 1000 Drainfield 3'x300' Type System Pto Acc Max Trench Depth 24"
 Septic Contractor Britt Murphy Septic/Pump tank dates 5/11/21 to 7/2/21 Pump fee? NO YES 50.00 (H)
 Well Contractor _____ Well Grout date: 12/10/21

✓ Id lines 8-26-21
 ✓ Id tanks 9-13-21

✓
 NEEDS PUMP FINAL + PUMP FEE TO BE PAID FOR OPTO BE SIGNED

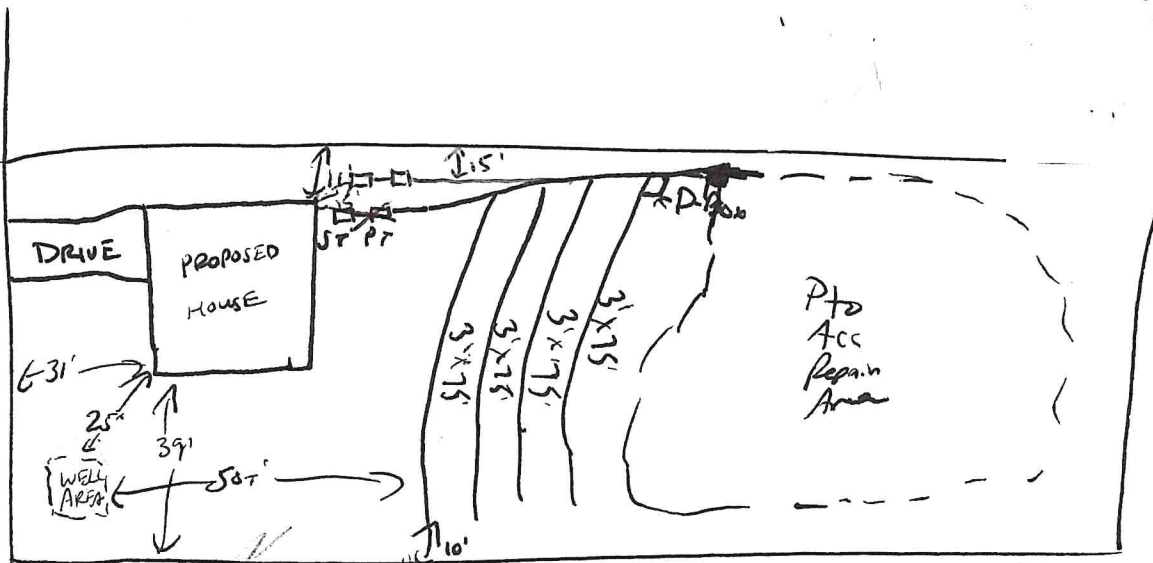

HB Mc
 Britt
 pay fee to him
 SJE Box
 Service 693282X-2116
 1/2 hp
 Zoller 9152
 pump alarm
 11-30-21
 2-10