



OPERATION PERMIT

Franklin County Health Department
107 Industrial Drive
Louisburg, NC 27549
Phone:

For Office Use Only

*CDP File Number 458275 - 1

County ID Number:

Evaluated For: NEW

Property Owner: John Szalecki
Owner Address: 1016 Mockingbird Dr

City: Raleigh
State/Zip: NC/ 27615

Phone #:
Address: 990 Duke Valentine Wynne Road
Louisburg, NC 27549

Road #:
Township:
Subdivision:
Phase : NEW Lot: 4

Structure: SINGLE FAMILY
of Bedrooms: 3
of People: 6
Water Supply: NEW WELL

Saprolite System?: ☐ Yes ☒ No

Pump Required?: ☐ Yes ☒ No

Design Flow: 360
System Classification/Description: TYPE III G. OTHER
NON-CONV. TRENCH SYSTEMS

Installer: DB & SONS

Certification #: 1036

Specific System CHAMBER
Installed:

STB: 502

PT:

Septic Tank Date: _____

Pump Tank Date: _____

Comments: 76 PANELS OF CHAMBER INSTALLED PLUS END CAPS (312' TOTAL). SERIAL DISTRIBUTION

This system has been installed in compliance with applicable NC General Statutes, Rules for Sewage Treatment and Disposal, and all conditions of the Improvement Permit and Construction Authorization.

PERMIT CONDITIONS:

I. Performance: System shall perform in accordance with Rule .1301.

II. Monitoring: As required by Rule .1301.

III. Maintenance: Ground absorption sewage treatment and disposal systems shall be checked, and the contents of the septic tank removed, periodically from all compartments, to ensure proper operation of the system. The contents shall be pumped whenever the solids level is found to be more than 1/3 of the liquid depth in any compartment.

Other:

Subsurface Operator Required: ☐ Yes ☒ No

If yes, see attached sheet for additional operation conditions, maintenance and reporting.

Operation:

Other: 76 PANELS OF CHAMBER INSTALLED PLUS END CAPS (312' TOTAL). SERIAL DISTRIBUTION

Authorized State Agent: Ennis, Crystal

Date of Issue: 12/01/2025

Owner/Applicant: _____



File# 458275 PIN# 2827-36-8940

Property Address: 990 Duke Valentine Wynne Rd

Applicant Or Owner Name: John Szalecki

Environmental Health Septic/Well Permit Diagram

Building permits cannot be issued nor should construction begin without Construction Authorization issuance.

☐ Septic Improvement Permit ☐ Septic Construction Authorization (CA) ☐ CA Reissue** ☒ As Built
☐ Well Construction Authorization ☐ Additional Diagram/Specifications Attached

Diagram Date**: 12-1-25 EHS: Cynthia Ems

****Any previously dated CA diagram is revoked and/or invalid. Confirm this is the valid diagram for the site before beginning any construction.**


Installation inspections may be scheduled the day before or the day of installation by 9am. Contact the Environmental Health office at 919 496-8100. A revisit fee may apply if installation is not ready for inspection at the time requested. SEPTIC OPERATIONS PERMITS will be issued after installation is approved, all permit conditions are met, and any outstanding fees are paid. WELL CERTIFICATE OF COMPLETION will be issued after well head approval, all permit conditions are met, and any outstanding fees are paid.

Septic Tank 1000 Pump Tank 1 Drain field 3'x312' Type System Acc Max trench depth 24"

Septic Contractor DB & Sons Septic/Pump tank dates STB 502
DB 1000 PUMP FEE PAID

Well Contractor Well Head Date: PUMP FINAL: (N/A (CIRCLE))

*** Drawing not to scale ***

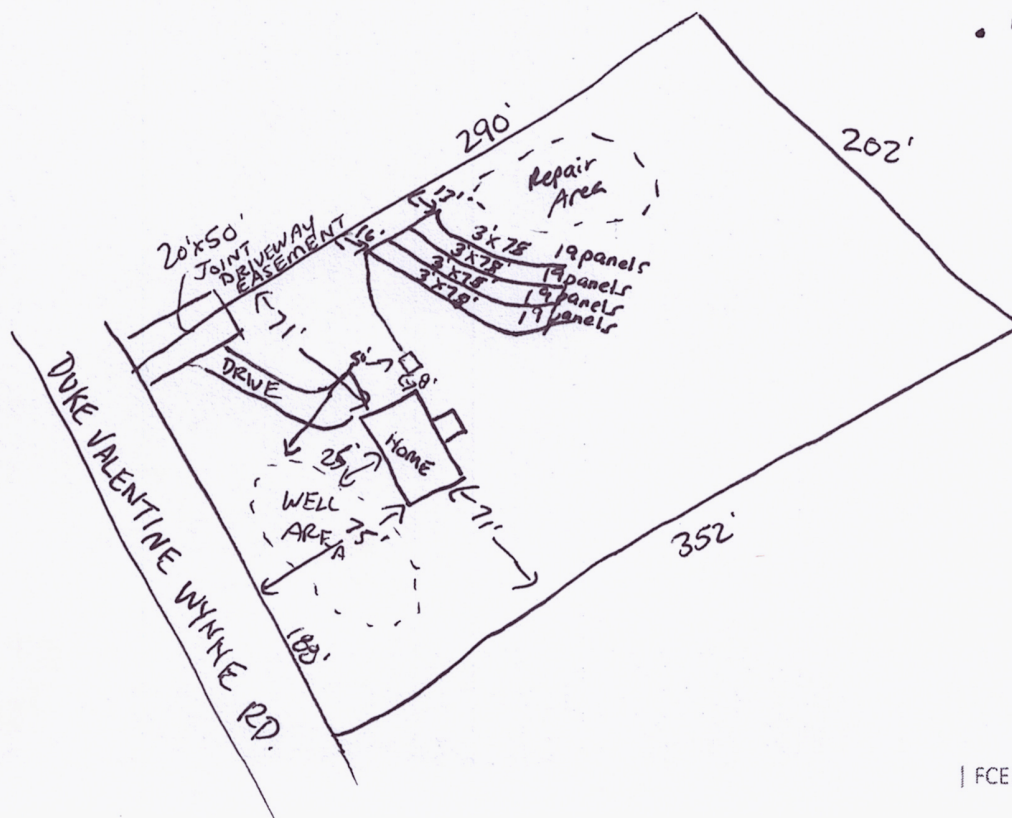

- 76 panels of chamber plus end caps installed
- Serial distribution
- Old tank & lines
- 12-1-25 CEF