

FRANKLIN COUNTY HEALTH DEPARTMENT

PERMIT NUMBER: 147480 CONST IMPROVE PERMIT 20000000	DATE: 7/23/12	SIZE: 1.030
APPLICANT: LESHER & ASSOCIATES 710 N MAIN ST WAKE FOREST NC 27587	OWNER: LESHER & ASSOCIATES 710 N MAIN ST WAKE FOREST NC 27587	
TELEPHONE: 556-4167	DESCRIPTION: 5 YEAR ☒	LIFETIME: ☐
COMMENT: SFD		
LOCATION / DIRECTIONS: WOODCROFT #24 Off Sid Mitchell Rd.		
FEE: 175.00	SIGNATURE OR OWNER OR AUTHORIZED AGENT:	

THE ABOVE SIGNATURE INDICATES THAT I HAVE READ, UNDERSTAND, AND AGREE WITH ALL PROVISIONS AND INFORMATION AS OUTLINED ON THE BACK SIDE OF THIS FORM


TOPO <u>S</u>	TEXTURE <u>PS</u>	STRUCTURE <u>PS</u>	DEPTH <u>PS</u>
R. HOR <u>1</u>	SOIL. WET <u>S</u>	AVAIL. SP <u>S</u>	OTHER <u>1</u>
MINRL <u>S</u>	OVERALL <u>PS</u>	LTAR <u>.35</u>	
#BEDRMS <u>3</u>	GPD <u>360</u>	DISPOSAL <u>1</u>	TYPE. SYS <u>Pump to Cont.</u>
SZ. TANK <u>900</u>	SZ. CHAMB <u>1000</u>	NITRIFI <u>3'x350'</u>	TYPE. WAT <u>Well</u>
SITE. LOC <u>1</u>	MAX TRENCH DEP <u>24"</u>	TYP. FAC <u>SFD</u>	

REMARKS: Clear the lot for lot layout and construction authorization.
Call the health dept. when this is done.

CONTRACTOR: David Brantley + Sons
TANK MANUF: D-B 1000
MANUF DATE: 1-10-01

Stay 100' from well, 10' from property lines,
5' from foundation.
Run drain lines with contour.

Pump D-B 1000
2-21-01
Alarm Sounds & Pump O.K.

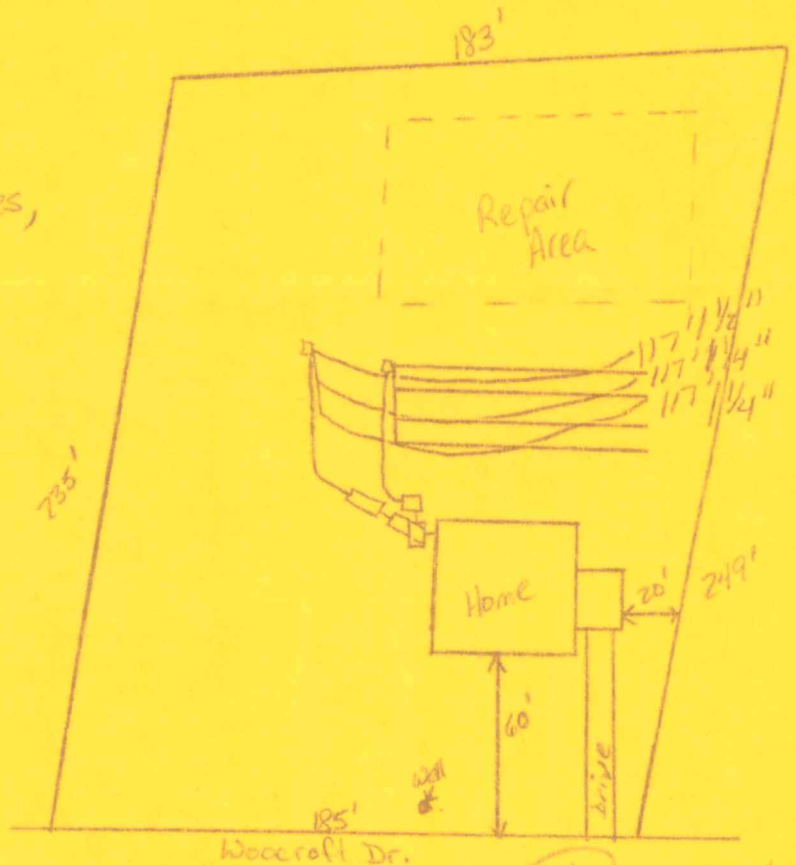

IMPROVEMENT PERMIT DATE: 8/9/00
CONSTRUCTION AUTHORIZATION DATE: 10/10/00
OPERATION PERMIT DATE: 5/9/01

ENV HEALTH SPEC: Dustin Funder
ENV HEALTH SPEC: Dustin Funder
ENV HEALTH SPEC: Dustin Funder