



OPERATION PERMIT

Franklin County Health Department
107 Industrial Drive
Louisburg, NC 27549
Phone:

For Office Use Only

*CDP File Number 393692 - 1
County ID Number: _____
Evaluated For: NEW

Property Owner:

Owner Address:

City:

State/Zip: /

Phone #:

Address: 50 LILAC DR
FRANKLINTON, NC 27525

Road #:

Township:

Subdivision: WOODLAND PARK

Phase: NEW Lot: 111

Structure: SINGLE FAMILY

of Bedrooms: 3

of People: 6

Water Supply: NEW WELL

Saprolite System?: ☐ Yes ☒ No

Pump Required?: ☐ Yes ☒ No

Design Flow: 360

System Classification/Description: TYPE II A. CONV SYSTEM
(SINGLE-FAMILY OR 480 GPD OR LESS)

Installer: Blackley

Certification #:

Specific System CHAMBER

Installed:

Septic Tank Date: 08/16/2023

STB: 858

Pump Tank Date: _____

PT:

Comments:

This system has been installed in compliance with applicable NC General Statutes, Rules for Sewage Treatment and Disposal, and all conditions of the Improvement Permit and Construction Authorization.

PERMIT CONDITIONS:

I. Performance: System shall perform in accordance with Rule .1961.

II. Monitoring: As required by Rule .1961.

III. Maintenance: Ground absorption sewage treatment and disposal systems shall be checked, and the contents of the septic tank removed, periodically from all compartments, to ensure proper operation of the system. The contents shall be pumped whenever the solids level is found to be more than 1/3 of the liquid depth in any compartment.

Other:

Subsurface Operator Required: ☐ Yes ☒ No

If yes, see attached sheet for additional operation conditions, maintenance and reporting.

Operation:

Other:

Authorized State Agent: Jones, Lori

Date of Issue: 11/27/2023

Owner/Applicant: _____



Lot 111

1:00
287

File # 393692 PIN#

Property Address: 50 Lilac Dr. Frk

Applicant or Owner Name: Matt Baldwin

Environmental Health Septic/Well Permit Diagram

Building permits cannot be issued nor should construction begin without Construction Authorization Issuance.

☒ Septic Improvement Permit ☒ Septic Construction Authorization (CA) ☐ CA Reissue** ☐ As Built
☒ Well Construction Authorization ☐ Additional Diagram/Specifications Attached

Diagram Date**: 5-24-2023 EHS: Paul Jones

**Any previously dated CA diagram is revoked and/or invalid. Confirm this is the valid diagram for the site before beginning any construction.

Installation/grouting inspections may be scheduled the day before, or, the day of installation until 9am by contacting the Environmental Health office at 919 496 8100. A revisit fee may apply if installation is not ready for inspection at the time requested. Septic Operations Permits will be issued after installation is approved, all permits conditions are met, and any outstanding fees are paid. Well Certificate of Completion will be issued after well head approval, all permit conditions are met, and any outstanding fees are paid.

Septic Tank 1000 Pump Tank Possible 1000 Drainfield 3'x300' Type System Accepted Max Trench Depth 24"
Septic Contractor Blackley Septic/Pump tank dates 8-16-23 Pump fee? ☐ NO ☐ YES pd
Well Contractor Well Grout date: or self grout 858 Mills Well Head Date:


Bedrooms: 3

If Repair: na

Acreage: .8

Parcel ID: 049229

*Drawing not to scale (if large acreage, may be portion)
(If not as built, indicate changes on front or back of sheet.)

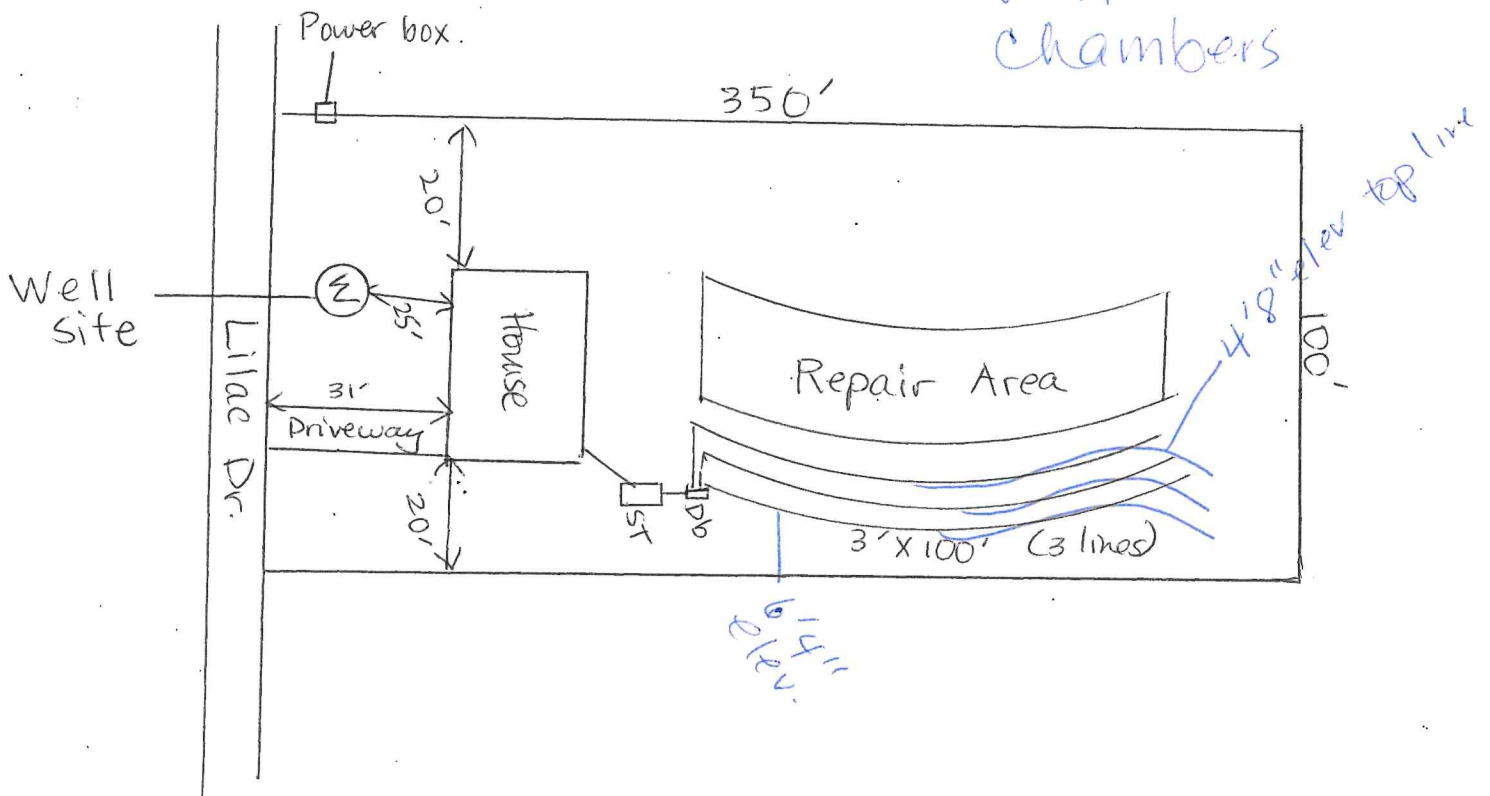

Lot 111

TYPE OF WASTEWATER: ☒ Sewage ☐ Industrial Process ☐ Mixed

39
- 12

27
- 2

25

(24" Instaen

3): Low Power

over