


NOTE: Make sketch of installation showing location of house, septic tanks, privies, water supplies on adjacent property, etc. Write in measurements in order that installations may be located at later date.

* Not to Scale

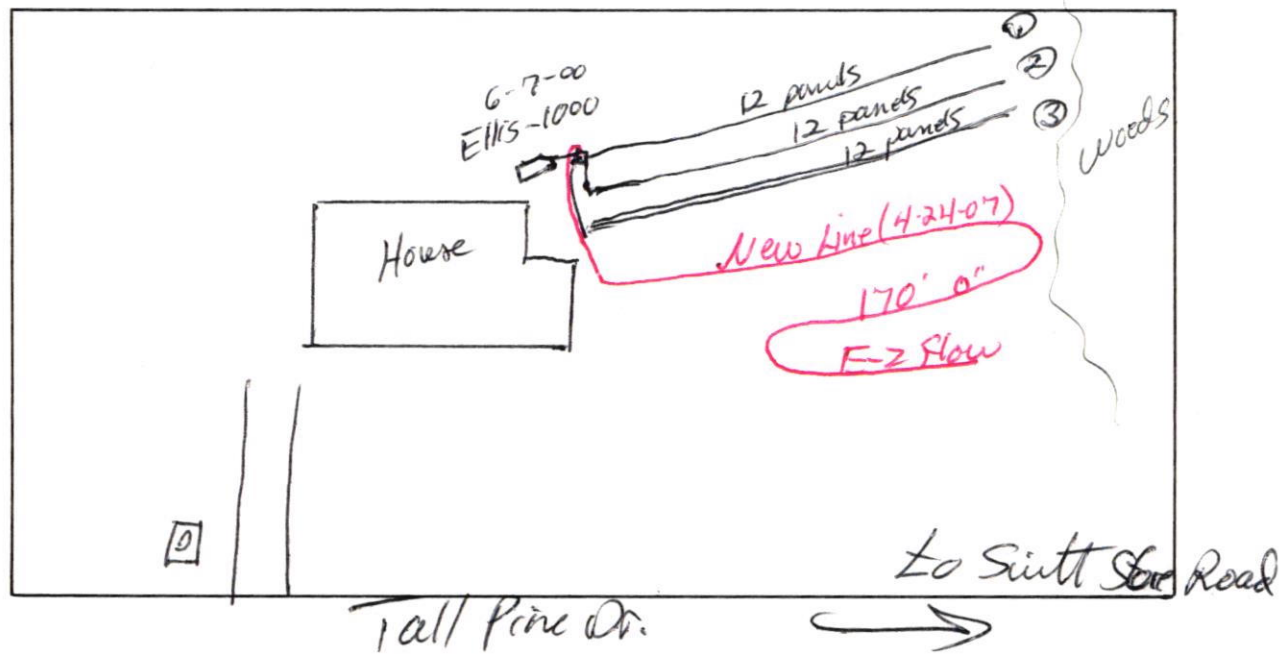

GRANVILLE-VANCE HEALTH DEPARTMENT—Sewage Disposal Record

Owner or Contractor Marathon Management Date 5-12-00 S.R. No. 1705
Location/Address Tall Pine
Subdivision/Mobile Home Park Name Brassfield Woods Lot Size 1.621
Permit No. # _____ Lot No. 34

New System ☒ Repair _____
House ☒ Mobile Home _____ Business _____
No. Bedrooms 3 No. People _____ No. Toilets _____
Water Supply: Private ☒ Approved _____
Semi-Public _____ Unapproved _____
Public _____ None _____

Nitrification System:

Tank Size 1000 gal.
Distribution Box yes No. Lines 3
Nitrification Field 900 Sq. Ft.
Lines: 1 2 3 4 5 6
Width 3' 3' 3' _____
Length 12 12 12 (panels) _____
Grade 0" 0" 0" _____
Stone Depth Chamber System

Layout to be followed by installer:

* Sketch of layout
on back

* See Repair Permit 06285
Ricky Flowers

Repair 4-24-07
J.C. Madden
170' EZ Flow
David Cumber

Improvements Permit By M.E. Yount Installer Norman Clifford
Certificate of Completion By David Cumber Date of Inspection 9-29-00

* Construction must comply with all other applicable state and local regulations, but the permit is not a guarantee that the system will not malfunction and the Granville-Vance Health District will not be held responsible for a malfunctioning system.

* see Marathon Management (Hard Card)
Owner 2.00 written 9-29-00

PERMIT NUMBER 06285

GRANVILLE-VANCE DISTRICT HEALTH DEPARTMENT
IMPROVEMENT AND OPERATION PERMITS

COUNTY:	TAX NO. 183600 21316	TYPE OF ESTABLISHMENTS			*THIS PERMIT SHALL BE ACCOMPANIED BY A LAYOUT SHOWN ON A PLAT, INCLUDING SYSTEM REQUIREMENTS.
Granville	SR. NO. 1765	RESIDENCE ☒ BUSINESS ☐ OTHER ☐	NUMBER OF BEDROOMS: 4?	NUMBER OF OCCUPANTS: 4-6	
OWNER: Ricky Flowers		WATER SUPPLY	WELL ☒ PUBLIC ☐	OTHER ☐	
APPLICANT'S ADDRESS: former owner: Marathon Management		TYPE OF WASTEWATER SYSTEM	INITIAL INSTALLATION	REPAIR ☒	
PROPERTY ADDRESS/LOCATION: 4106 Tall Pine Dr.		DESIGN FLOW:			*THIS IMPROVEMENT PERMIT IS SUBJECT TO REVOCATION IF THE INTENDED USES CHANGE FROM THOSE SHOWN ON THE IMPROVEMENT PERMIT. CHANGES SHALL REQUIRE HEALTH DEPARTMENT APPROVAL.
SUBDIVISION: Brassfield Woods		LTAR:			
LOT NUMBER: 34		ABSORPTION AREA:			
		TRENCH WIDTH:		3'	
REFERENCE SKETCH (SEE PLAT FOR DETAILS)		TRENCH DEPTH:		18'-24"	PERMIT VALID FOR: 5 YEARS YES ☒ NO ☐
Lines dug level and on contour, contour to be established by installer. New distribution box may be needed - back-fill end of best existing line - Do not install in wet conditions		TRENCH SPACING:		9' O.C.	
		TOTAL TRENCH LENGTH:		170'	
		NUMBER OF TRENCHES:		2	
		GRAVEL DEPTH:	(non-gravel)	Accepted Status	
		TANK SIZE:		Existing	NO EXPIRATION YES ☐ NO ☒
		PUMP TANK SIZE:			
		DISTRIBUTION DEVICE:		Distribution 130X	

IMPROVEMENT PERMIT

DATE: 4-17-07

FOR: Ricky Flowers
ISSUED BY: David Cumber

CONSTRUCTION AUTHORIZATION FOR IMPROVEMENT PERMIT# 06285

Unless otherwise indicated, the same conditions above apply regarding system type, layout, location and installation requirements.
(The wastewater system cannot be installed until authorization is signed)

Comments: Cal 693-2658 with question

Date: 4-17-07 Environmental Health Specialist: David Cumber

Construction Authorization Addendum ☐ Yes ☒ No

OPERATION PERMIT

DATE: 4-24-07

SYSTEM INSTALLED BY: J. Madden
ISSUED BY: David Cumber

PERFORMANCE, MONITORING, MAINTENANCE AND OPERATION
AS REQUIRED BY RULE .1961