

FRANKLIN COUNTY HEALTH DEPARTMENT

PERMIT NUMBER: 17645C	DATE: 030828	1862-03-1084	SIZE: 0.960
APPLICANT: ED CONSTRUCTION 107 SALLINGER ST KNIGHTDALE NC 27545		OWNER: AH CLIFFORD & SAPPAN PO BOX 510 ROLESVILLE NC 27571	
TELEPHONE: 217-5601 910-210-3044	COMMENT: Joe Davis 669-0346 528-2452		
LOCATION / DIRECTIONS: GREEN MEADOWS #8		DESCRIPTION: 5 YEAR ☒	LIFETIME: ☐
FEE: 225.00	SIGNATURE OR OWNER OR AUTHORIZED AGENT:		

THE ABOVE SIGNATURE INDICATES THAT I HAVE READ, UNDERSTAND, AND AGREE WITH ALL PROVISIONS AND INFORMATION AS OUTLINED ON THE
BACK SIDE OF THIS FORM

BACK SIDE OF THIS FORM							
TOPO	PS	TEXTURE	PS	STRUCTURE	PS	DEPTH	PS
R. HOR	PS	SOIL. WET	PS	AVAIL. SP	PS	OTHER	
MINRL	PS	OVERALL	PS	LTAR	0.25		
#BEDRMS	3	GPD	360	DISPOSAL		TYPE. SYS	Conv.
SZ. TANK	1000	SZ. CHAMB		NITRIFI	3'x480'	TYPE. WAT	Public
SITE. LOC		MAX TRENCH DEP	24"	TYP. FAC	SFD		
REMARKS:	*CA Signed ONCE Lot IS Cleared & HOME LOCATION MARKED!						

CONTRACTOR: WAYNE DAVIS Constr.


TANK MANUF: E113 1000

MANUF DATE: 4/29/08

* Install SYSTEM
along Contour as
Flagged /

* Install SYSTEM IN DRY Conditions

* Do Not PARK or Drive over SYSTEM AREA!

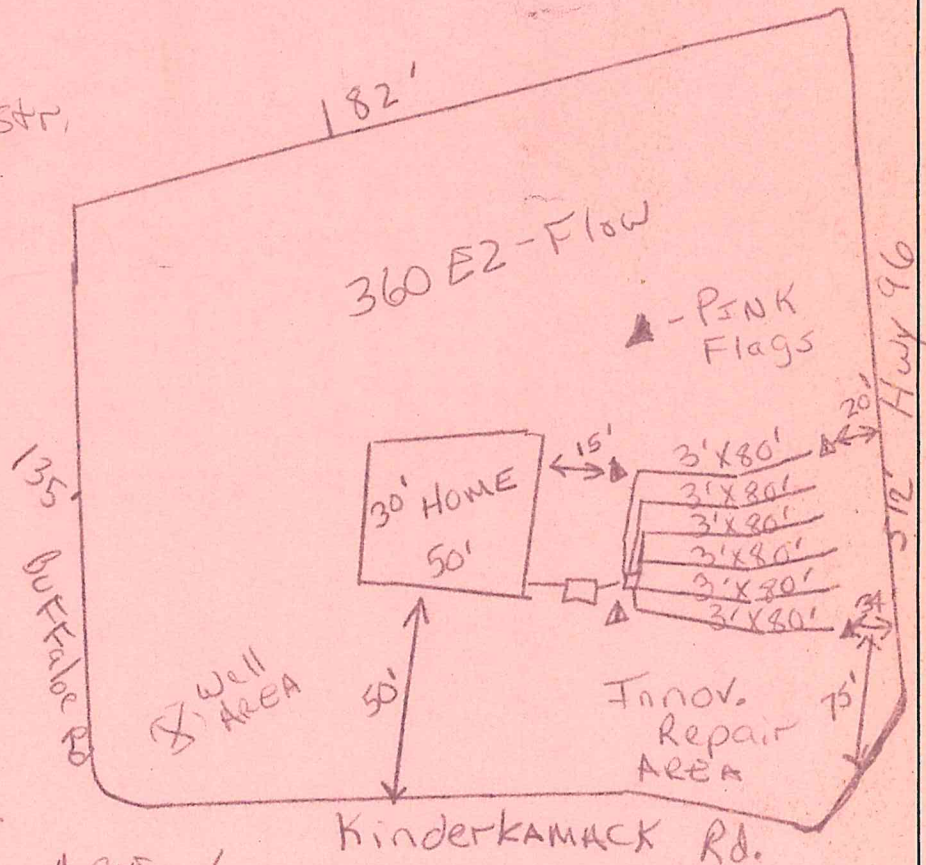

IMPROVEMENT PERMIT DATE: 8/29/03

ENV HEALTH SPEC: Andy Smith, KS

CONSTRUCTION AUTHORIZATION DATE: 12/2/03

ENV HEALTH SPEC: *Andrew Smith*

OPERATION PERMIT DATE: 6/18/84

ENV HEALTH SPEC: Indy Sm. Thr. B