

JUN-15-2009 MON 01:35 PM

FRANKLIN CO ENV HEALTH

FAX No. 919 496 8136

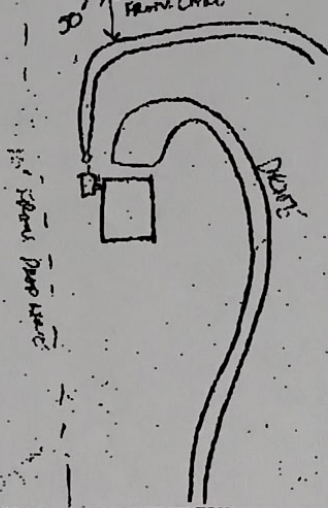
P. 001/001

PM
10-15-84

No 2154

FRANKLIN COUNTY HEALTH DEPARTMENT
IMPROVEMENTS PERMIT AND CERTIFICATE OF COMPLETIONOwner Otis Lowrey Date 7/30/84Location Lake Payne - Lot # 1151 & 1152☒ Septic Tank ☐ Repair ☒ Home ☒ New
☐ Privy ☐ Electric Svc. ☐ Mobile Home ☐ Business☒ Garbage Disposal ☐ No. Bedrooms 5
☒ Dishwasher ☐ No. Bathrooms 1 1/2
☐ Washing Machine ☐ No. Persons weyringSize of Tank 900 Area of Nit. Field 900
Total Length of Lines 350 No. of Lines 23
Trench Width 30 1/2' Depth of Stone 12"Water Supply: ☐ Private ☒ Community☐ FmHA ☐ FHA ☐ VA

Comments

Imp. Permit Del PeoplesCert. of Comp. David S. ThompsonContractor Leighton Date 10-16-84Lot Size: _____ Township: Cypress CreekLayout: LYKEPower Power
Fee 730.00 pd. in full 8/20/84

252 978

5608

(252) 477

3028