

FRANKLIN COUNTY HEALTH DEPARTMENT

919 282 1577
919 732-1643


PERMIT NUMBER: <u>9402C</u>	DATE: <u>17.97</u>	13175	SIZE: 1A
APPLICANT: WIGGINS GUY 1097 FLAT ROCK CHURCH RD LOUISBURG NC 27549		OWNER: WADE MOORE EQUIP CO	
TELEPHONE: <u>556-1763</u>			
COMMENT: <u>SFD</u>	DESCRIPTION: 5 YEAR ☒	LIFETIME: ☐	
LOCATION / DIRECTIONS: <u>ROYAL ACRES #14</u>			
FEE: <u>100.00</u> <u>4904</u>		SIGNATURE OR OWNER OR AUTHORIZED AGENT:	

THE ABOVE SIGNATURE INDICATES THAT I HAVE READ, UNDERSTAND, AND AGREE WITH ALL PROVISIONS AND INFORMATION AS OUTLINED ON THE BACK SIDE OF THIS FORM

TOPO <u>PS</u>	TEXTURE <u>PS</u>	STRUCTURE <u>P</u>	DEPTH <u>PS</u>
R. HOR <u>5</u>	SOIL. WET <u>PS</u>	AVAIL. SP <u>5</u>	OTHER <u>—</u>
MINRL <u>5</u>	OVERALL <u>PS</u>	LTAR <u>.35</u>	
#BEDRMS <u>3</u>	GPD <u>360</u>	DISPOSAL <u>N</u>	TYPE. SYS <u>CONV</u>
SZ. TANK <u>700</u>	SZ. CHAMB <u>—</u>	NITRIFI <u>3x350'</u>	TYPE. WAT <u>PRIV</u>
SITE. LOC <u>—</u>	MAX TRENCH DEP <u>24"</u>	TYP. FAC <u>SFD</u>	

REMARKS:

4-30-97
MELLS 900
STB 870

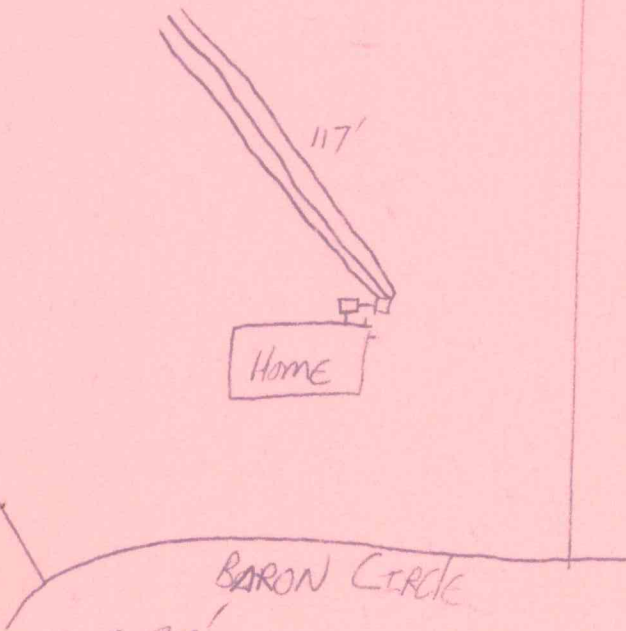

IMPROVEMENT PERMIT DATE: 5-6-97

ENV HEALTH SPEC: BLH

CONSTRUCTION AUTHORIZATION DATE: 5-6-97

ENV HEALTH SPEC: BLH

OPERATION PERMIT DATE: 6-17-97

ENV HEALTH SPEC: BLH