


GRANVILLE-VANCE HEALTH DEPARTMENT—Sewage Disposal Record

Owner or Contractor JRS - Small Date 7-29-02 S.R. No. 1514
Location/Address Chesney Rd Cleveland Dr.
Subdivision/Mobile Home Park Name 7 Sprays
Permit No. # _____ Lot Size _____
Lot No. 21

New System ☒ Repair _____
House _____ Mobile Home Yes Business _____
No. Bedrooms 3 No. People 3 No. Toilets _____
Water Supply: Private ☒ Approved _____
Semi-Public _____ Unapproved _____
Public _____ None _____

Nitrification System:
Tank Size 1000 gal.
Distribution Box Yes No. Lines 3
Nitrification Field 350 Sq. Ft.
Lines: 1 2 3 4 5 6
Width 3 3 3 _____
Length 116 112 112 _____
Grade _____
Stone Depth 12 12 12 _____

Layout to be followed by installer:

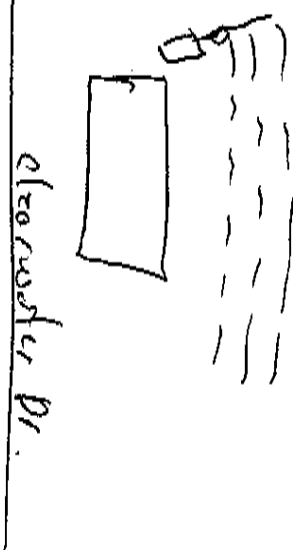

Improvements Permit By David Cambes Installer John Kiser
Certificate of Completion By Will Dwyer Date of Inspection 5-2-02

* Construction must comply with all other applicable state and local regulations, but the permit is not a guarantee that the system will not malfunction and the Granville-Vance Health District will not be held responsible for a malfunctioning system.