

GRANVILLE-VANCE HEALTH DEPARTMENT—Sewage Disposal Record

Owner or Contractor Davis William H. Date 12-8-88 S.R. No. _____
 Location/Address Ross Mill Rd 1720
 Subdivision/Mobile Home Park Name 0210 02004 Lot Size ac
 Lot No. _____


New System ☒ Repair _____
 House ☒ Mobile Home _____ Business _____
 No. Bedrooms 3 No. People 2 No. Toilets 2
 Water Supply: Private ☒ Approved _____
 Semi-Public _____ Unapproved _____
 Public _____ None _____

Nitrification System:
 Tank Size 2000 gal. _____
 Distribution Box yes No. Lines 4
 Nitrification Field 960 Sq. Ft. _____
 Lines:

	1	2	3	4	5	6
Width	<u>3</u>	<u>3</u>	<u>3</u>	<u>3</u>	_____	_____
Length	<u>80</u>	<u>80</u>	<u>80</u>	<u>70</u>	_____	_____
Grade	<u>18</u>	<u>18</u>	<u>18</u>	<u>18</u>	_____	_____

 Stone Depth 18 18 18 18 _____

Layout to be followed by installer:

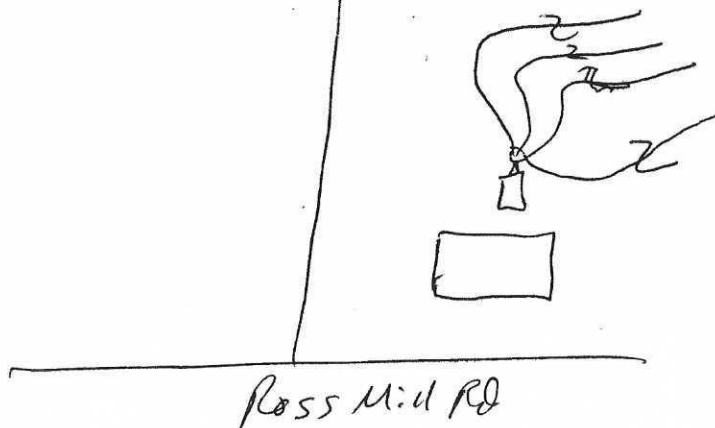

Improvements Permit By W. Vaughan Installer Jerry McGee
 Certificate of Completion By W. Vaughan Date of Inspection 6-27-88

* Construction must comply with all other applicable state and local regulations, but the permit is not a guarantee that the system will not malfunction and the Granville-Vance Health District will not be held responsible for a malfunctioning system.