

252-478-6083
252-478-4644

PAGE 1 OF 2

Franklin County Health Department
Division of Environmental Health
107 Industrial Drive-Suite C
Louisburg, North Carolina 27549

Phone: 919-496-8100

SEPTIC PERMIT

Fax: 919-496-8136

Permit Number: 5477 Type: I PIN : 2831-27-0464 Date: 5/21/2010

Applicant: DALE A VRCHOTA
1026 LAKE ROYALE
LOUISBURG, NC 27549

Owner: DALE A VRCHOTA
1026 LAKE ROYALE
LOUISBURG, NC 27549

Telephone: (252) 478-7329

Telephone: (252) 478-7329

Subdivision:

Lot Number: C31

Size: 1.000

Physical Address/ Location /Directions 104 INDIAN CV

Description: LifeTime _____ 5 Year X

TYPE FACIL Cottage # EMPLOY 1 # BEDRMS 2 GPD 240 LTAR 1.359/1
TYPE WAT Qm TYPE SYS I TYPE REP PtoI BSMT N BST FX N/A
SIZE TANK 900 SIZE CHB - SIZE NITR 3x180 MTD 30"

COMMENTS: 180' Innovative/Accepted

Septic Contractors are responsible for notifying the health department for final inspections, between 8:00-9:00 AM on the day of completion, Monday - Friday. Any request for final inspections received afterwards will be scheduled the same day, if possible, or the next workday. Have permit number and owner/applicant's name ready when making the call.

Actions of representatives of state or local agencies engaged in the evaluation and determination of measures required to effect the compliance with the provisions of this permit shall in no way be taken as a guarantee that wastewater disposal systems permitted and approved will function in a satisfactory manner for any given period of time, or that such employees assume any liability for damages, consequential or direct which are caused, or may be caused, by a malfunction of this wastewater treatment and disposal system.

Proper precautions must be taken to assure the proper functioning of the system after it has been covered. Do not run any heavy equipment over the system, as soft earth will allow damage to the tank and lines. Pipe all roof drains away from the septic system site to prevent flooding of the lines from surface water. Terrace the ground to prevent excessive drainage from higher areas adjacent to the system. Do not construct driveways over any part of the septic system unless proper provisions were made when the septic system was constructed. Only grass, not trees or shrubbery, should be cultivated over the lines. All plumbing fixtures should be carefully inspected periodically and any problems repaired immediately. All septic tanks should be pumped off by a permitted pump operator on a regular schedule, not to exceed every five years.

The improvement permit and construction authorization is a site approval, for the future installation of a wastewater treatment and disposal system. Changes in ownership of the site do not affect the validity of this permit. However, any alteration of the site or soil conditions, changes in the location of the proposed facility, changes to the wastewater flow and/or characteristics, or submittal of false information with the application or misrepresentation of the property lines may subject this permit to suspension or revocation.

FOR THIS TO BE A VALID CONSTRUCTION AUTHORIZATION, A LAYOUT SHEET MUST BE ATTACHED

IMPROVEMENT PERMIT DATE 5/24/10 EHS [Signature]
CONSTRUCTION AUTHORIZATION DATE 5/24/10 EHS [Signature]

Visit www.franklincountyenvironmentalhealth.com for permit information and tracking.

Franklin County Health Department

Name: VRCHOTA


Permit Number

5477

CONTRACTOR David Bouly TANK MANU R13 B1000 MANU DATE 3/13/12

WELL INSTALLED YES ☐ NO ☐ SYSTEM CODE C21203

SEPTIC SYSTEM LAYOUT (SKETCH SYSTEM LAYOUT HERE)

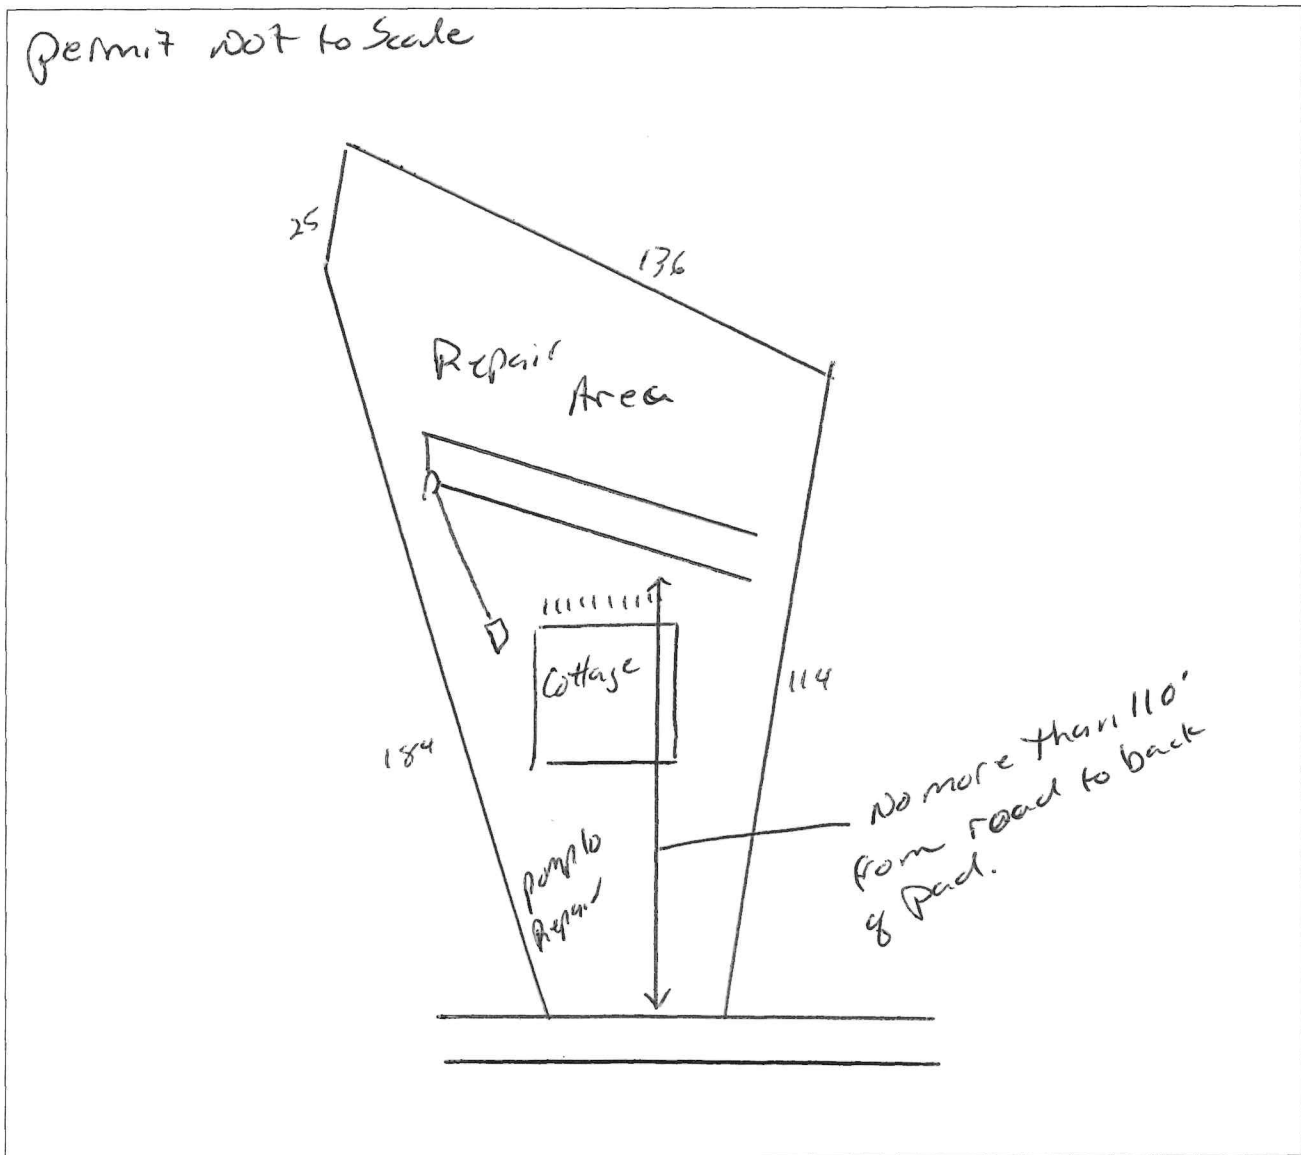

SEPTIC SYSTEM AS-BUILT (IF DIFFERENT FROM INITIAL LAYOUT) ON REVERSE

OPERATIONS PERMIT

DATE

7/3/12

EHS

[Signature]

TRANSACTION REPORT

JUN/09/2010/WED 11:29 AM

FAX (TX)

#	DATE	START T.	RECEIVER	COM.TIME	PAGE	TYPE/NOTE	FILE
001	JUN/09	11:23AM	912524786083	0:00:40	2	MEMORY OK	ECM 0777

252-478-6083

Franklin County Health Department
Division of Environmental Health
107 Industrial Drive-Suite C
Louisburg, North Carolina 27549

PAGE 1 OF 2

Phone: 919-496-8100

SEPTIC PERMIT

Fax: 919-496-8136

Permit Number: 5477 Type: I PIN: 2831-27-0464 Date: 5/21/2010

Applicant: DALE A VRCHOTA
1026 LAKE ROYALE
LOUISBURG, NC 27549Owner: DALE A VRCHOTA
1026 LAKE ROYALE
LOUISBURG, NC 27549

Telephone: (252) 478-7329

Telephone: (252) 478-7329

Subdivision:

Lot Number: C31

Size: 1.000

Physical Address/ Location /Directions 104 INDIAN CV

Description: LifeTime _____ 5 Year XTYPE FACIL Cotage # EMPLOY ✓ # BEDRMS 2 GPD 240 LTAR 1.35⁹/dTYPE WAT Om TYPE SYS I TYPE REP PlbI BSMT N BST FX N/ASIZE TANK 900 SIZE CHB ✓ SIZE NITR 3X180 MTD 30"COMMENTS: 180' Innovative Accepted

Septic Contractors are responsible for notifying the health department for final inspections, between 8:00-9:00 AM on the day of completion, Monday - Friday. Any request for final inspections received afterwards will be scheduled the same day, if possible, or the next workday. Have permit number and owner/applicant's name ready when making the call.

Actions of representatives of state or local agencies engaged in the evaluation and determination of measures required to effect the compliance with the provisions of this permit shall in no way be taken as a guarantee that wastewater disposal systems permitted and approved will function in a satisfactory manner for any given period of time, or that such employees assume any liability for damages, consequential or direct which are caused, or may be caused, by a malfunction of this wastewater treatment and disposal system.

Proper precautions must be taken to assure the proper functioning of the system after it has been covered. Do not run any heavy equipment over the system, as soft earth will allow damage to the tank and lines. Pipe all roof drains away from the septic system site to prevent flooding of the lines from surface water. Terrace the ground to prevent excessive drainage from higher areas adjacent to the system. Do not construct driveways over any part of the septic system unless proper provisions were made when the septic system was constructed. Only grass, not trees or shrubbery, should be cultivated over the lines. All plumbing fixtures should be carefully inspected periodically and any problems repaired immediately. All septic tanks should be pumped off by a permitted pump operator on a regular schedule, not to exceed every five years.

The improvement permit and construction authorization is a site approval, for the future installation of a wastewater treatment and disposal system. Changes in ownership of the site do not affect the validity of this permit. However, any alteration of the site or soil conditions, changes in the location of the proposed facility, changes to the wastewater flow and/or characteristics, or submittal of false information with the application or misrepresentation of the property lines may subject this permit to suspension or revocation.

ENVIRONMENT HEALTH APPLICATION (496-8100)

Permit #: **27718**Permit Type: **SEPTIC PERMIT**Date Issued: **05/21/2010**Project Address: **104 INDIAN CV.,**Location: **104 INDIAN CV.**Size #: **1.000**

Subdivision:

Lot #: **C31**Applicant: **VRCHOTA, DALE A.
1026 LAKE ROYALE
LOUISBURG NC 27549**Phone: **252-478-7329**Owner Name: **VRCHOTA, DALE A.**Phone: **252-478-7329**Owners Address: **1026 LAKE ROYALE****LOUISBURG NC 27549**Tax record: **19109**Pin #: **2831-27-0464**Parcel #: **LR0204 0031**Zoned: **AR**Setbacks Front: **30**Rear: **5**Side: **5**Proposed Use: **COTTAGE**# of bedrooms: **2**# of people: **2**Township: **CYPRESS**Public Water/Sewer: **TESI**

ST Road #:

Desc: **2831-27-0464**Fees Due: **\$325.00**Date Paid: **05/21/2010***** Please complete all sections below***

- ☐ Yes ☒ No Does this site contain any previously identified jurisdictional wetlands?
☐ Yes ☒ No Is any wastewater, other than domestic, going to be generated?
☐ Yes ☒ No Is the site subject to approval by any other public agency?

*If the answer to any of the above is "yes", applicant must submit supporting documentation.

Please indicate desired system type(s). Systems can be ranked in order of preference.

☐ Conventional ☐ Accepted ☐ Modified Conventional ☐ Alternative
☐ Other ☒ No Preference


Call Environmental Health (919.496.8100) between 8:00 - 9:00 am Monday - Friday in order to schedule an appointment with an environmental health specialist for your lot evaluation. This application for an improvement permit/construction authorization and well permit does not constitute approval for zoning, septic or building permits. It will be necessary to meet all guidelines for zoning, septic and building permits prior to construction. The permit is valid for either 60 months or without expiration, depending upon documentation submitted. (complete site plan= 60 months---complete surveyed plat=without expiration.)

Please contact the Environmental Health Department at 919.496.8100 or visit their website at www.franklincountyenvironmentalhealth.com to determine the status of your application prior to contacting the Planning & Inspections Department.

I hereby certify that I am the owner, or authorized by the owner to act as his/her legal representation. Furthermore, as legal representative (if applicable) I have advised the owner of my intention to apply for this wastewater treatment and disposal system and drinking water and well system permit.

I also certify that all of the statements made in this application and any attached documents are true, complete, and correct, to the best of my knowledge and belief, and are made in good faith. If information in this application for these improvements is falsified, changed or site is altered, then improvement permits and authorization to construct these improvements shall become invalid. Authorized county representatives are granted right of entry to make these evaluations or inspections, and to release information upon public request.

X

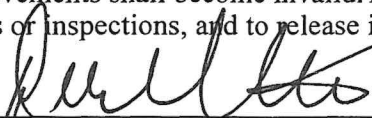
05/21/2010**Print & Signature of Owner or Owner's Legal Representative**

Franklin County DRC Permit RESIDENTIAL

Zoning Permit #: 15308



ADDRESS: 104 INDIAN CV.

PARCEL NO.: 2831-27-0464

ZONING: A R

SUBDIVISION:

LOT: C31

ISSUED TO: VRCHOTA, DALE A.
1026 LAKE ROYALE
LOUISBURG NC 27549

PHONE NUMBER: 252-478-7329

SETBACK: FRONT: 30 RIGHT: 5 LEFT: 5 REAR: 5

COUNTY WATER: TESI FLOODPLAIN: NO MISC FEE:

PERMIT TYPE: ZONING PERMIT

TYPE OF CONSTRUCTION: COTTAGE-NEW SEPTIC

PERMIT DATE: 05/21/2010 WATERSHED NO

TOWNSHIP CYP EXPIRE DATE: 11/21/2010

It is hereby certified that the above use as shown on the plats and plans submitted with this application conforms with all applicable provisions of the Franklin County Zoning Ordinance. The issuance of this application does not allow the violation of Franklin County Zoning Ordinance or other governing regulations. The applicant is responsible for obtaining a building permit (if required) prior to commencing work on the proposed improvement. A final zoning inspection must be scheduled by the applicant.

NOTES:

I hereby certify that all information I have provided to the Planning Department is true and accurate.

APPLICANT'S SIGNATURE

UTILITY COMPANY: PROGRESS ENERGY WAKE ELECTRIC OTHER

NUMBER OF STORIES: 1 1 1/2 2 2 1/2

SQUARE FOOTAGE: HEATED UNHEATED TOTAL

BASEMENT: YES NO

FIREPLACE: NO MASONARY MANUFACTURED

PLAN SETS: MODULAR STICKBUILT

NAME OF:

ELECTRICIAN: MECHANICAL:

PLUMBING:

COST OF CONSTRUCTION:

NO MORE THAN 2 STRUCTURAL DEVIATIONS OR PLANS MUST BE REDRAWN

DEPARTMENTAL USE ONLY

	INITIALS (IN)	DATE	INITIALS (OUT)	DATE
ZONING	JTR	5/21/10		
INITIAL PERMITTING				
ADDRESSING				
PLAN REVIEW				
FIRE REVIEW				
SEPTIC/SEWER				
FINAL PERMITTING				

104

Indian
Cove
(C31)

