



OPERATION PERMIT

Franklin County Health Department
107 Industrial Drive
Louisburg, NC 27549
Phone:

For Office Use Only

*CDP File Number 458944 - 1

County ID Number:

Evaluated For: NEW

Property Owner: Leroy Goldsmith
Owner Address: 718 Franklin St

City: Coatesville
State/Zip: PA/ 19320
Phone #:
Address: 20 Aggie Way
Franklinton, NC 27525

Road #:
Township:
Subdivision:
Phase : NEW Lot:

Structure: MOBILE HOME
of Bedrooms: 4
of People: 8
Water Supply: NEW WELL
Saprolite System?: ☐ Yes ☒ No
Pump Required?: ☐ Yes ☒ No
Design Flow: 480
System Classification/Description: Type IIb - Accepted
Wastewater Gravity System

Installer: Busy Beez

Certification #:

Specific System EZFLOW EZ 1203H-GEO

Installed:

Septic Tank Date: _____

STB: 616

Pump Tank Date: _____

PT:

Comments:

This system has been installed in compliance with applicable NC General Statutes, Rules for Sewage Treatment and Disposal, and all conditions of the Improvement Permit and Construction Authorization.

PERMIT CONDITIONS:

I. Performance: System shall perform in accordance with Rule .1301.

II. Monitoring: As required by Rule .1301.

III. Maintenance: Ground absorption sewage treatment and disposal systems shall be checked, and the contents of the septic tank removed, periodically from all compartments, to ensure proper operation of the system. The contents shall be pumped whenever the solids level is found to be more than 1/3 of the liquid depth in any compartment.

Other:

Subsurface Operator Required: ☐ Yes ☒ No

If yes, see attached sheet for additional operation conditions, maintenance and reporting.

Operation:

Other:

Authorized State Agent: Leonard, Shad

Date of Issue: 12/30/2025

Owner/Applicant:



File # 458944 PIN# _____

Property Address: 20 Aggie Way

Applicant or Owner Name: Brad Haverman

Environmental Health Septic/Well Permit Diagram

Building permits cannot be issued nor should construction begin without Construction Authorization Issuance.

☒ Septic Improvement Permit ☒ Septic Construction Authorization (CA) ☒ CA Reissue** ☒ As Built
☒ Well Construction Authorization ☒ Additional Diagram/Specifications Attached

Diagram Date**: 12/30/25 EHS: [Signature]

**Any previously dated CA diagram is revoked and/or invalid. Confirm this is the valid diagram for the site before beginning any construction.

Installation/grouting inspections may be scheduled the day before, or, the day of installation until 9am by contacting the Environmental Health office at 919 496 8100. A revisit fee may apply if installation is not ready for inspection at the time requested. Septic Operations Permits will be issued after installation is approved, all permits conditions are met, and any outstanding fees are paid. Well Certificate of Completion will be issued after well head approval, all permit conditions are met, and any outstanding fees are paid.


Septic Tank 1000 Pump Tank _____ Drainfield 3'x350' Type System Acc Max Trench Depth 30"

Septic Contractor Buzzy Beez Septic/Pump tank dates DB 1000 6/16 Pump Fee Paid _____

Well Contractor _____ Well Head Date: _____ Pump Final: _____ N/A (circle)

EZ Flow - Dbox
✓ d Tank + lines 12/30/25

As Built (Not to scale)

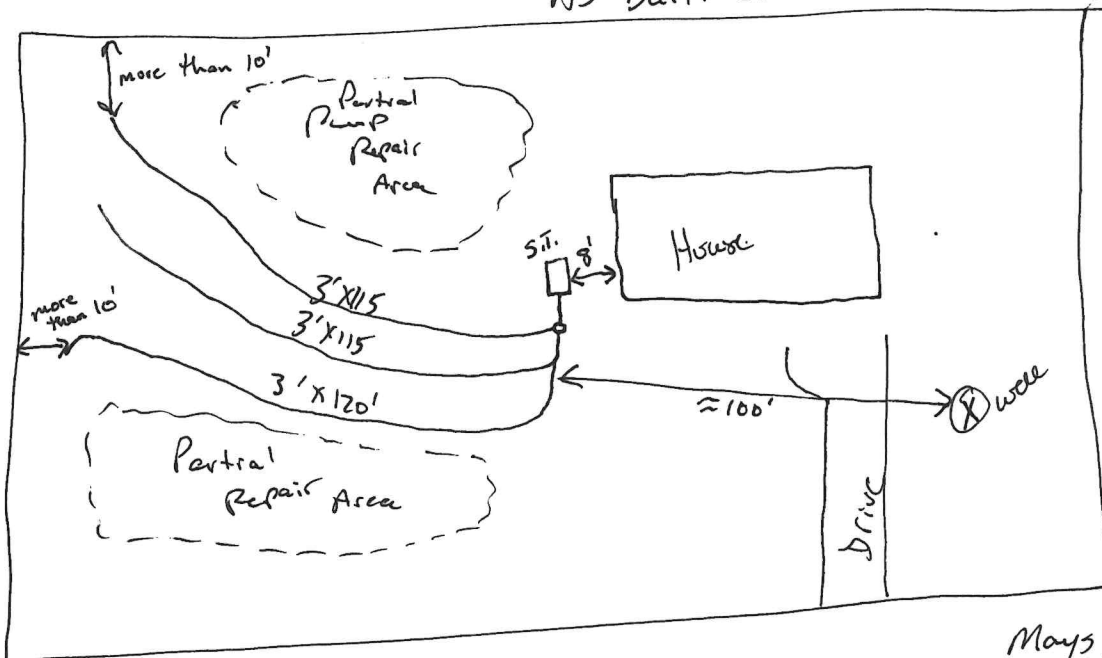

Aggie Way