



OPERATION PERMIT
Franklin County Health Department
107 Industrial Drive

Louisburg NC 27549

For Office Use Only		Page 1 of 2
*CDP File Number	317575 - 1	
County ID Number:	2848-93-2051	
Evaluated For:	NEW	

Property Owner:	TIMOTHY HEDLUND	
Address:	50 CONE LN	
City:	LOUISBURG	
State/Zip:	NC	27549
Phone #:	(276) 620-8330	
Address	200 RAYMOND THARRINGTON RD	
Road #	LOUISBURG	NC 27549
Township:		
Subdivision:	Phase:	Lot:

Structure:	SINGLE FAMILY	
# of Bedrooms:	3	
# of People:	1	
Water Supply:	N/A	
Saprolite System?	☐ Yes ☐ No Pump Required? ☐ Yes ☒ No	
Design Flow:	3 6 0	
System Classification/Description:		

Installer:	TRUE WORKS	
Specific System Installed:		
STB:	1000	
PT:		
Comments:		
Certification #:		
Septic Tank Date:	0 6 / 1 4 / 2 0 2 0	
Pump Tank Date:	/ /	

This system has been installed in compliance with applicable NC General Statutes, Rules for Sewage Treatment and Disposal, and all conditions of the Improvement Permit and Construction Authorization.

- PERMIT CONDITIONS:**
- I. Performance: System shall perform in accordance with Rule .1961.
 - II. Monitoring: As required by Rule .1961.
 - III. Maintenance: Ground absorption sewage treatment and disposal systems shall be checked, and the contents of the septic tank removed, periodically from all compartments, to ensure proper operation of the system. The contents shall be pumped whenever the solids level is found to be more than 1/3 of the liquid depth in any compartment.

Other:

Subsurface Operator Required ☐ Yes ☐ No
If yes, see attached sheet for additional operation conditions, maintenance and reporting.
Operation:

Other:

Authorized State Agent: 2739 - Joel Bendel
Authorized State Agent Signature:
Owner/Applicant Signature: _____

Date of Issue: 1 2 / 1 4 / 2 0 2 0

As-Built Drawing Attached
☐ Saprolite System?

Chas Rem 400
Chas Rem 400
Chas Rem 400



File # 317575 PIN# 2848-93-2051

Property Address: 50 Cone Ln

Applicant or Owner Name: Mary Hedlund

Environmental Health Septic/Well Permit Diagram

Building permits cannot be issued nor should construction begin without Construction Authorization issuance.

☒ Septic Improvement Permit ☒ Septic Construction Authorization (CA) ☐ CA Reissue** ☐ As Built
☒ Well Construction Authorization ☐ Additional Diagram/Specifications Attached

Diagram Date**: 5-28-20 EHS: Shedlund


**Any previously dated CA diagram is revoked and/or invalid. Confirm this is the valid diagram for the site before beginning any construction.

Installation/grouting inspections may be scheduled the day before, or, the day of installation until 9am by contacting the Environmental Health office at 919 496 8100. A revisit fee may apply if installation is not ready for inspection at the time requested. Septic Operations Permits will be issued after installation is approved, all permits conditions are met, and any outstanding fees are paid. Well Certificate of Completion will be issued after well head approval, all permit conditions are met, and any outstanding fees are paid.

Septic Tank 1000 Pump Tank N/A Drainfield 3' x 270' Type System Accepted Max Trench Depth 28"

Septic Contractor Tremonts Septic/Pump tank dates Di3 1000 6-14-20 Pump fee ☒ YES ☐ NO pd

Well Contractor Glen Davis Well Grout date: N/A

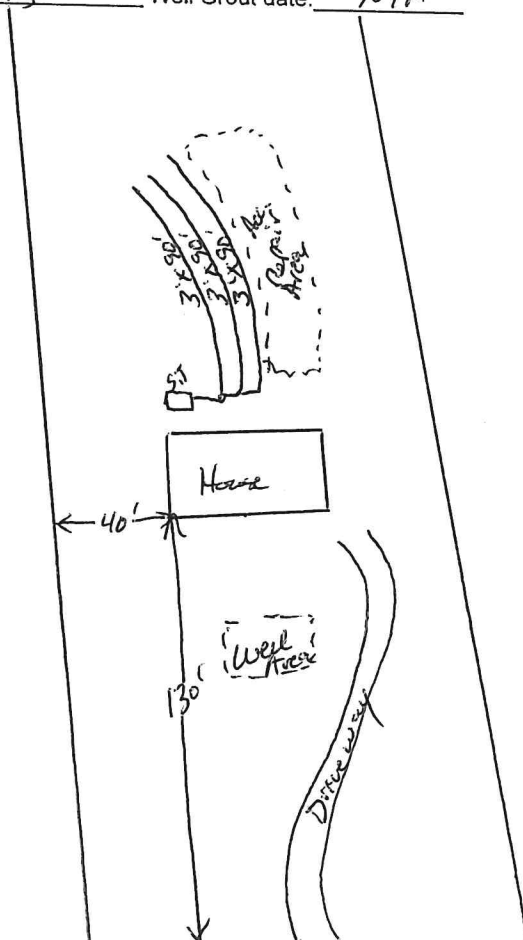

- Drawing not to scale
- Maintain proper setbacks,
- Install drain lines on contour.
- Layout may vary slightly