

Granville - Vance District Health Department
Environmental Health

Pin 183300028850

Permit Number 5444

☒ Improvement Permit

☒ Construction Authorization

Final Sketch

Bergen Custom Homes
Applicants Name

Fieldstone West 47
Subdivision - Section - Lot

Physical Address: Belmont Circle

David Brantley & Sons
System Installer

9-2-2011
Date

System design and details as installed.

Septic Tank Information:

Date: 6-28-11
Manufacture: D-13 1000gal
ID #: STB 646


Pump Tank Information:

Date: _____
Manufacture: _____
ID #: _____

Distribution Box ☒

Pressure Manifold _____
Serial Distribution _____
Pump Info: _____

Type of Facility: House Number of Bedrooms: 4
Type of System: ☒ Gravity _____ Pump _____ Gravel ☒ Polystyrene _____ Chamber _____ Other: _____

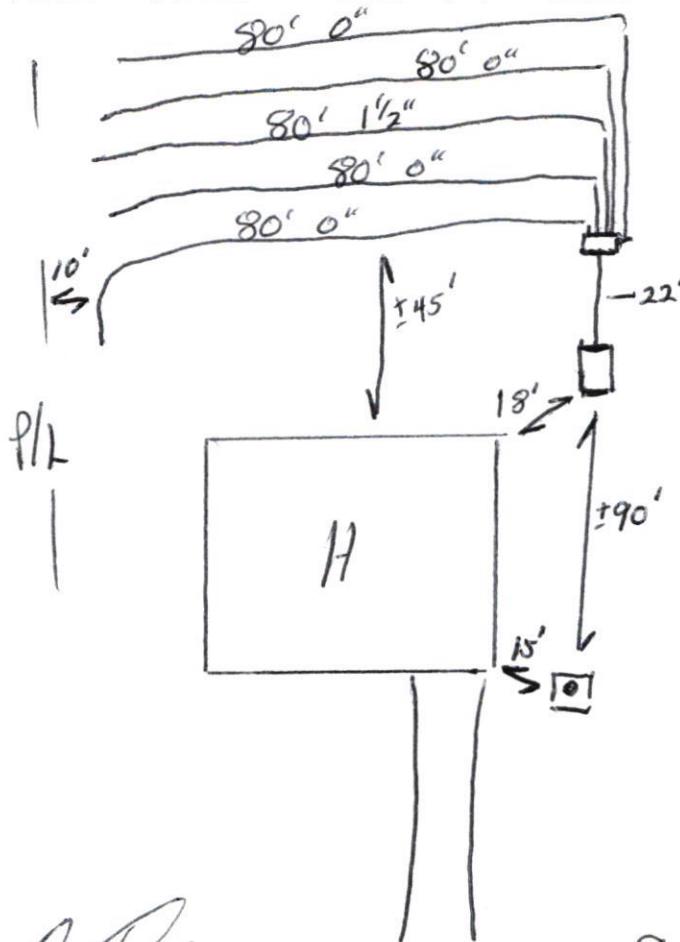

[Signature]
Authorized Signature

9-2-2011
Date

Handwritten text, possibly a signature or name, in the top left corner.

Handwritten text, possibly a date or short note, in the top right corner.

Handwritten text, possibly a date or short note, in the middle right section.

Handwritten text, possibly a date or short note, in the middle right section.

PERMIT NUMBER **05444**

GRANVILLE-VANCE DISTRICT HEALTH DEPARTMENT IMPROVEMENT AND OPERATION PERMITS

COUNTY: <u>Granville</u>	TAX NO. <u>195500</u> <u>022250</u>	TYPE OF ESTABLISHMENTS			*THIS PERMIT SHALL BE ACCOMPANIED BY A LAYOUT SHOWN ON A PLAT, INCLUDING SYSTEM REQUIREMENTS. *THIS IMPROVEMENT PERMIT IS SUBJECT TO REVOCATION IF THE INTENDED USES CHANGE FROM THOSE SHOWN ON THE IMPROVEMENT PERMIT. CHANGES SHALL REQUIRE HEALTH DEPARTMENT APPROVAL.
	SR. NO. <u>1717</u>	RESIDENCE ☒	NUMBER OF BEDROOMS: <u>4</u>	NUMBER OF OCCUPANTS:	
OWNER: <u>Bergen Custom Homes</u>	BUSINESS ☐	WELL ☐	OTHER ☐		
APPLICANT'S ADDRESS: <u>12735 Wake Forest Church Rd</u> <u>Suite 207 Wake Forest NC</u>	OTHER ☐	PUBLIC ☐			
PROPERTY ADDRESS/LOCATION: <u>Bedmont Circle</u> <u>Woodland Church Rd</u>	WATER SUPPLY	INITIAL INSTALLATION	REPAIR		
	TYPE OF WASTEWATER SYSTEM	<u>Type IIa</u>	<u>Type IIa</u>		
SUBDIVISION: <u>Fieldstone West</u>	DESIGN FLOW:	<u>1.20 gpd</u>			
	LTAR:	<u>.3</u>			
LOT NUMBER: <u>47</u>	ABSORPTION AREA:	<u>1600 sq ft</u>			
	TRENCH WIDTH:	<u>3'</u>			
REFERENCE SKETCH (SEE PLAT FOR DETAILS) <u>See sketch on back.</u> <u>Dig trench 12' x 24" deep</u> <u>put on concrete. Stay at least 10' from house.</u> <u>Insulation below, 10' from property line, 100' from well. Do not install on roll top.</u> <u>Insulation in air.</u>	TRENCH DEPTH:	<u>12' x 24"</u>			
	TRENCH SPACING:	<u>11' on center</u>			
	TOTAL TRENCH LENGTH:	<u>X 400'</u>			
	NUMBER OF TRENCHES:	<u>2 - 8'</u>			
	GRAVEL DEPTH:	<u>X E-Z flow</u>			
	TANK SIZE:	<u>1500 gal</u>			
	PUMP TANK SIZE:				
DISTRIBUTION DEVICE:					
				PERMIT VALID FOR: 5 YEARS YES ☒ NO ☐ NO EXPIRATION YES ☐ NO ☐	

IMPROVEMENT PERMIT

DATE:

2-15-06

FOR: Bergen Custom Homes

ISSUED BY: M.E. Young R.S.

CONSTRUCTION AUTHORIZATION FOR IMPROVEMENT PERMIT# 05444

Unless otherwise indicated, the same conditions above apply regarding system type, layout, location and installation requirements.
(The wastewater system cannot be installed until authorization is signed)

Comments: _____

Date: 2-15-06 Environmental Health Specialist: M.E. Young R.S.

Construction Authorization Addendum ☐ Yes ☒ No

OPERATION PERMIT

DATE:

9-2-2011

SYSTEM INSTALLED BY: David Brantley & Sons

ISSUED BY: David Cummins

PERFORMANCE, MONITORING, MAINTENANCE AND OPERATION
AS REQUIRED BY RULE .1961