

eval

**Franklin County Health Department
Division of Environmental Health
107 Industrial Drive-Suite C
Louisburg, North Carolina 27549**

PAGE 1 OF 2

Phone: 919-496-8100

SEPTIC PERMIT

Fax: 919-496-8136

Permit Number: 9108

Type: R PIN :

Date: 12/22/2016

Applicant: CHRIS SCHIEN
30 RAY AVE
ZEBULON, NC 27597

Owner: CHRIS SCHIEN
30 RAY AVE
ZEBULON, NC 27597

Telephone: (919) 250-8004

Telephone: (919) 250-8004

Subdivision: BUNN LAKE

Lot Number:

Size: .79

Physical Address/ Location /Directions 30 RAY AVE

Description: LifeTime _____ 5 Year 10

TYPE FACIL SFD # EMPLOY 1 # BEDRMS 3 GPD 360 LTAR _____
TYPE WAT Priv TYPE SYS C/A TYPE REP P to C/A BSMT N BST FX N/A
SIZE TANK Existing SIZE CHB 1000 SIZE NITR 3'x300' MTD 48"

COMMENTS: See attached for specifications.

Septic Contractors are responsible for notifying the health department for final inspections, between 8:00-9:00 AM on the day of completion, Monday - Friday. Any request for final inspections received afterwards will be scheduled the same day, if possible, or the next workday. Have permit number and owner/applicant's name ready when making the call.

Actions of representatives of state or local agencies engaged in the evaluation and determination of measures required to effect the compliance with the provisions of this permit shall in no way be taken as a guarantee that wastewater disposal systems permitted and approved will function in a satisfactory manner for any given period of time, or that such employees assume any liability for damages, consequential or direct which are caused, or may be caused, by a malfunction of this wastewater treatment and disposal system.

Proper precautions must be taken to assure the proper functioning of the system after it has been covered. Do not run any heavy equipment over the system, as soft earth will allow damage to the tank and lines. Pipe all roof drains away from the septic system site to prevent flooding of the lines from surface water. Terrace the ground to prevent excessive drainage from higher areas adjacent to the system. Do not construct driveways over any part of the septic system unless proper provisions were made when the septic system was constructed. Only grass, not trees or shrubbery, should be cultivated over the lines. All plumbing fixtures should be carefully inspected periodically and any problems repaired immediately. All septic tanks should be pumped off by a permitted pump operator on a regular schedule, not to exceed every five years.

The improvement permit and construction authorization is a site approval, for the future installation of a wastewater treatment and disposal system. Changes in ownership of the site do not affect the validity of this permit. However, any alteration of the site or soil conditions, changes in the location of the proposed facility, changes to the wastewater flow and/or characteristics, or submittal of false information with the application or misrepresentation of the property lines may subject this permit to suspension or revocation.

FOR THIS TO BE A VALID CONSTRUCTION AUTHORIZATION, A LAYOUT SHEET MUST BE ATTACHED

IMPROVEMENT PERMIT

DATE _____ EHS _____

CONSTRUCTION AUTHORIZATION

DATE 1/3/17 EHS [Signature]

Vist www.franklincountyenvironmentalhealth.com for permit information and tracking.

Franklin County Health Department

Name: SCHIEN


Permit Number

9108

CONTRACTOR Quality landscape Infiltrator plastic
TANK MANU _____ MANU DATE _____

WELL INSTALLED YES _____ NO _____ SYSTEM CODE EC1203-P-12

SEPTIC SYSTEM LAYOUT (SKETCH SYSTEM LAYOUT HERE)

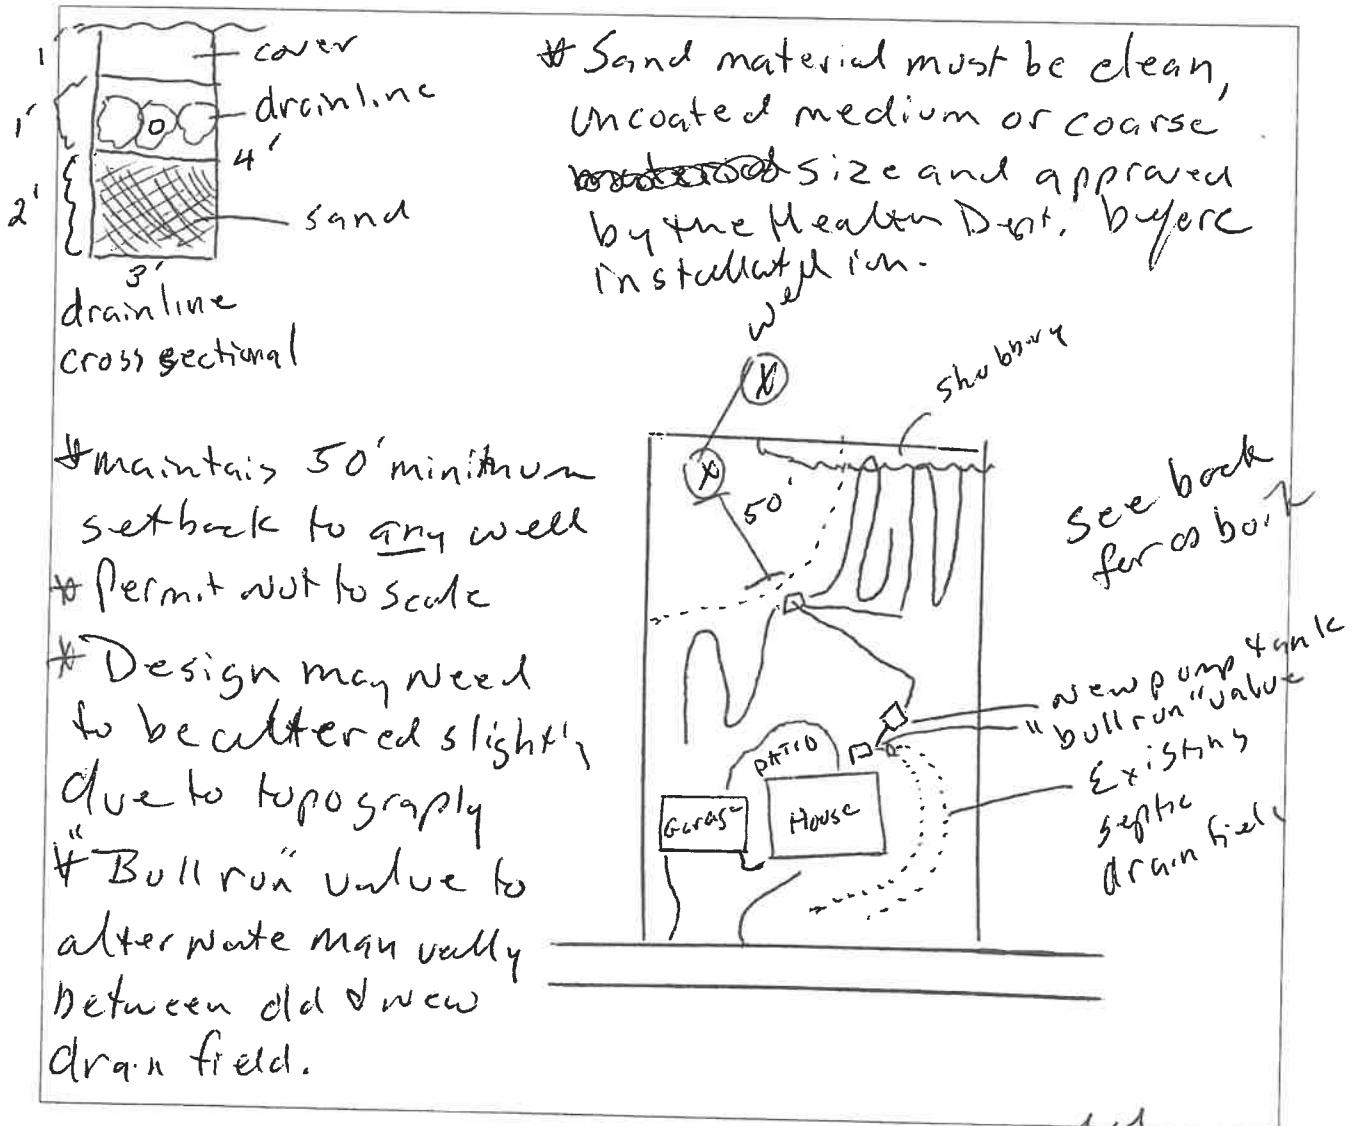

SEPTIC SYSTEM AS-BUILT
(IF DIFFERENT FROM INITIAL LAYOUT)
ON REVERSE

OPERATIONS PERMIT

DATE

3/20/17

EHS

system installed 1st week of March

~~Fax - 252-478-4644~~

**Franklin County Health Department
Division of Environmental Health
107 Industrial Drive-Suite C
Louisburg, North Carolina 27549**

PAGE 1 OF 2

Phone: 919-496-8100

SEPTIC PERMIT

Fax: 919-496-8136

Permit Number: 6024

Type: R PIN :

Date: 8/2/2011

Applicant: CHRIS SCHIENI
30 RAY AVE
ZEBULON, NC 27597

Owner:
LOUISBURG, NC 27549

Telephone: (919) 250-8004

Telephone:

Subdivision:

Lot Number:

Size:

Physical Address/ Location /Directions 30 RAY AVE

Description: LifeTime _____ 5 Year _____

TYPE FACIL SFD # EMPLOY 1 # BEDRMS 3 GPD 360 LTAR _____

TYPE WAT _____ TYPE SYS _____ TYPE REP _____ BSMT _____ BST FX _____

SIZE TANK Existing SIZE CHB 1 SIZE NTR 3x100 MTD _____

COMMENTS _____

Septic Contractors are responsible for notifying the health department for final inspections, between 8:00-9:00 AM on the day of completion, Monday - Friday. Any request for final inspections received afterwards will be scheduled the same day, if possible, or the next workday. Have permit number and owner/applicant's name ready when making the call.

Actions of representatives of state or local agencies engaged in the evaluation and determination of measures required to effect the compliance with the provisions of this permit shall in no way be taken as a guarantee that wastewater disposal systems permitted and approved will function in a satisfactory manner for any given period of time, or that such employees assume any liability for damages, consequential or direct which are caused, or may be caused, by a malfunction of this wastewater treatment and disposal system.

Proper precautions must be taken to assure the proper functioning of the system after it has been covered. Do not run any heavy equipment over the system, as soft earth will allow damage to the tank and lines. Pipe all roof drains away from the septic system site to prevent flooding of the lines from surface water. Terrace the ground to prevent excessive drainage from higher areas adjacent to the system. Do not construct driveways over any part of the septic system unless proper provisions were made when the septic system was constructed. Only grass, not trees or shrubbery, should be cultivated over the lines. All plumbing fixtures should be carefully inspected periodically and any problems repaired immediately. All septic tanks should be pumped off by a permitted pump operator on a regular schedule, not to exceed every five years.

The improvement permit and construction authorization is a site approval, for the future installation of a wastewater treatment and disposal system. Changes in ownership of the site do not affect the validity of this permit. However, any alteration of the site or soil conditions, changes in the location of the proposed facility, changes to the wastewater flow and/or characteristics, or submittal of false information with the application or misrepresentation of the property lines may subject this permit to suspension or revocation.

FOR THIS TO BE A VALID CONSTRUCTION AUTHORIZATION, A LAYOUT SHEET MUST BE ATTACHED

IMPROVEMENT PERMIT

DATE 8/2/11 EHS [Signature]

CONSTRUCTION AUTHORIZATION

DATE 8/2/11 EHS [Signature]

Visit www.franklincountyenvironmentalhealth.com for permit information and tracking.

Franklin County Health Department

Name: SCHIENI

Permit Number

6024

CONTRACTOR

David B. Smith

TANK MANU

MANU DATE

WELL INSTALLED

YES

NO

SYSTEM CODE

E21203


SEPTIC SYSTEM LAYOUT

(SKETCH SYSTEM LAYOUT HERE)

Perform the following in attempt to correct malfunction:

- ① Check for leaking toilets/water using fixtures in home - repair if needed
- ② Dig to see what type of distribution is used - (D-box vs. serial) - adjust D-box if needed
- ③ ~~Dig~~ Determine drainfield layout - ~~cut off~~ or re-route wastewater in drain line that is malfunctioning replace any portion of drain line that is no longer in use

A Contractor to contact MD on day of repair to schedule an on-site meeting to determine what corrective action is to be taken

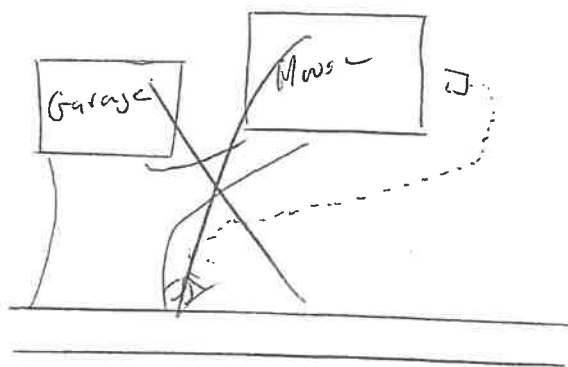

SEPTIC SYSTEM AS-BUILT

(IF DIFFERENT FROM INITIAL LAYOUT)

ON REVERSE

OPERATIONS PERMIT

DATE

8/5/11

EHS