

Granville – Vance District Health Department
Environmental Health

Pin 182500888063

Permit Number 7119

☒ Improvement Permit

☒ Construction Authorization

Final Sketch

ABC Homes
Applicants Name

Ironwood 13
Subdivision – Section – Lot

Physical Address: Ironwood Dr.

Triangle Pump & Tank
System Installer

1-3-2012
Date

System design and details as installed.

Septic Tank Information:

Date: 7-29-11
Manufacture: Mills-1200
ID #: STB-857

Pump Tank Information:


Date: _____
Manufacturer: _____
ID #: _____

Distribution Box ☒

Pressure Manifold _____
Serial Distribution _____
Pump Info: _____

Type of Facility: House Number of Bedrooms: 4
Type of System: ☒ Gravity _____ Pump _____ Gravel _____ Polystyrene ☒ Chamber _____ Other: _____

Infiltrator Quick 4

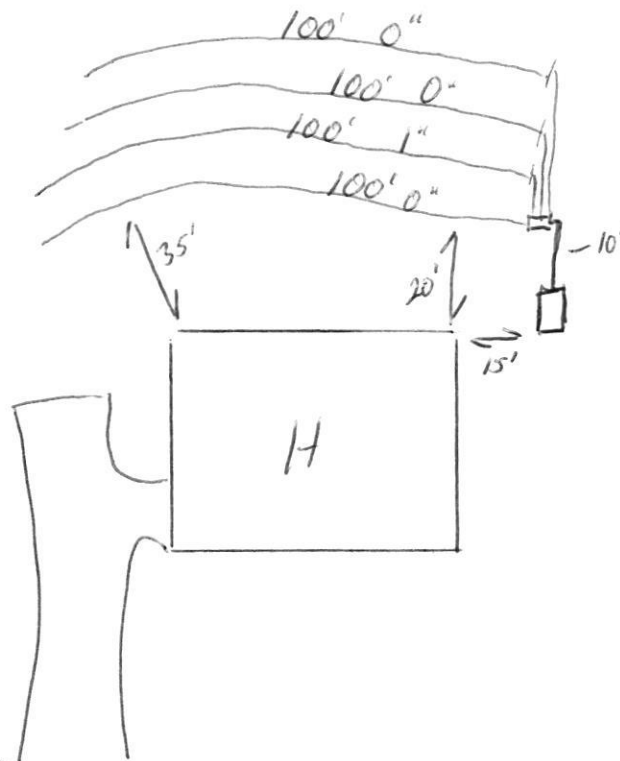

David Kunkle
Authorized Signature

1-4-2011
Date

2:00

PERMIT NUMBER 07119

GRANVILLE-VANCE DISTRICT HEALTH DEPARTMENT IMPROVEMENT AND OPERATION PERMITS

Zoning #
17232

COUNTY:	TAX NO.	TYPE OF ESTABLISHMENTS			*THIS PERMIT SHALL BE ACCOMPANIED BY A LAYOUT SHOWN ON A PLAT, INCLUDING SYSTEM REQUIREMENTS.
Granville	182500888063	RESIDENCE ☒	NUMBER OF BEDROOMS:	NUMBER OF OCCUPANTS:	
	SR. NO.	BUSINESS ☐	4	8 max	
OWNER:	MBC Homes	OTHER ☐	WATER SUPPLY	WELL ☒	OTHER ☐
APPLICANT'S ADDRESS:	1713855 Ironwood Dr. Franklin 27.25	TYPE OF WASTEWATER SYSTEM	INITIAL INSTALLATION	REPAIR	*THIS IMPROVEMENT PERMIT IS SUBJECT TO REVOCATION IF THE INTENDED USES CHANGE FROM THOSE SHOWN ON THE IMPROVEMENT PERMIT. CHANGES SHALL REQUIRE HEALTH DEPARTMENT APPROVAL.
PROPERTY ADDRESS/LOCATION:	3855 Ironwood Dr.	DESIGN FLOW:	480 gpd	Type III g	
SUBDIVISION:	Ironwood	LTAR:	.3 gpd/sf ²		
LOT NUMBER:	13	ABSORPTION AREA:	1600 sf ²		
REFERENCE SKETCH (SEE PLAT FOR DETAILS)		TRENCH WIDTH:	3'		
		TRENCH DEPTH:	24"		
		TRENCH SPACING:	9' o.c.		
		TOTAL TRENCH LENGTH:	400'		
		NUMBER OF TRENCHES:	4		
		GRAVEL DEPTH:	Accepted status	Chambers	
		TANK SIZE:	1200 gal		PERMIT VALID FOR: 5 YEARS YES ☒ NO ☐
		PUMP TANK SIZE:	N/A		NO EXPIRATION YES ☐ NO ☒
		DISTRIBUTION DEVICE:	Distribution Box		

IMPROVEMENT PERMIT DATE: 10-13-2011

FOR: MBC Homes
ISSUED BY: David Cumber

CONSTRUCTION AUTHORIZATION FOR IMPROVEMENT PERMIT# 7119

Unless otherwise indicated, the same conditions above apply regarding system type, layout, location and installation requirements.

(The wastewater system cannot be installed until authorization is signed)

Comments: Do not install in wet conditions - call 693 2655 w/ questions

Date: 10-13-2011 Environmental Health Specialist: David Cumber
Construction Authorization Addendum ☐ Yes ☒ No

OPERATION PERMIT

DATE: 1-3-2012

SYSTEM INSTALLED BY: Trichter Pump & Tank
ISSUED BY: David Cumber

PERFORMANCE, MONITORING, MAINTENANCE AND OPERATION
AS REQUIRED BY RULE .1961