



IMPROVEMENT PERMIT

Franklin County Health Department
107 Industrial Drive
Louisburg, NC 27549
Phone:

For Office Use Only

*CDP File Number 392646 - 1
County ID Number:
Evaluated For: NEW

PERMIT VALID UNTIL: 04/14/2028

***NOTE TO INSPECTIONS DIVISION:** Building Permits cannot be issued with this Improvement Permit.

Applicant: MIGUEL GOVEA SALAZAR
Address: 1231 UNIVERSITY DR
City: DURHAM
State/Zip: NC 27707
Phone #:

Property Owner:
Address:
City:
State/Zip:
Phone #:

Property Location & Site Information

Address: 139 HATCHET CV LOUISBURG, NC 27549 Subdivision: LOT ROYALE Block/Phase: NEW Lot:

Directions

Road #: 138 HATCHET CV
Structure: SINGLE FAMILY
of Bedrooms: 3
of People: 3
*Water Supply: N/A

System Specifications

Initial System

*Site Classification: Provisionally Suitable
Design Flow: 360
Soil Application Rate: 0.3000

Minimum Trench Depth: Inches
Maximum Trench Depth: 28 Inches

*System Classification/Description:

TYPE II A. CONV SYSTEM (SINGLE-FAMILY OR 480 GPD OR LESS)

Septic Tank: 1000 Gallons
Pump Required ☐ Yes ☒ No ☐ May Be Required

*Proposed System:
25% REDUCTION

Pump Tank: Gallons

Repair System Required: ☐ Yes ☐ No ☐ No, but has Available Space * 15A NCAC 18A. 1945 * Repair Area Exempt

No grading or construction activity is allowed in areas designated for system and repair without approval of Health Department.

*Site Modifications

The issuance of this permit by the Health Department in no way guarantees the issuance of other permits. The permit holder is responsible for checking with appropriate governing bodies in meeting their requirements.

*Permit Conditions

The Department and Local Health Department may impose conditions on the issuance and may revoke the permits for failure of the system to satisfy the conditions, the rules, or this article. This permit is subject to revocation if the site plan, plat, or intended use changes (NCGS 130A-335(f)). The person owning or controlling the system location, installing, operation, maintenance, monitoring, reporting, and repair (.1938(b)).

Authorized State Agent: Bendel, Joel Date of Issue: 04/14/2023

Total Time: (HH:MM)

☐ Hand Drawing ☐ Import Drawing **Site Plan/Drawing attached.**



Construction Authorization

Franklin County Health Department
107 Industrial Drive
Louisburg, NC 27549
Phone: _____

For Office Use Only

*CDP File Number: 392646 - 1

County ID Number: _____

Evaluated For: NEW

PERMIT VALID UNTIL: 04/14/2028

☐ Open Pump System Sheet

Applicant: MIGUEL GOVEA SALAZAR

Address: 1231 UNIVERSITY DR

City: DURHAM

State/Zip: NC 27707

Phone #: _____

Property Owner: _____

Address: _____

City: _____

State/Zip: _____

Phone #: _____

Property Location & Site Information

Address/Road #: 139 HATCHET CV
LOUISBURG, NC 27549

Subdivision: LOT ROYALE Phase: NEW Lot: _____

Directions:

Structure: SINGLE FAMILY 138 HATCHET CV

of Bedrooms: 3

of People: 3

*Water Supply: COMMUNITY

System Specifications

*Site Classification: Provisionally Suitable

Design Flow: 360

Soil Application Rate: 0.3000

Minimum Trench Depth: _____ Inches

Maximum Trench Depth: 28 Inches

*System Classification/Description:

TYPE II A. CONV SYSTEM (SINGLE-FAMILY OR 480 GPD OR LESS)

Minimum Soil Cover: _____ Inches

Maximum Soil Cover: _____ Inches

*Proposed System:

25% REDUCTION

*Distribution Type: GRAVITY - PARALLEL (eq. d-box)

Nitrification Field: _____ Sq. ft.

No. Drain Lines: _____

Total Trench Length: 300 ft.

Trench Spacing: _____ - 9

Trench Width: _____ - 3

Aggregate Depth: _____ inches

☐ Inches O.C.

☒ Feet O.C.

☐ Inches

☒ Feet

Pump Required: ☐ Yes ☒ No ☐ May Be Required

Pump Tank: _____ Gallons

Grease Trap: _____ Gallons

Septic Tank Installer

Grade Level Required: ☐ I ☐ II ☐ III ☐ IV

The issuance of this permit by the Health Department in no way guarantees the issuance of other permits. The permit holder is responsible for checking with appropriate governing bodies in meeting their requirements.

*Permit Conditions:

The Authorization for Wastewater System Construction shall be valid for a period equal to the period of validity of the Improvement Permit and may be issued at the same time the Improvement Permit issued (NCGS 130A-336(b)). If the installation has not been completed during the period of validity of the Construction Permit, the information submitted in the application for a permit or Construction Authorization shall become invalid, and may be suspended or revoked (.1937(g)). The person owning or controlling the system shall be responsible for assuring compliance with the laws, rules, and permit conditions regarding system location, installation, operation, maintenance, monitoring, reporting

Authorized State Agent: Bendel, Joel

Date of Issue: 04/14/2023

☐ Hand Drawing

☐ Import Drawing

Site Plan/Drawing attached.

Total Time : (HH:MM) _____



CDP#
392646

Franklin County Environmental Health
127 S Bickett Blvd.
Louisburg, NC 27549
Phone (919) 496-8100
www.franklincountync.gov

Issued to: Miguel Govea Salazar

Location: 139 HATCHET CV LOUISBURG , NC 27549

NEW SEPTIC APPLICATION

Application Type: NEW SEPTIC

Application Number: E-23-331

Building Type:

Project Type: Single Family Dwelling

of Bedrooms: 3

Residential Project Type: Single Family Dwelling

Building Foundation: Crawlspace

Water Source: Other

Date: March 29, 2023

Acreage: 0.38

Zoning: R-30

of Occupants: 3

Commercial Project Type:

Square Footage of Facility:

Number of Employees:

Number of Seats:

Preferred Type of Septic System: (1) Conventional (rock)

Notes:

Parcel ID #: 020078

Subdivision: LOT ROYALE

Applicant Information

Applicant Name: Miguel Govea Salazar

Address: 1231 university dr durham , nc 27707

Phone: 9193586180

Email: mgsbuilders1@gmail.com

Property Owner Information

Owner Name:

Address:

Phone:

Email:

General Contractor Information

Contractor Name:

Address:

Phone:

Email:

Zoning

Zoning Permit #: Z-23-438

Front Setback: 15

Left Setback: 5

County Water: TESI

Right Setback: 5

Rear Setback: 5

The applicant shall notify the Environmental Health Department upon submittal of this application if any of the following apply to the property/site in question. If this answer is "Yes" the applicant must attach supporting documentation and/or show their location on the plot/site plan.

Does the site contain any jurisdictional wetlands? No

Does the site contain, or have within 100 feet, any existing wells and/or septic systems? No

Is any wastewater going to be generate other than domestic sewage? No


Is the site subject to approval by an other public agency? No

Are there any easements or right-of-ways on this site? No

Are there any underground utilities on the site? No

Call Environmental Health (919-496-8100) between 8:00 - 9:00 a.m. Monday - Friday in order to schedule an appointment with and environmental Health Specialist for your lot evaluation. Please contact the Environmental Health Department at 919-496-8100 to determine the status of your application prior to visiting the Planning & Inspections Department to obtain a building permit.

IF THE INFORMATION IN THE APPLICATION FOR A SEPTIC PERMIT IS FALSIFIED, CHANGED, OR THE SITE IS ALTERED, THEN ANY RELATED PERMITS AND CONSTRUCTION AUTHORIZATIONS SHALL BECOME INVALID. This application is valid for one year from the date of application payment. The septic system approval (permit) is valid for five years from the date of Improvement Permit issuance, or without expiration by

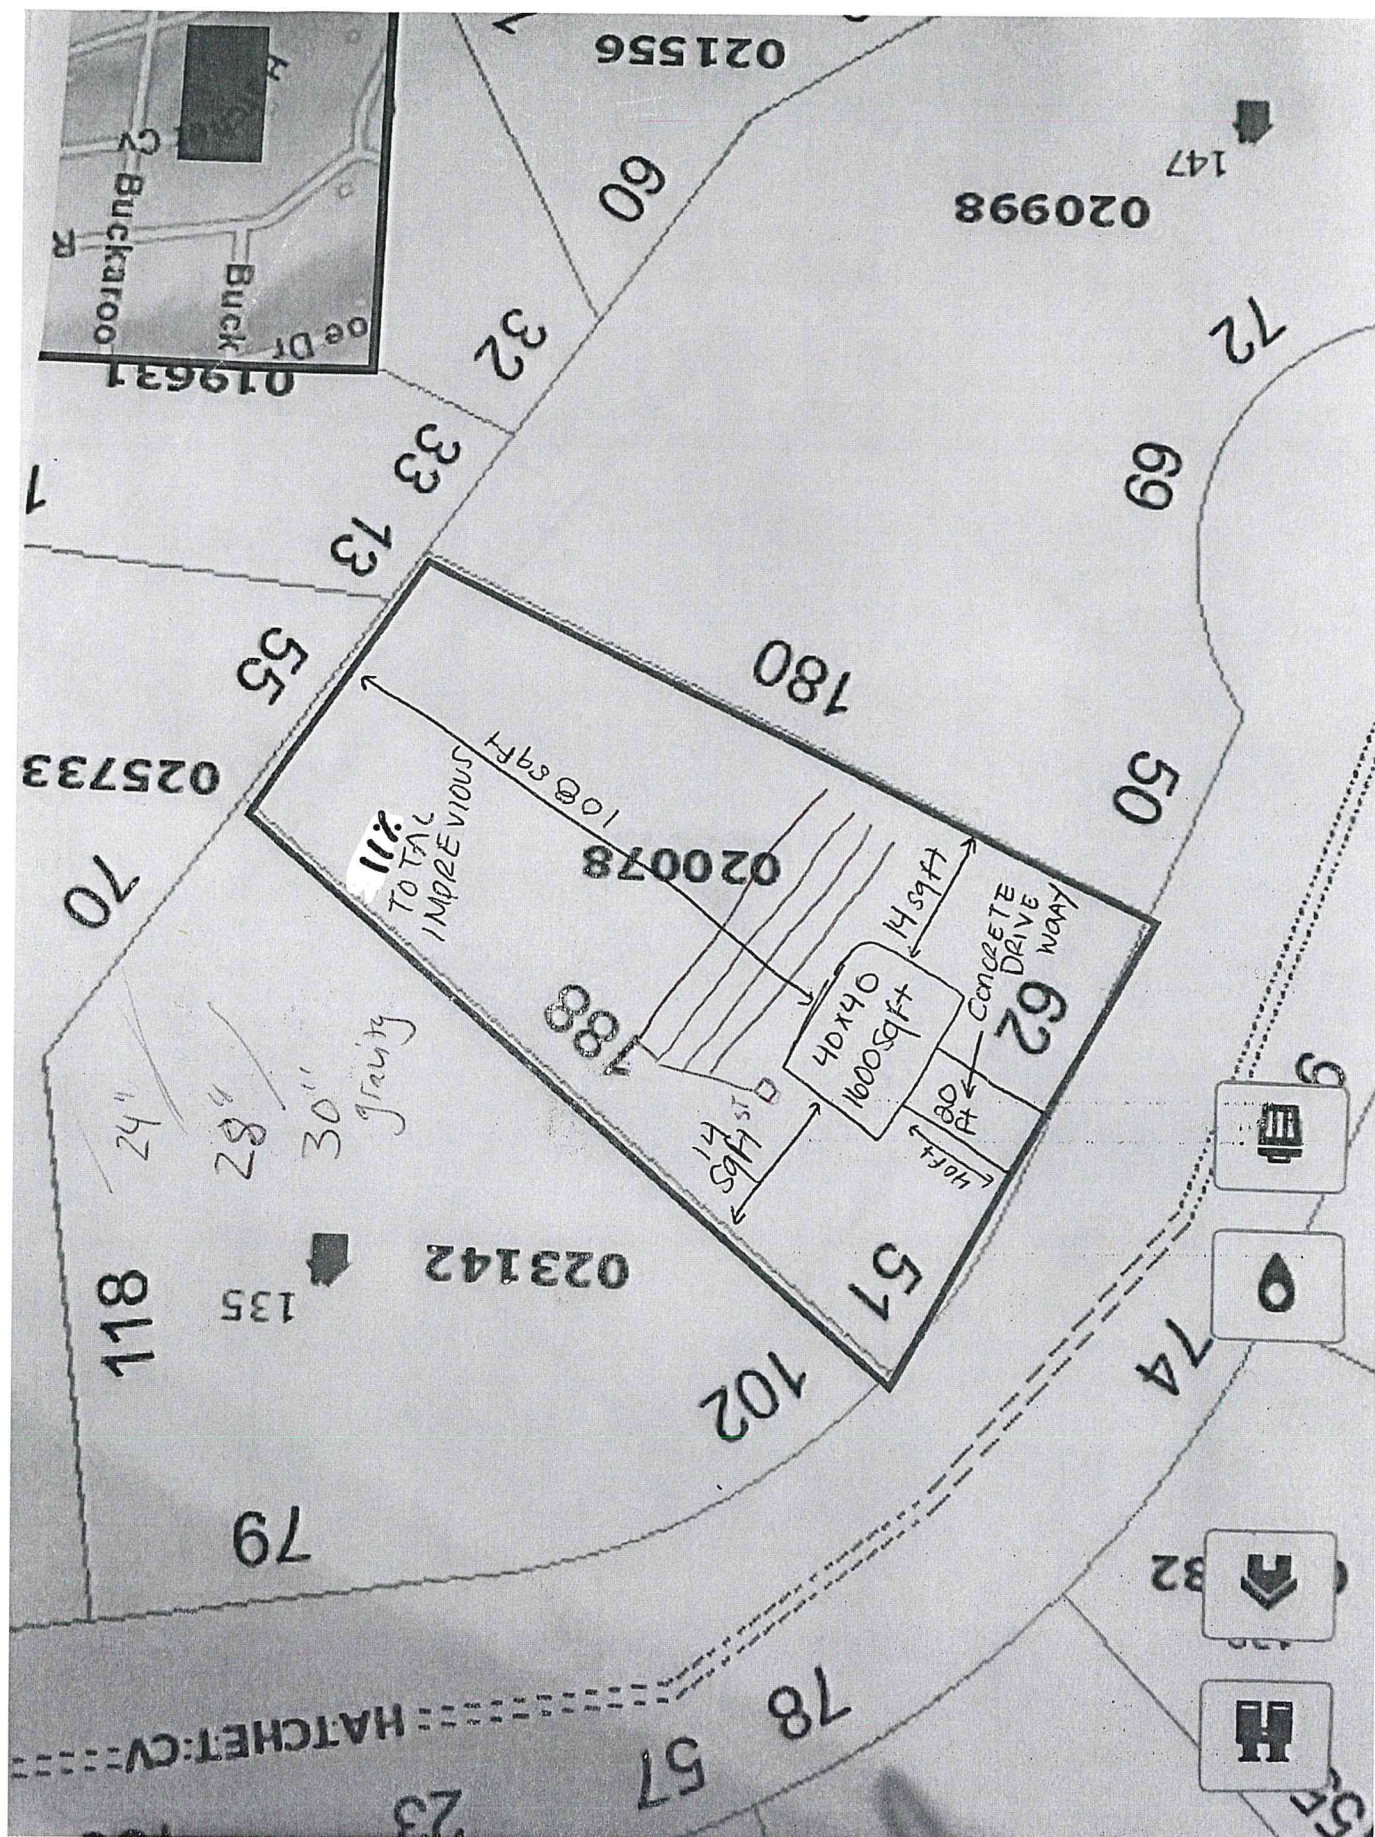



PIN#

139 Hatchet CV

Miguel Salazar

Environmental Health Septic/Well Permit Diagram

Environmental Health Septic/Well Permit Diagram
~~Building permits cannot be issued nor should construction begin without Construction Authorization issuance.~~
~~Septic Improvement Permit~~ ~~Septic Construction Authorization~~

Well Construction Authorization ☒ Add'l ☐ CA Reissue** ☐ As Built

Diagram Date**: 4-14-23 EHS: Joel bendel
 **Any previously dated CA diagram is revoked.

**Any previously dated CA diagram is revoked and/or invalid. Confirm this is the valid diagram for the site before beginning any construction.


Installation/grouting inspections may be scheduled the day before, or, the day of installation until 9am by contacting the Environmental Health office at 919 496 8100. A revisit fee may apply if installation is not ready for inspection at the time requested. Septic Operations Permits will be issued after installation is approved, all permits conditions are met, and any outstanding fees are paid. Well Certificate of Completion will be issued after well head approval, all permit conditions are met, and any outstanding fees are paid.

Septic Tank 1000 Pump Tank N/A Drainfield 3'x300' Type System ACC Max Trench Depth 28"

Septic Contractor _____ Type System 100 Max Trench Depth 2
Septic/Pump tank dates _____ Pump fee? NO YES pd _____
Well Contractor _____

Well Contractor _____ Well Grout date: _____

* Not to Scale

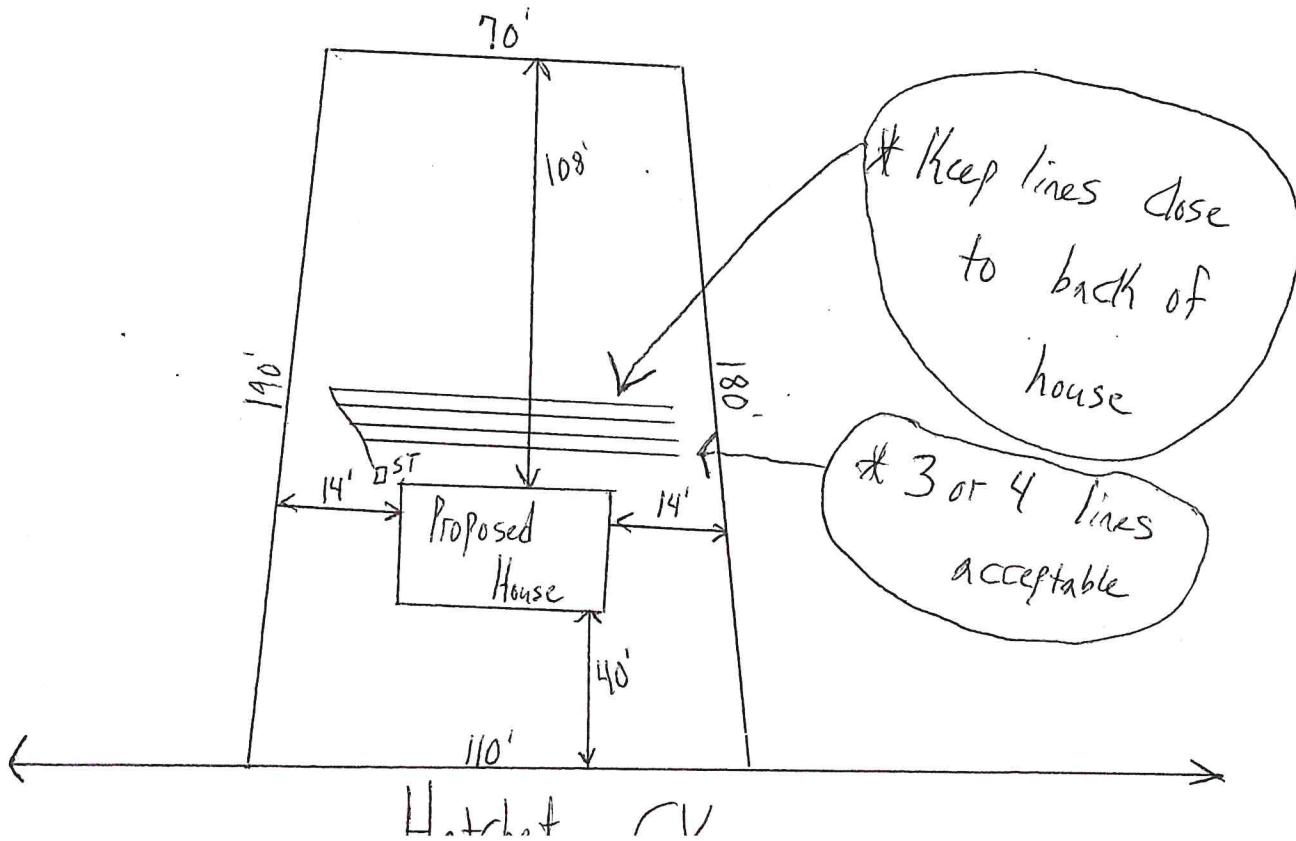

OWNER: Miguel Salazar 139 Hatchet CV APPLICATION DATE _____
ADDRESS: _____ DATE EVALUATED: _____
PROPOSED FACILITY: SFD PROPOSED DESIGN FLOW (.1949): 360 PROPERTY SIZE: _____
LOCATION OF SITE: _____ PROPERTY RECORDED: _____
WATER SUPPLY: ☐ Private ☒ Public ☐ Well ☐ Spring ☐ Other _____
EVALUATION METHOD: ☒ Auger Boring ☐ Pit ☐ Cut TYPE OF WASTEWATER: ☒ Sewage ☐ Industrial Process ☐ Mixed

over