

GRANVILLE-VANCE DISTRICT HEALTH DEPARTMENT
 IMPROVEMENT AND OPERATION PERMITS

COUNTY:	TAX NO.	TYPE OF ESTABLISHMENTS			*THIS PERMIT SHALL BE ACCOMPANIED BY A LAYOUT SHOWN ON A PLAT, INCLUDING SYSTEM REQUIREMENTS.
Granville	LOT SIZE	RESIDENCE ☒ BUSINESS ☐ OTHER ☐	NUMBER OF BEDROOMS: 3	NUMBER OF OCCUPANTS: 6 MAX	
APPLICANT'S NAME & ADDRESS Clayton Homes (Petway)		WATER SUPPLY WELL ☒ PUBLIC ☐	INITIAL INSTALLATION	REPAIR	*THIS IMPROVEMENT PERMIT IS SUBJECT TO REVOCATION IF THE INTENDED USE CHANGES FROM THOSE SHOWN ON THE IMPROVEMENT PERMIT. CHANGES SHALL REQUIRE HEALTH DEPARTMENT APPROVAL.
		TYPE OF WASTEWATER SYSTEM	III g	III g/bg	
PROPERTY ADDRESS/LOCATION: 4033 Salem Rd		DESIGN FLOW:	312 gpd		
		LTAR:	.25 gpd/Ft ²		
SUBDIVISION:		ABSORPTION AREA:	1,080 Ft ²		
		TRENCH WIDTH	36"		
LOT NUMBER:		TRENCH DEPTH:	18"		
		TRENCH SPACING:	9' o.c.		
REFERENCE SKETCH (SEE PLAT FOR DETAILS)		TOTAL TRENCH LENGTH:	360'		
		NUMBER OF TRENCHES:	3		
* Risers on tank * House should sit 50' off left property line.		GRAVEL / ACCEPTED:	Accepted		PERMIT VALID FOR: 5 YEARS YES ☒ NO
		TANK SIZE:	1000 gal		
		PUMP TANK SIZE:	N/A		NO EXPIRATION YES ☐ NO ☒
		DISTRIBUTION DEVICE:	D-BOX		

IMPROVEMENT PERMIT

DATE: 7-5-19

FOR: Clayton Homes

ISSUED BY: Adam Cronin

CONSTRUCTION AUTHORIZATION FOR IMPROVEMENT PERMIT# 1409

Unless otherwise indicated, the same conditions above apply regarding system type, layout, location and installation requirement.

(The wastewater system cannot be installed until authorization is signed)

Comments:

Date: 7-5-19

Environmental Health Specialist:

 Construction Authorization Addendum ☒ Yes ☐ No

OPERATION PERMIT

DATE: 4-23-2021

SYSTEM INSTALLED BY:


Rick Kegly

ISSUED BY:

Adam Cronin

PERFORMANCE, MONITORING, MAINTENANCE AND OPERATION

AS REQUIRED BY R.U.F. 1961

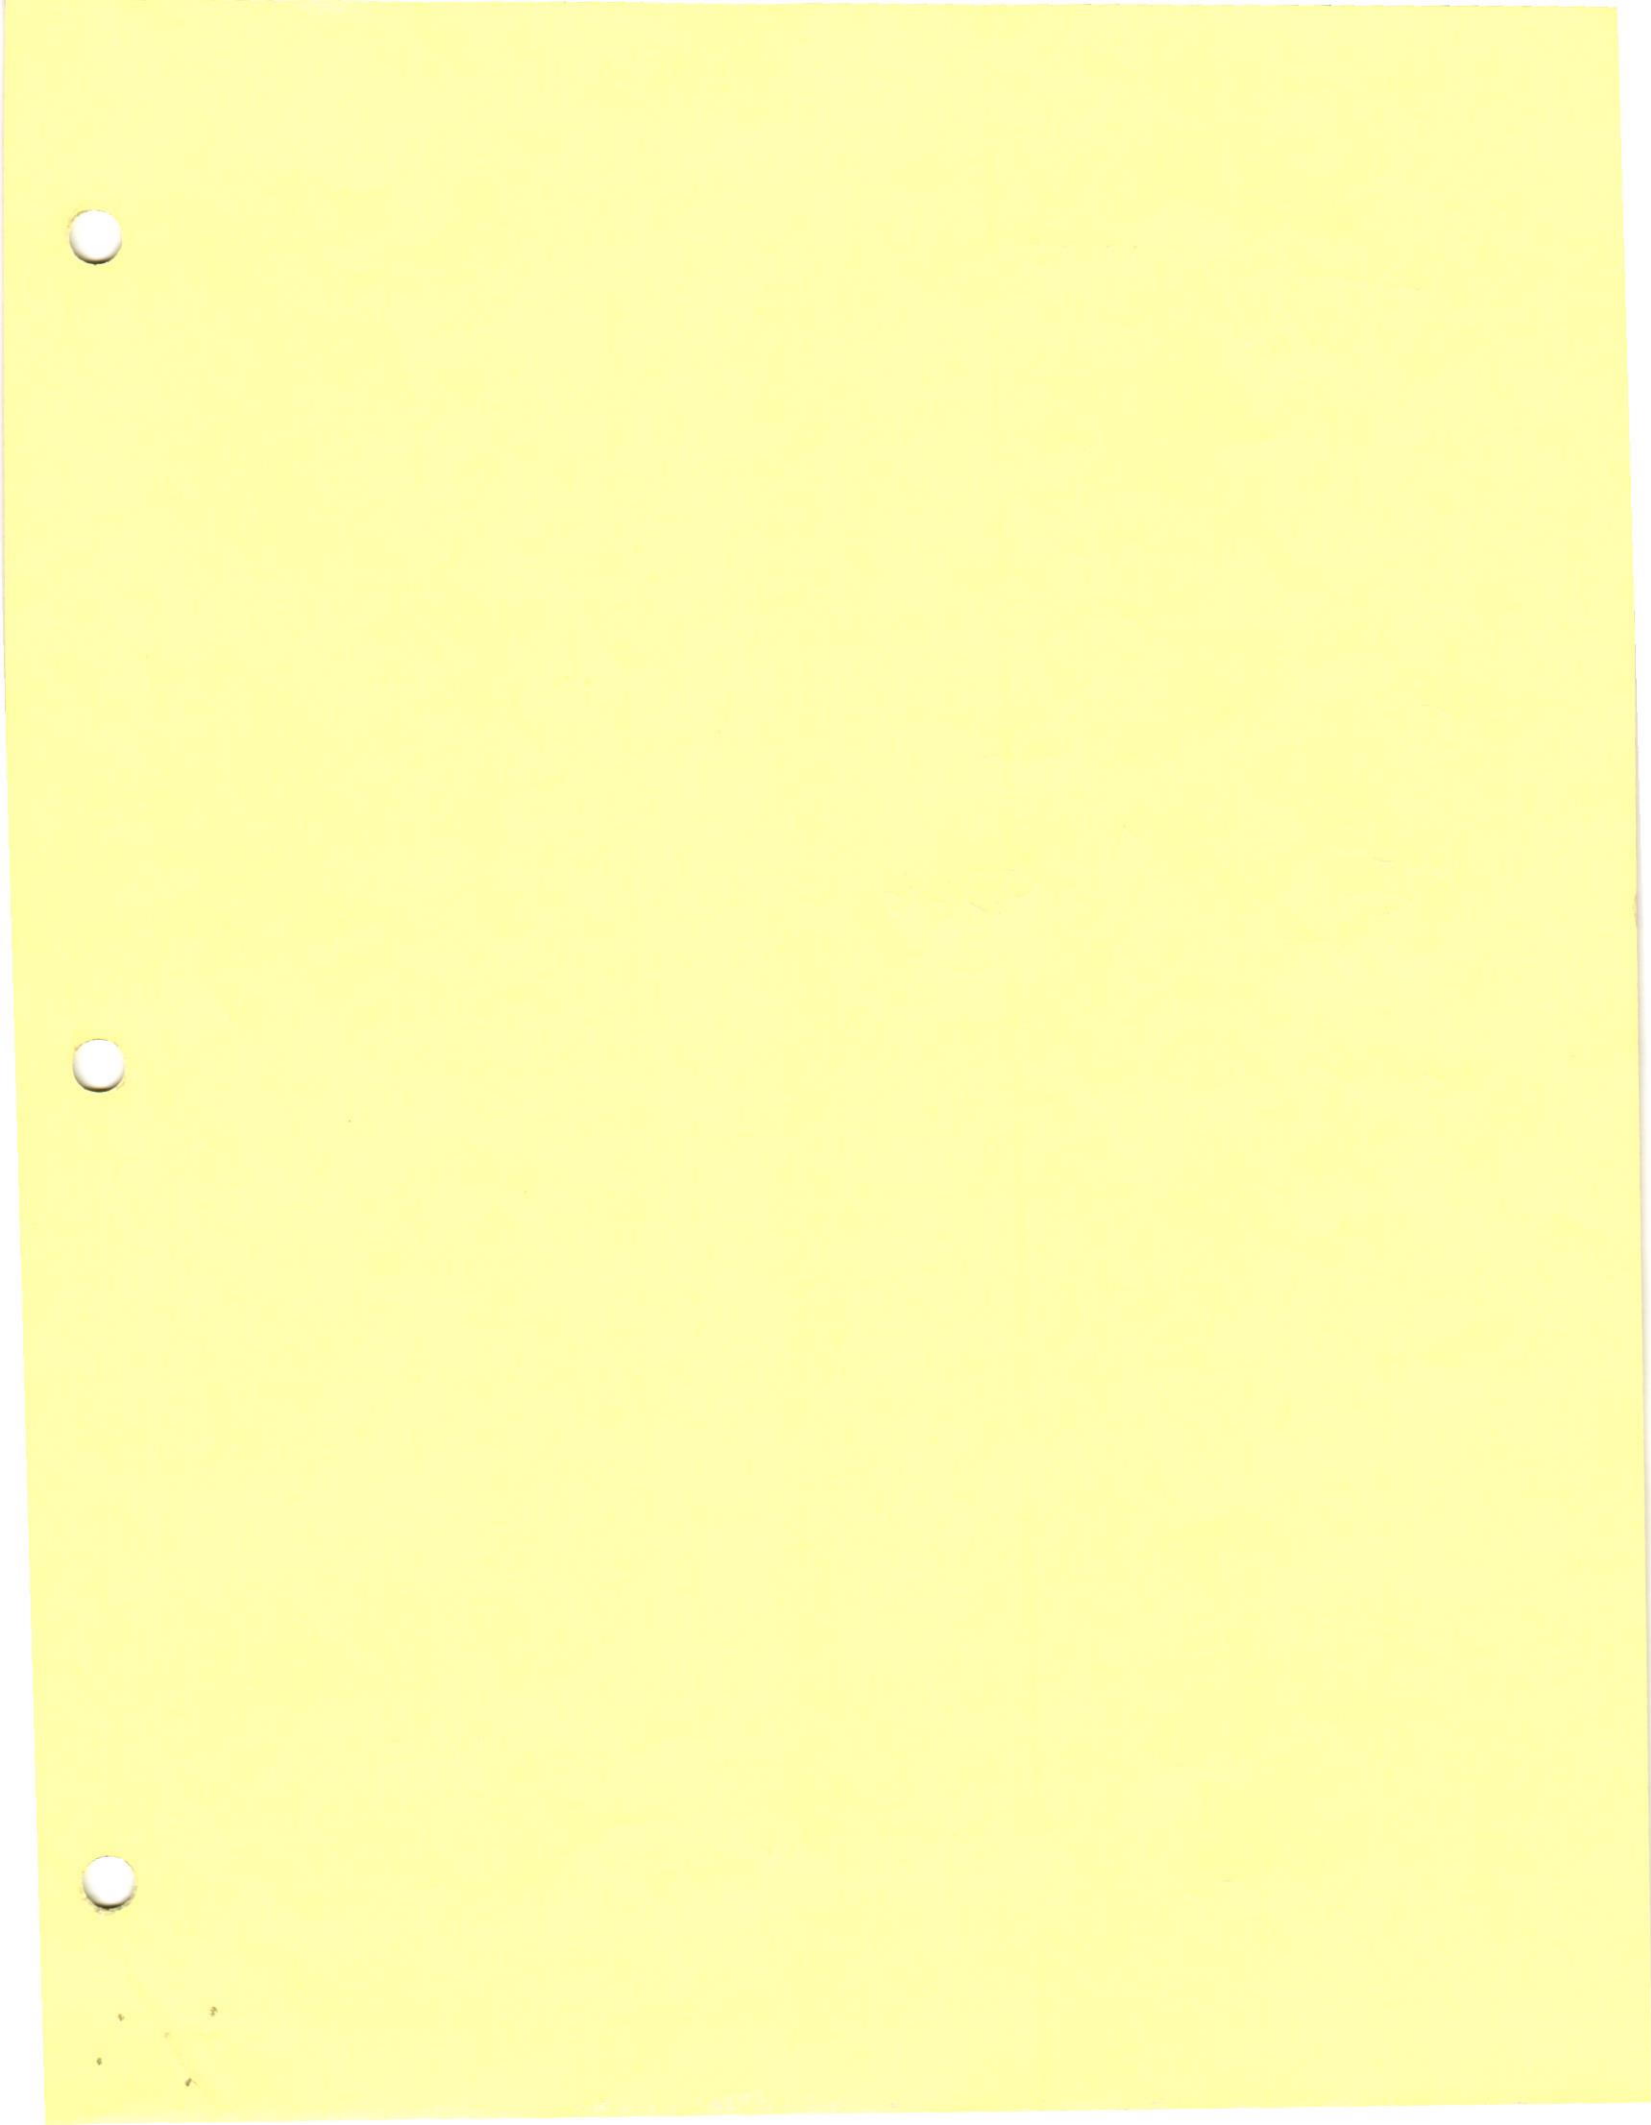

Granville - Vance District Health Department

Environmental Health

3002

Well Construction Permit

Owner/Applicant: Clayton HomesDate: 7-5-19Address or Location of Property: 4033 Salem Rd

Subdivision & Lot #: _____

Septic Permit #: 1409Zoning Permit #: 21179Environmental Health Specialist: AWC

This well permit is to locate and site the area that a private groundwater well may be established on the property listed above by the Environmental Health Specialists of Granville County. If one does not locate the well in the approved area and complete the well as specified by the 15A NCAC .02C rules, then permits may be revoked. At completion of drilling of the well, grout must be witnessed by EHS and a well log turned into Environmental Health.


Minimum Setbacks: (these are the main setbacks, but not all required setbacks)

Setback from property lines – 10 ft

Setback from septic tank and drain field, including repair area – 100 ft

Setback from structural foundations – 25 ft

Setback from ponds, lakes or other bodies of water – 50 ft

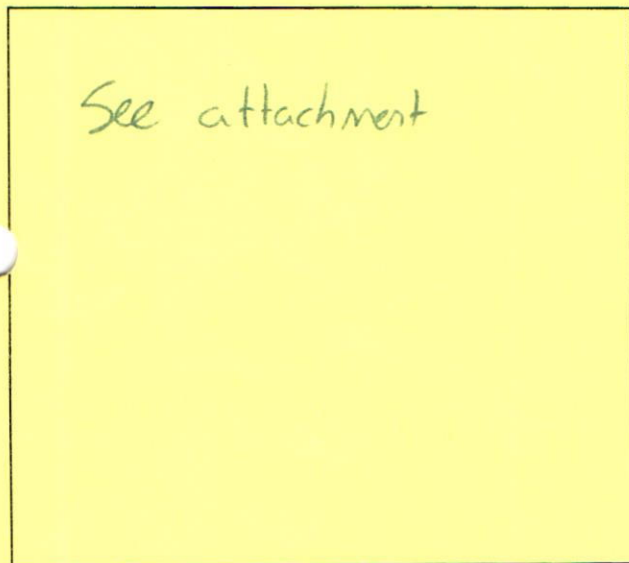
Site Sketch:**Conditions:** __________

_____Authorized Agent: Debra Curran

Date: _____

1 Well Grout: (Circle or write in)Witnessed: Yes or No EHS Agent: Ch. HallDate: 5/3/21 Annular Space Open: Yes or NoOver reamed: Yes or No Depth Grouted: 20'Method: _____ Pump ✓ Poured _____ Pressure

Well Log received: Yes or No (EHS to Attach to Permit)

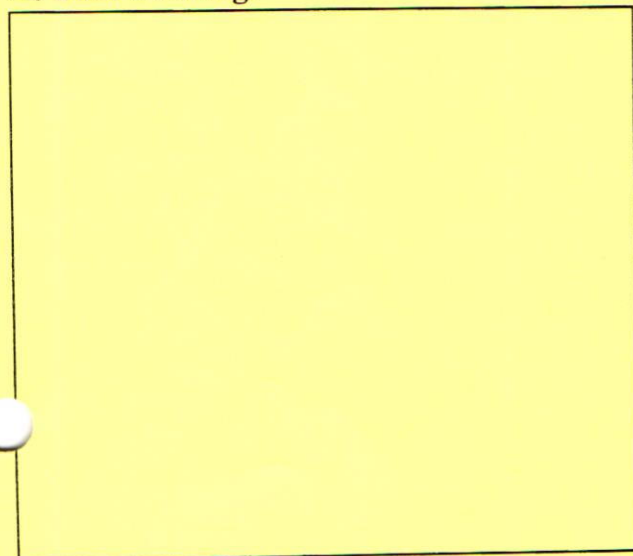Driller Name: Southern Well Cert. # _____Depth: 240 Casing Depth: 63 GPM: 5**As Built Drawing:****# 2 Well Final: (Place a check mark when finalized)**Seal Present and Intact: ✓ Air Vent: ✓Hose Spigot: ✓ Electrical Box: ✓Pump Installer Tag: ✓ Well Installer Tag: ✓All holes sealed: ✓ 12" above grade: ✓**Comments:** __________

_____**# 3 Well Completion Permit:** [Signature] EHSDate Completed: 5-6-21**# 4 Water Samples Taken: Date:** _____

EHS: _____ Results: _____

Retest: _____ Results: _____

SEWAGE DISPOSAL SYSTEM INSTALLATION REVIEW

SEPTIC AND PUMP TANK INSPECTION

SEPTIC TANK

Manufacturer Ellis
 Date of Manufacture 2-15-2021
 Stamp STB-789
 Capacity 1000
 Tee ✓ Gray Polylock Filter (Label A1800)
 Baffle ✓
 Sealant ✓
 AIR GAP —, FILTER —, RISER 6"

INITIAL

awc

DATE

4-23-2021

PUMP TANK

Manufacture _____
 Date of Manufacture _____
 Stamp _____
 Capacity _____
 Sealant _____
 Manhole _____
 RISER _____, SEALANT _____

MECHANICAL INSPECTION

PUMP

Manufacturer and Model # _____
 Control Panel _____
 Alarm _____
 Electrical Connection _____
 SEALANT AROUND CONDUIT _____

NITRIFICATION/DISTRIBUTION AND DRAINFIELD INSPECTION

DISTRIBUTION BOX

Level No Speed Leveler
 Equal Distribution _____
 Other Serial

awc

awc

DISTRIBUTION MANIFOLD

Pipe Size _____
 Gate Valves _____
 Other _____

OTHER DISTRIBUTION

Type Serial

NITRIFICATION LINES

Trench Width _____
 Trench Length _____
 Trench Grade _____
 Stone Depth _____

LINE 1

3'
70'
✓
—

LINE 2

3'
90'
✓
—

LINE 3

3'
100'
✓
—

LINE 4

3'
100'
✓
—

LINE 5

LINE 6

EZ-Flow

WELL INSPECTION

LOCATION OF WELL

N-G-EZ1203H-GEO

COMMENTS:

Granville - Vance District Health Department
Environmental Health

Pin _____

Permit Number 1409

Final Sketch

Clayton Homes (now Oakwood)
Applicants Name


Subdivision - Section - Lot

Physical Address: 4033 Salem Road

Number of Bedrooms 3

Rick Kegly
System Installer

4-23-2021
Date

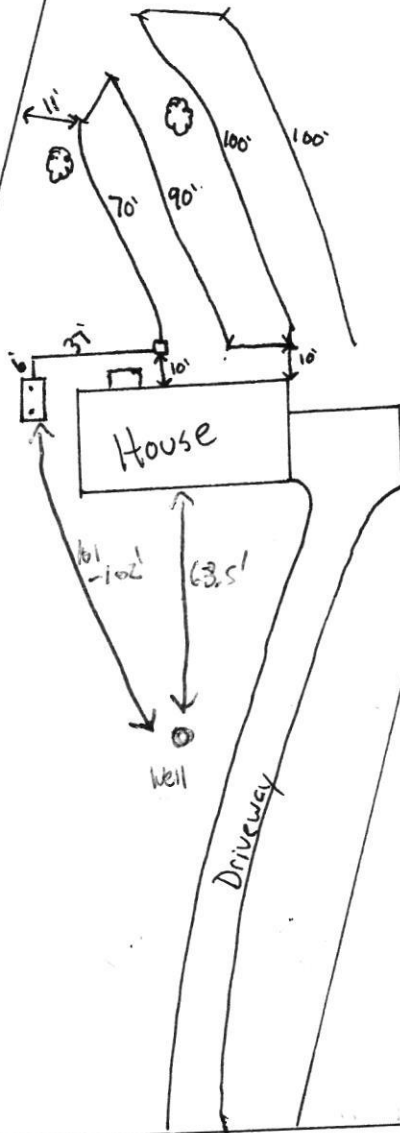

Salem Road

Adam Corn
Authorized Signature

4-23-2021
Date