


FRANKLIN COUNTY HEALTH DEPARTMENT

PERMIT NUMBER: 70031 IMPROVEMENTS PERMIT	DATE: 07.10.95	ELEC4524	SIZE: 1.80A
APPLICANT: NORTHERN PAUL E & HELEN RT 2 BOX 63P YOUNGSVILLE NC 27596 TELEPHONE: 872-0211		OWNER: NORTHERN PAUL E & HELEN RT 2 BOX 63P YOUNGSVILLE NC 27596	
COMMENT: MOBILE HOME		CONTRACTOR:	
LOCATION / DIRECTIONS: NORTH RALEIGH FARMS #265			
FEE: 50.00 10763		SIGNATURE OF OWNER OR AUTHORIZED AGENT:	
THE ABOVE SIGNATURE INDICATES THAT I HAVE READ, UNDERSTAND, AND AGREE WITH ALL PROVISIONS AND INFORMATION AS OUTLINED ON THE BACK SIDE OF THIS FORM			

#BEDRMS 3 DISPOSAL _____ OTHER _____ TYPE. SYS C
 SZ. TANK 900 SZ. CHAMB _____ NITRIFI 2500 OPER. REQ 2
 SITE. LOC -

REMARKS: _____

*Original Permit # Paul Northern 9288902
 Coc Mr Peoples - 10/89
 Con Davis*

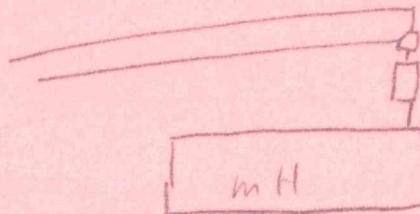

DATE. ISSUED _____

EH SPECIALIST _____

DATE. APPROVED 1/19/95

EH SPECIALIST 