


NOTE: Make sketch of installation showing location of house, septic tanks, privies, water supplies on adjacent property, etc. Write in measurements in order that installation may be located at later date.

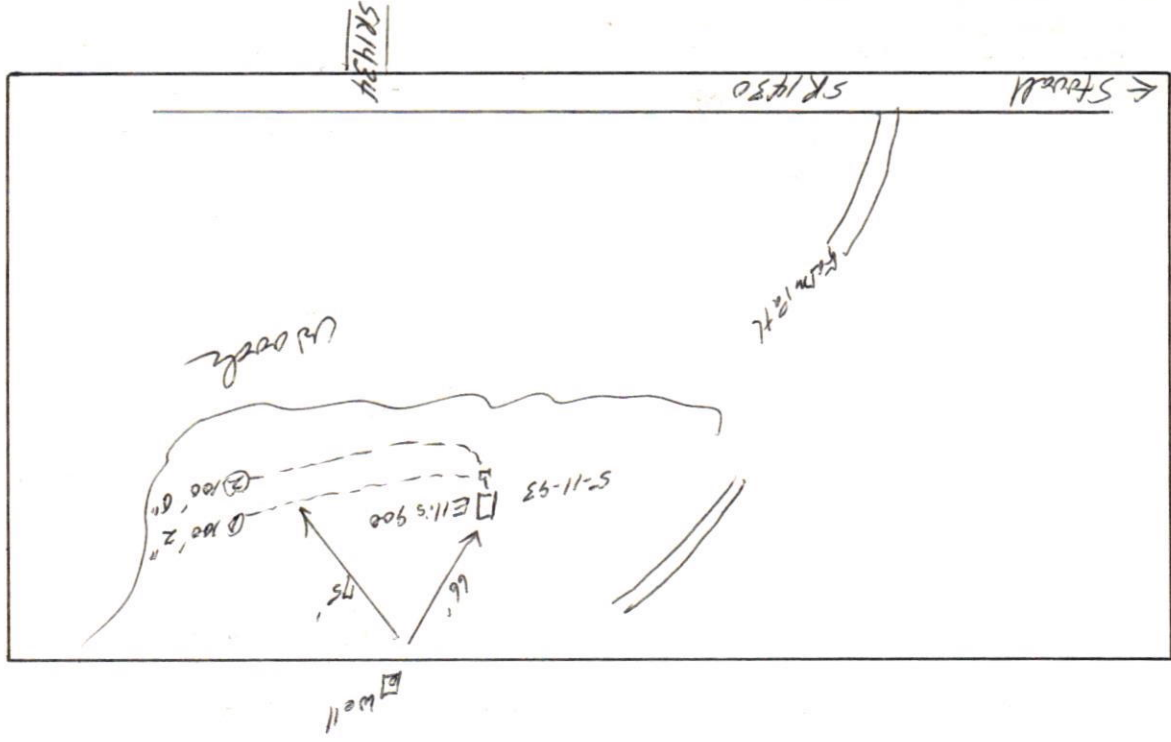

GRANVILLE-VANCE HEALTH DEPARTMENT—Sewage Disposal Record

284
 Owner or Contractor Thomas C. Cook Date 6-15-93 S.R. No. 1430
 Location/Address 3611 Channing Rd - Oxford, NC
 Subdivision/Mobile Home Park Name _____ Lot Size Farm
 Permit No. # _____ Lot No. _____

New System ☒ Repair _____
 House _____ Mobile Home ☒ Business _____
 No. Bedrooms 2 No. People 1 No. Toilets _____
 Water Supply: Private ☒ Approved _____
 Semi-Public _____ Unapproved _____
 Public _____ None _____

Nitrification System:

Tank Size 900 gal.
 Distribution Box 4a No. Lines 2
 Nitrification Field 200' - 600' Sq. Ft.
 Lines: 1 2 3 4 5 6
 Width 3' 3' _____
 Length 100' 100' _____
 Grade 2" 0" _____
 Stone Depth 12" 12" _____

Layout to be followed by installer:

Improvements Permit By Charles R. Noblin Installer Wm. Hight
 Certificate of Completion By Charles R. Noblin Date of Inspection 6-16-93

* Construction must comply with all other applicable state and local regulations, but the permit is not a guarantee that the system will not malfunction and the Granville-Vance Health District will not be held responsible for a malfunctioning system.